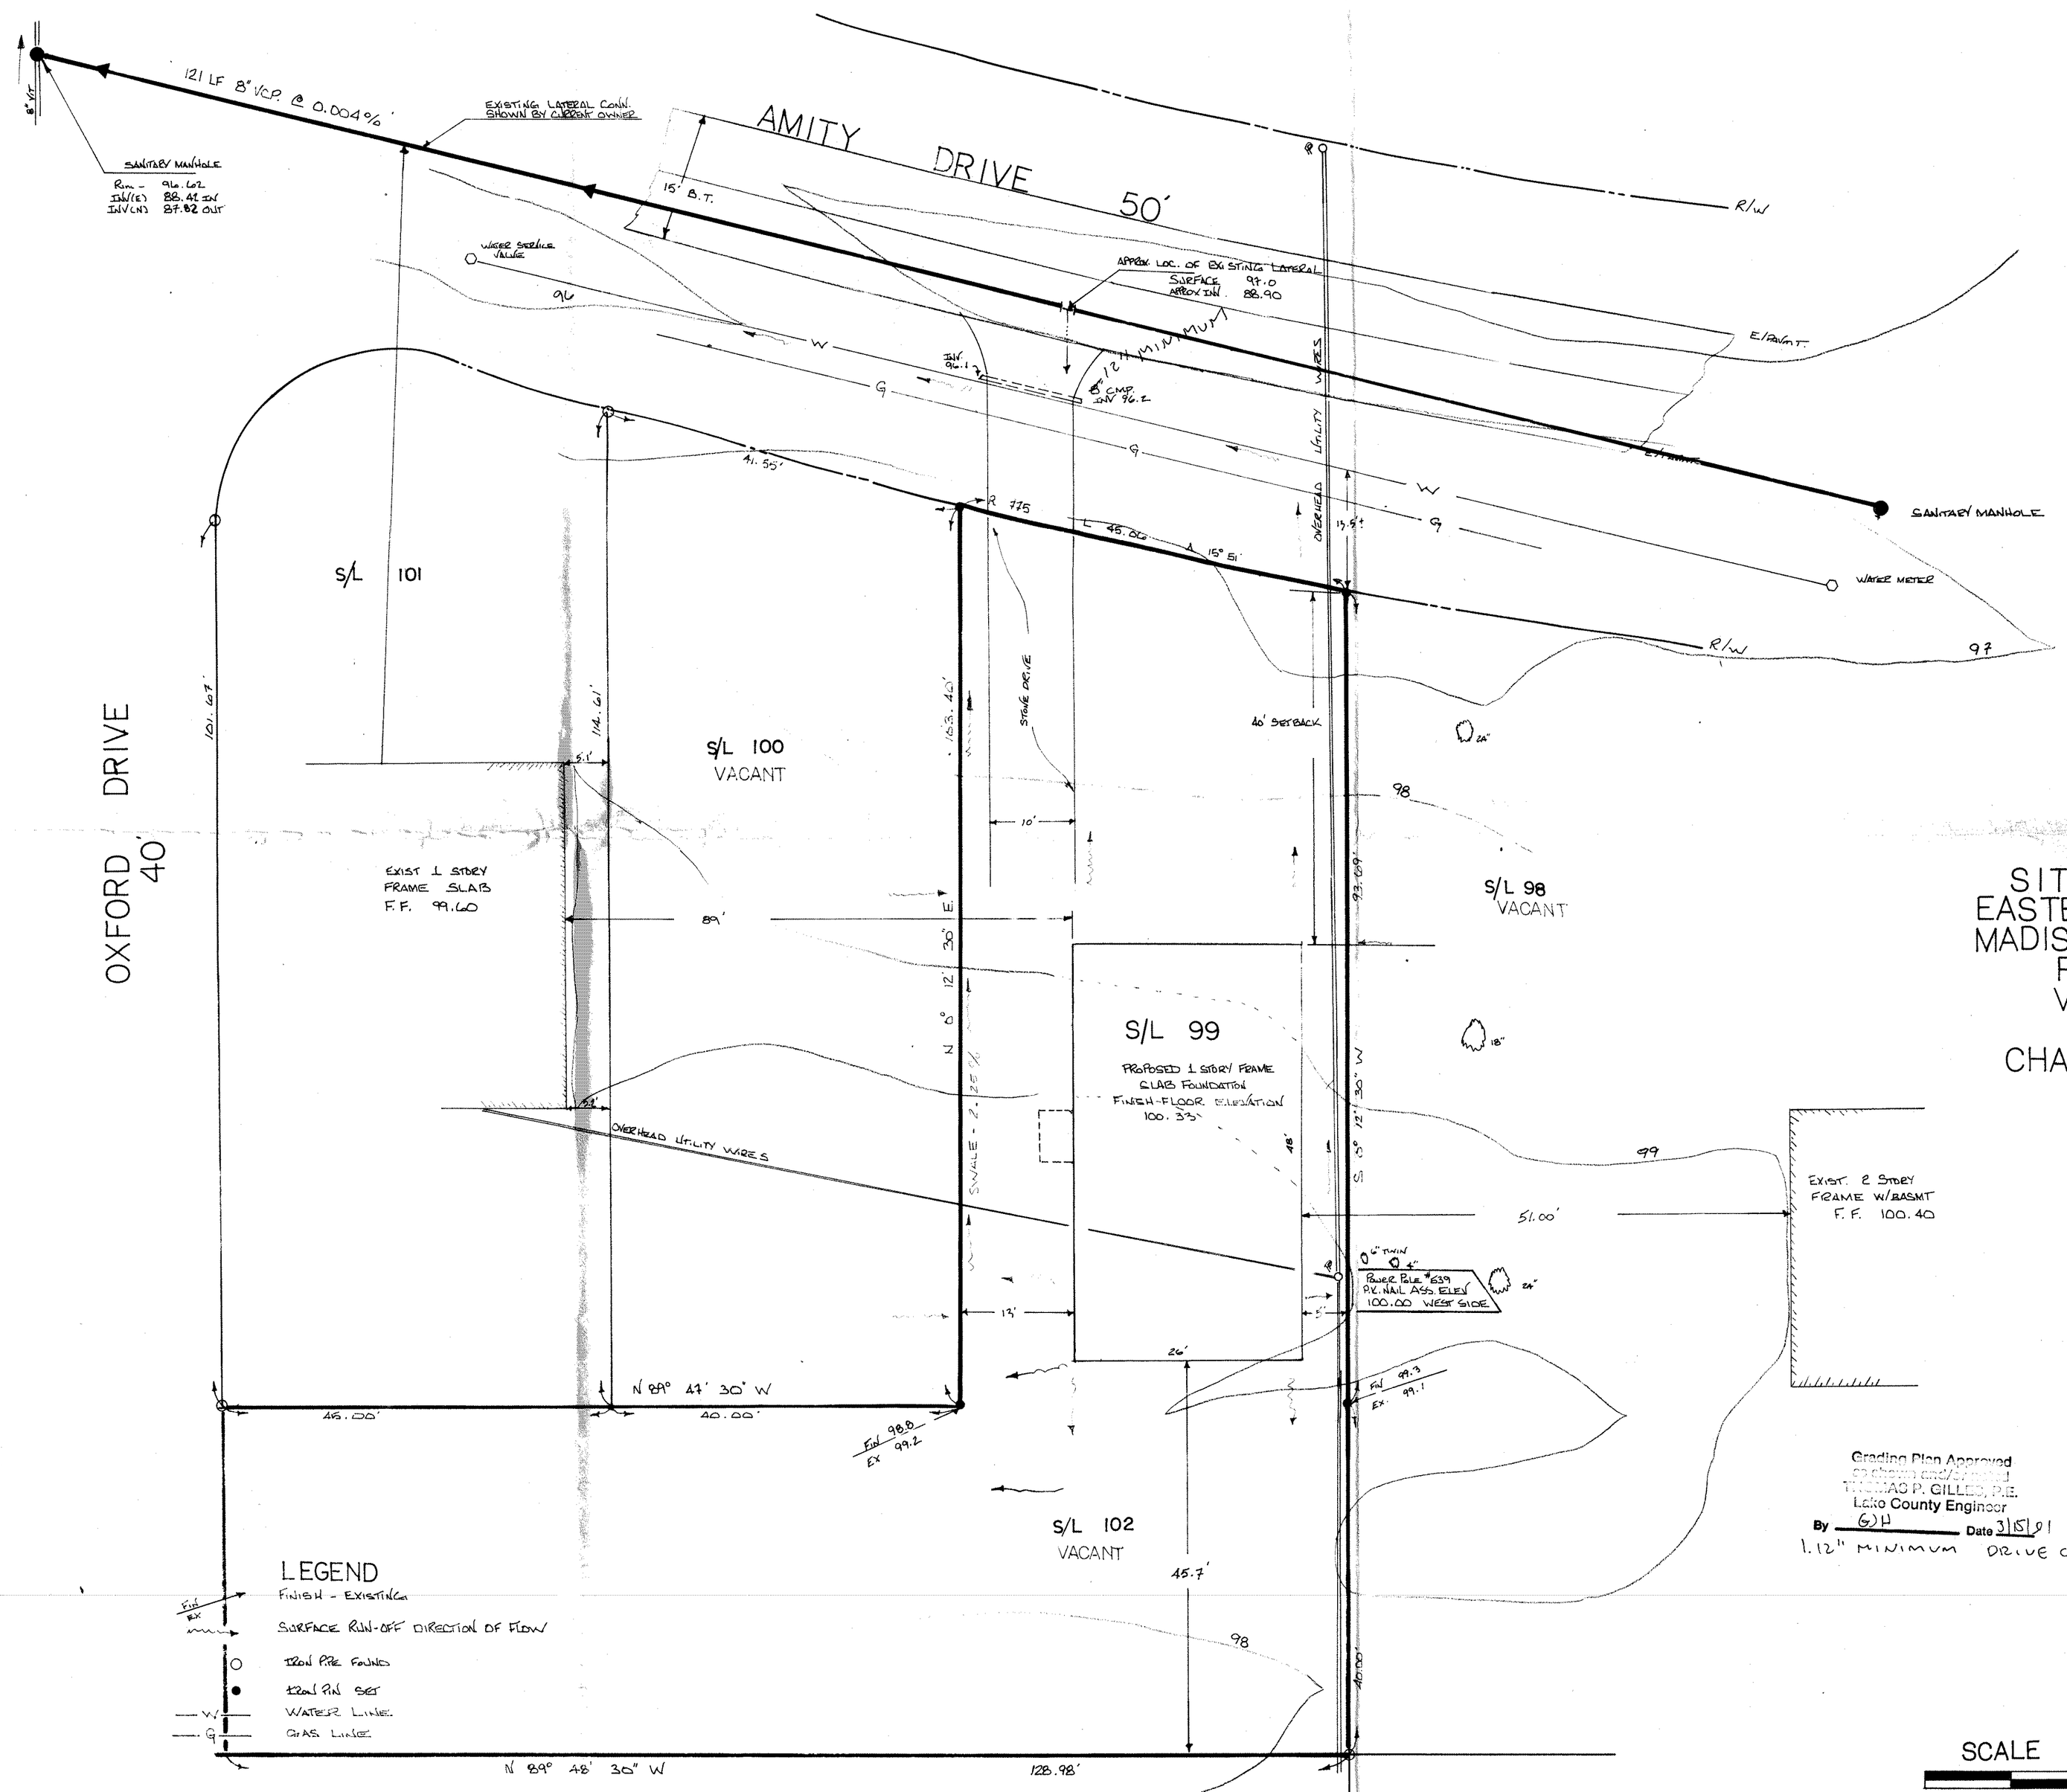

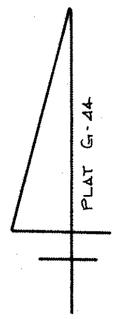

SITE PLAN FOR SUIBLOT 99 IN THE EASTERLY LOT TRACT 2 OF MADISON BEACH ESTATES MADISON TOWNSHIP LAKE COUNTY STATE OF OHIO

PLAT G44 TAX MAP 102 D
VOL. I PG. 79 FOR

CHARLES MACE

Grading Plan Approved
as shown and/or noted
THOMAS P. GILLES, P.E.
Lake County Engineer
By GH Date 3/15/91
1.12" MINIMUM DRIVE CULVERT.

APPROVED
MADISON TWP. ZONING
Permit: 12054
Zoning Inspector: [illegible]
MAR. 18 1991

SCALE 1" 10'

REVISED	
NO	DATE
	3-11-91
1	MOVED 5' SOUTH

TIMOTHY E. STOCKER
34 WEST WASHINGTON ST.
PAINESVILLE, OHIO 44077

TIMOTHY E. STOCKER
Timothy E. Stocker
OHIO PROFESSIONAL SURVEYOR 7245