BENCH MARK
TOP CENTER HYD.
CORNER BENNETT & ROE
ELEV. 600.32'

SITE PLAN
FOR
DAVE WELCH

LOTS 140, 142 & 144
MADISON BEACH ESTATES
PLAT G PG 44
ELY LOT TRACT 2
MADISON TWP
LAKE CO.

NOV. 11, 1989

SCALE 1" = 15 ft

601.22 existing elev.
602.35 proposed elev.

- - - - - existing contour
——— proposed contour

JIM PETER
LAND SURVEY
4759 CROSBY-COOK
ROME, O 44085

STATE OF OHIO
JAMES M. PETER 6420
REGISTERED SURVEYOR

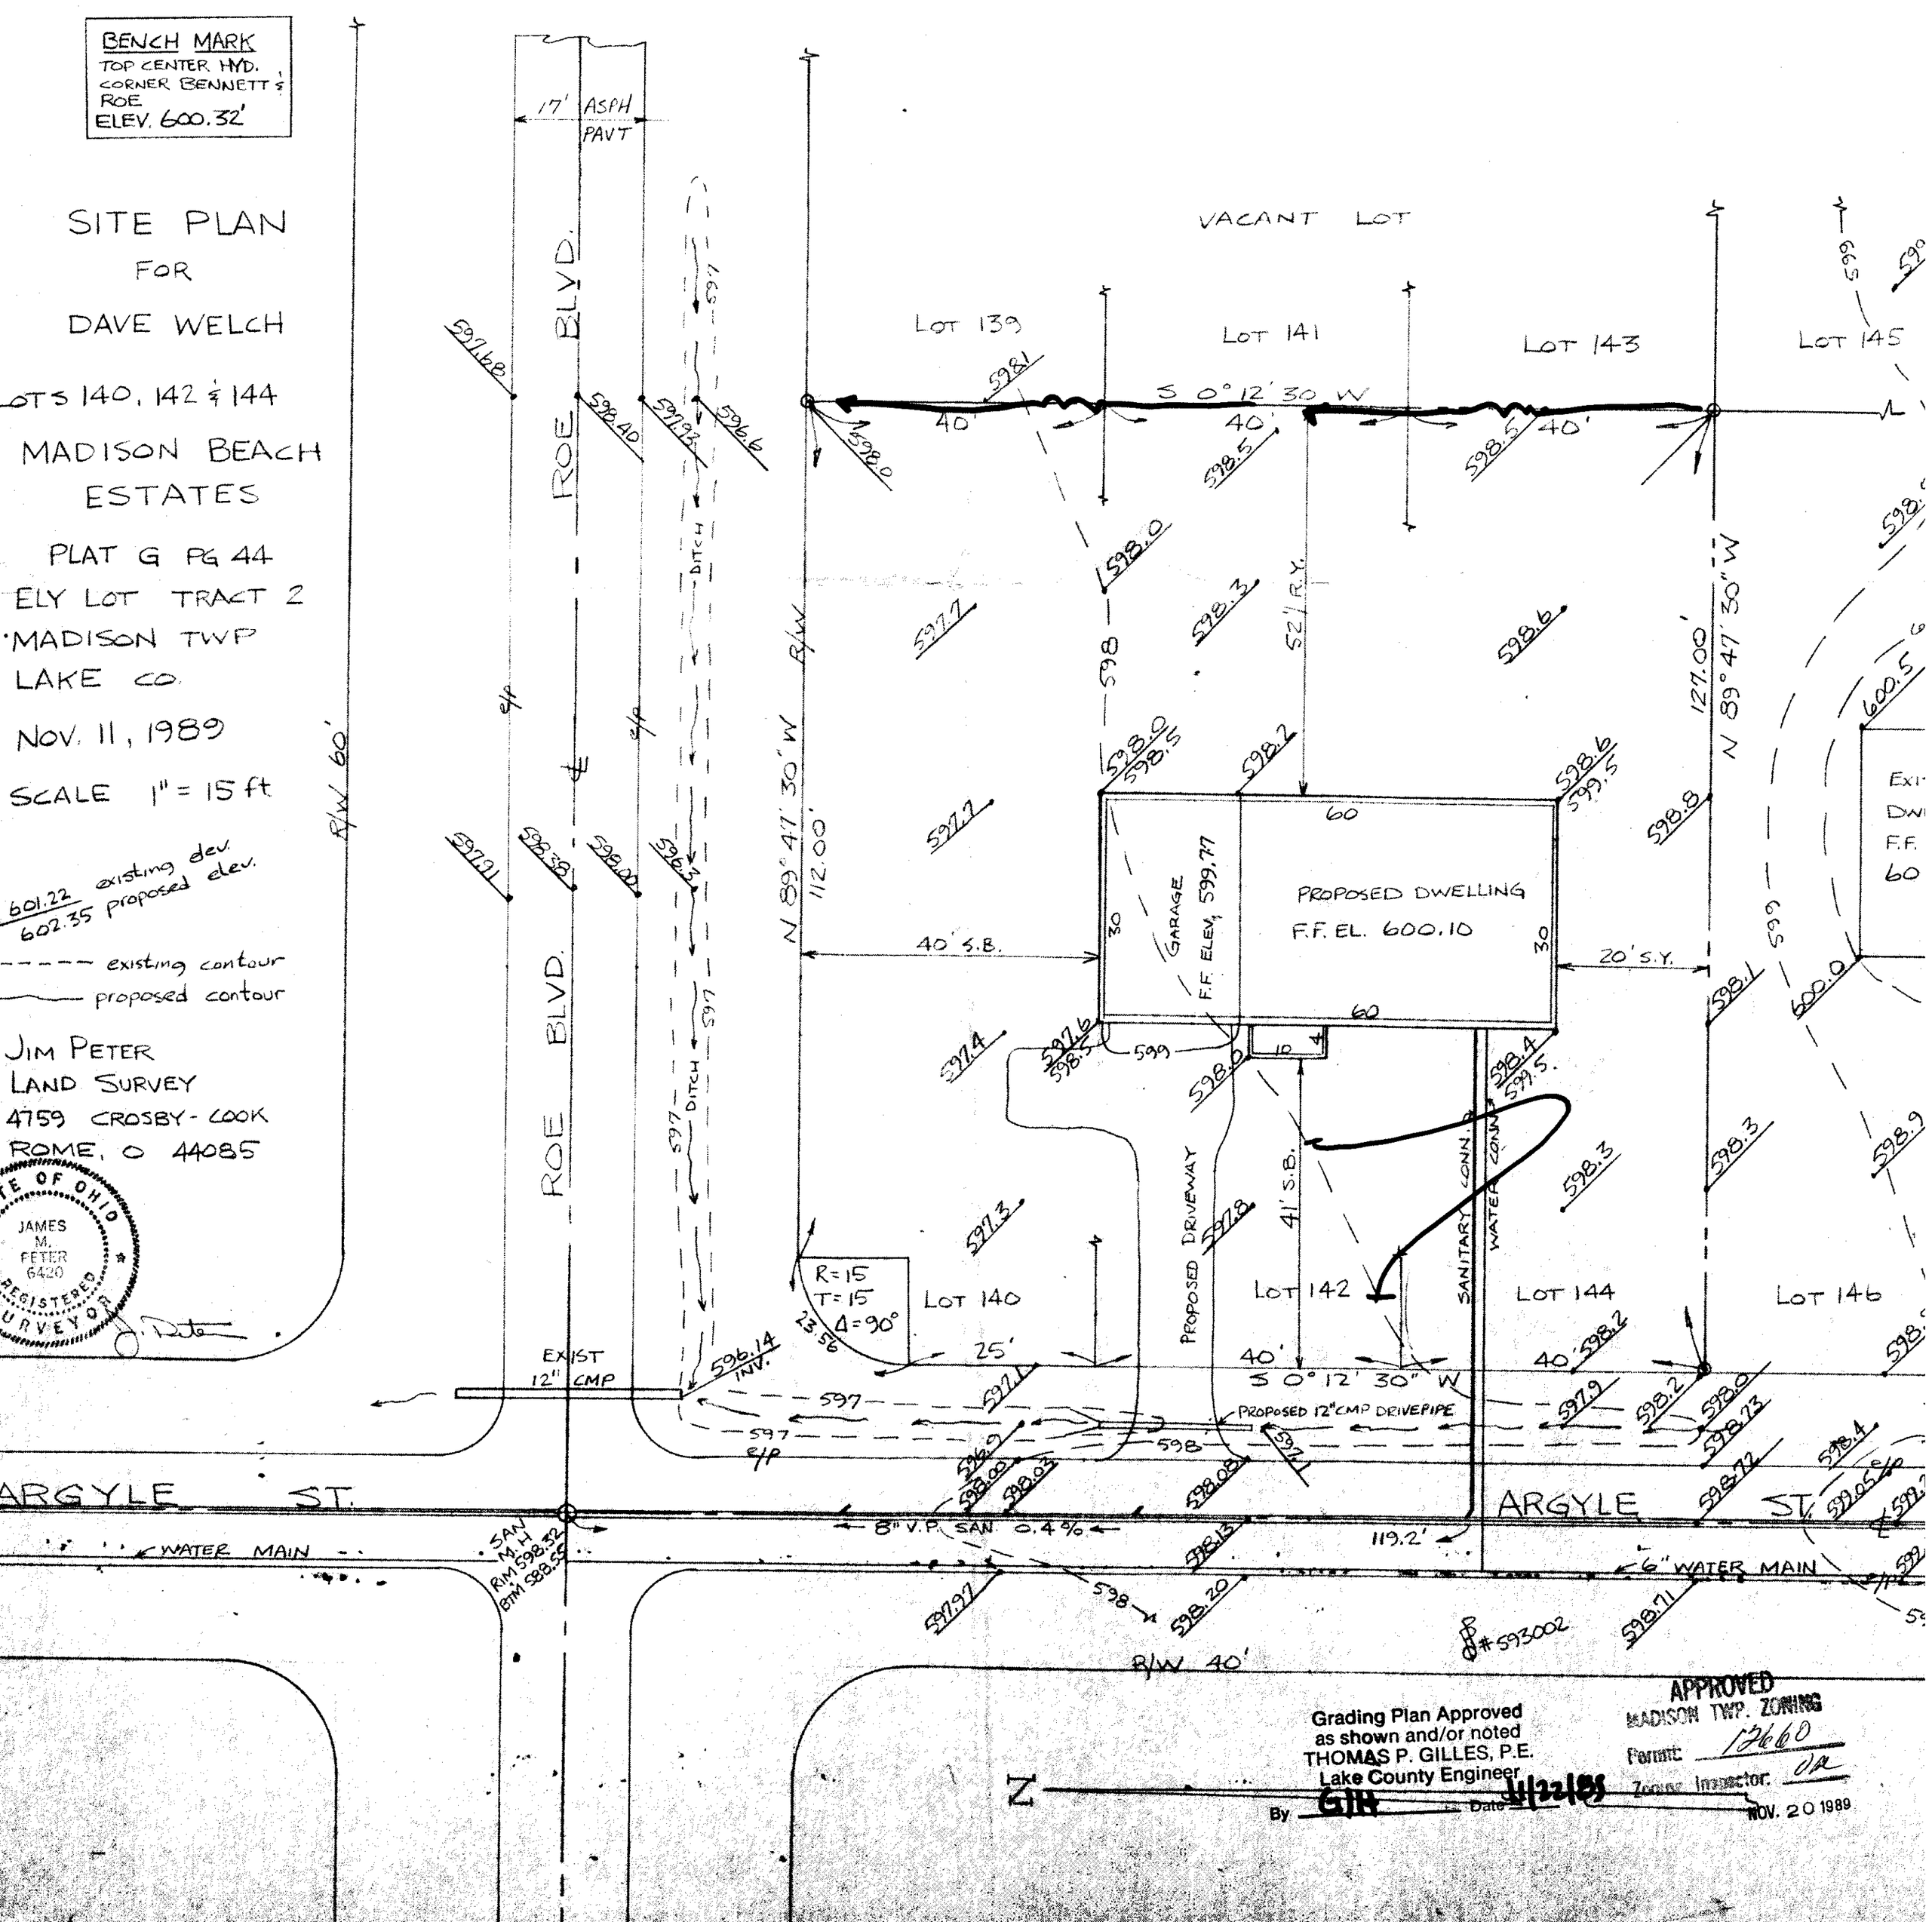

Grading Plan Approved
as shown and/or noted
THOMAS P. GILLES, P.E.
Lake County Engineer
By GJH Date 11/22/89

APPROVED
MADISON TWP. ZONING
Permit: 12660
Zoning Inspector: DA
NOV. 20 1989