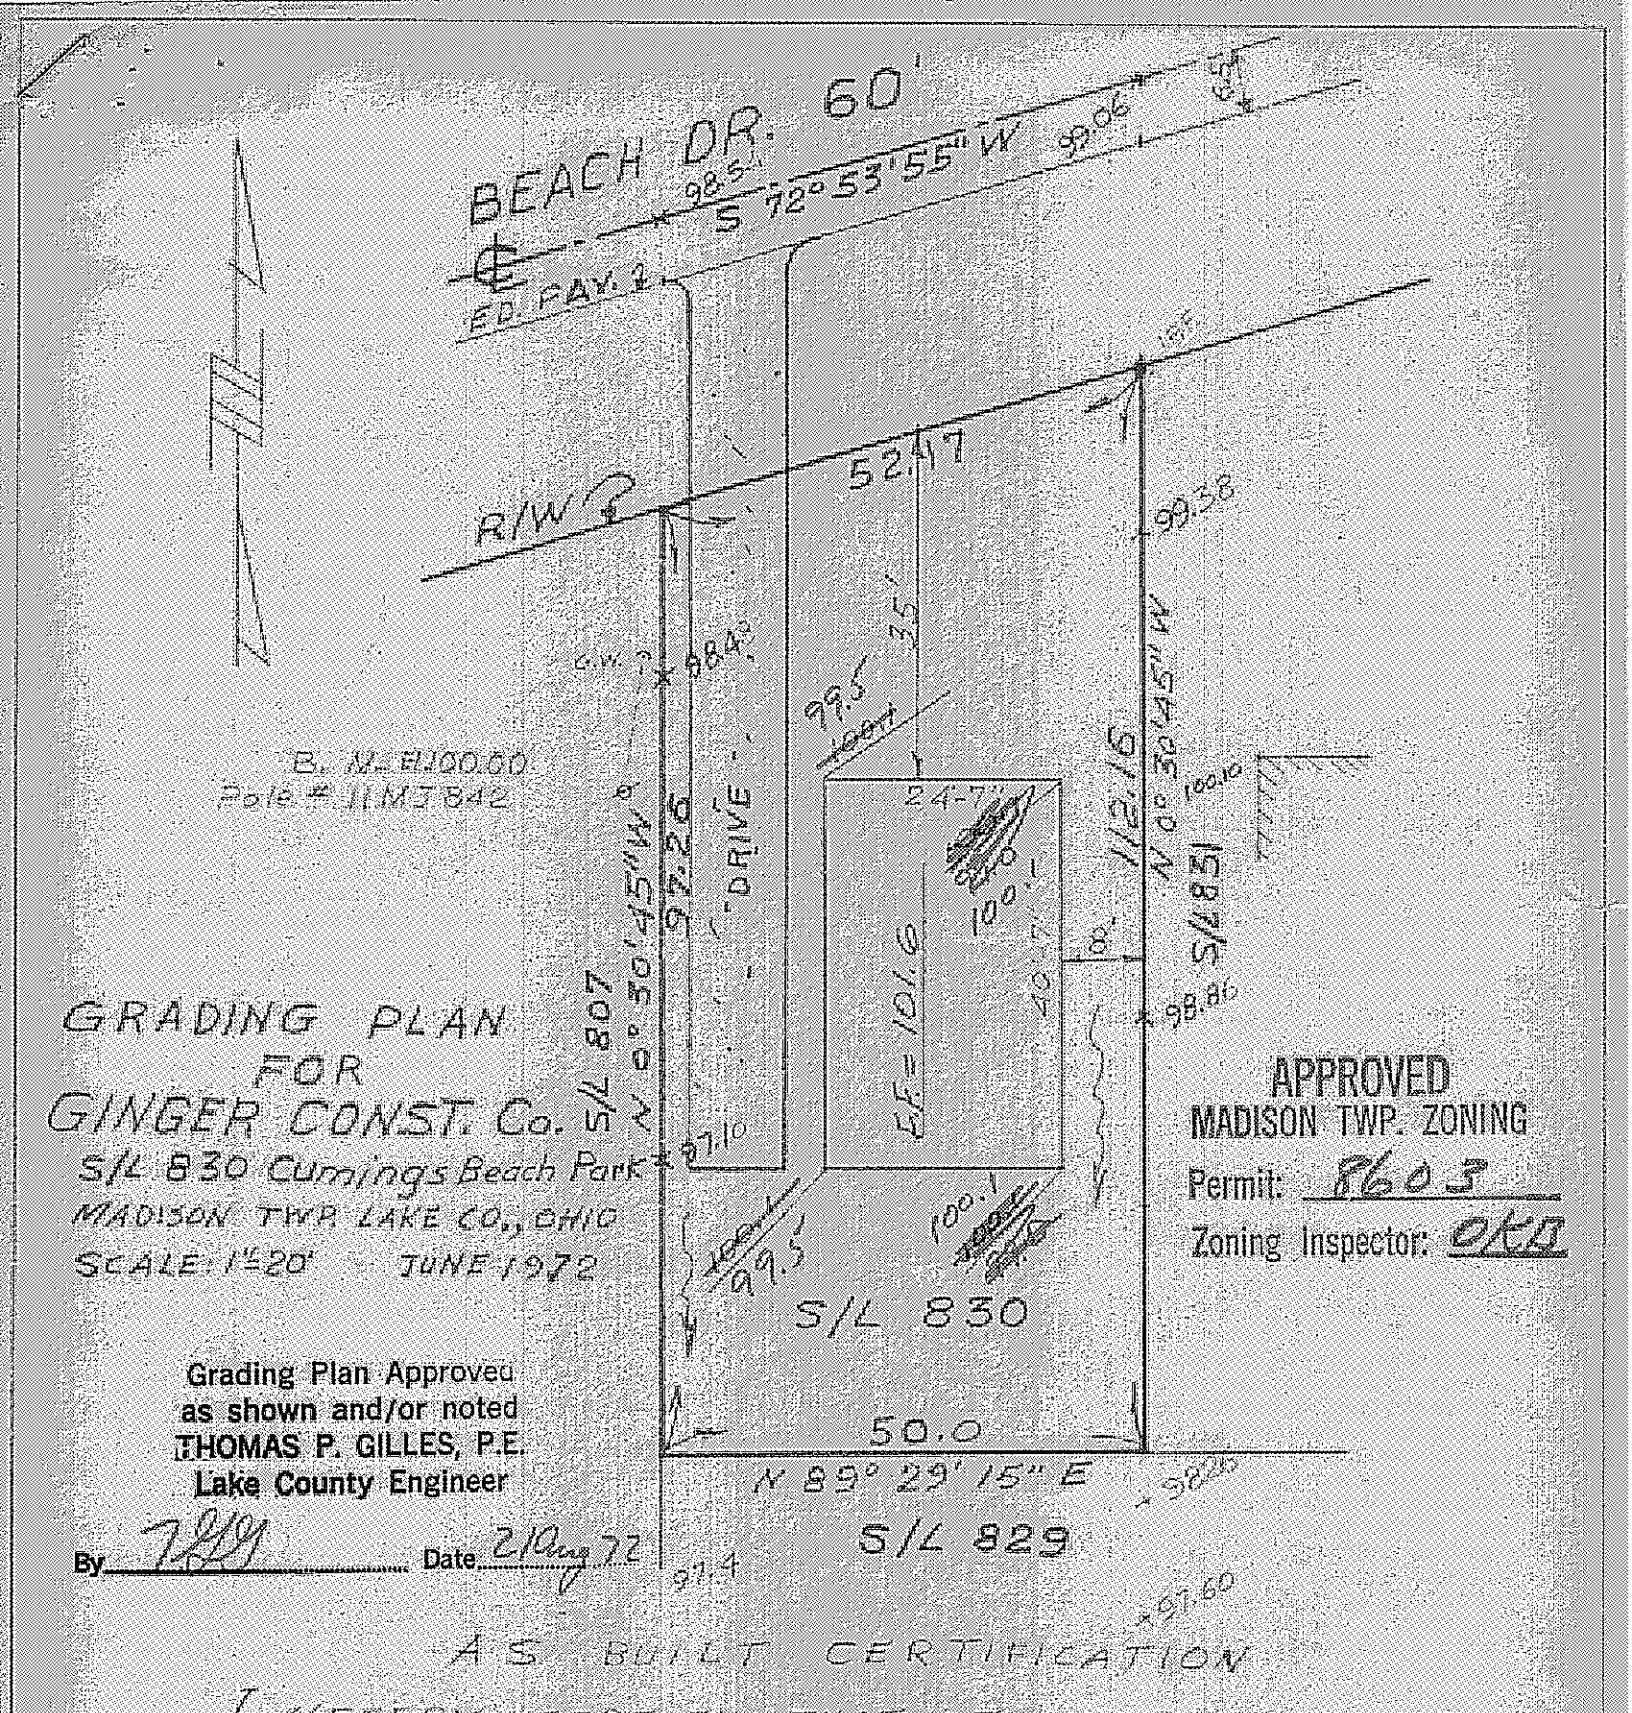


GRADING PLAN
FOR
GINGER CONST. Co.
S/L 830 Cumings Beach Park
MADISON TWP LAKE CO., OHIO
SCALE 1"=20' JUNE 1972

APPROVED
MADISON TWP. ZONING
Permit: 8603
Zoning Inspector: OKO

Grading Plan Approved
as shown and/or noted
THOMAS P. GILLES, P.E.
Lake County Engineer
By _____ Date 21 Aug 72

AS BUILT CERTIFICATION

I HEREBY CERTIFY THAT THE CIRCLED GRADES ARE EXISTING FINISH-GRADES CHECKED IN THE FIELD ON _____ 197__

SURVEY IS CORRECTED TO THE BEST OF MY KNOWLEDGE & BELIEF.

Fullerton - Kerr & Assoc.

by _____ REG. SURVEYOR Number 6614