Grading Plan Approved
as shown and/or noted
THOMAS P. GILLES, P.E.
Lake County Engineer
By _____ Date 10 Aug 72

APPROVED
MADISON TWP. ZONING
Permit: 8564
Zoning Inspector: OKB

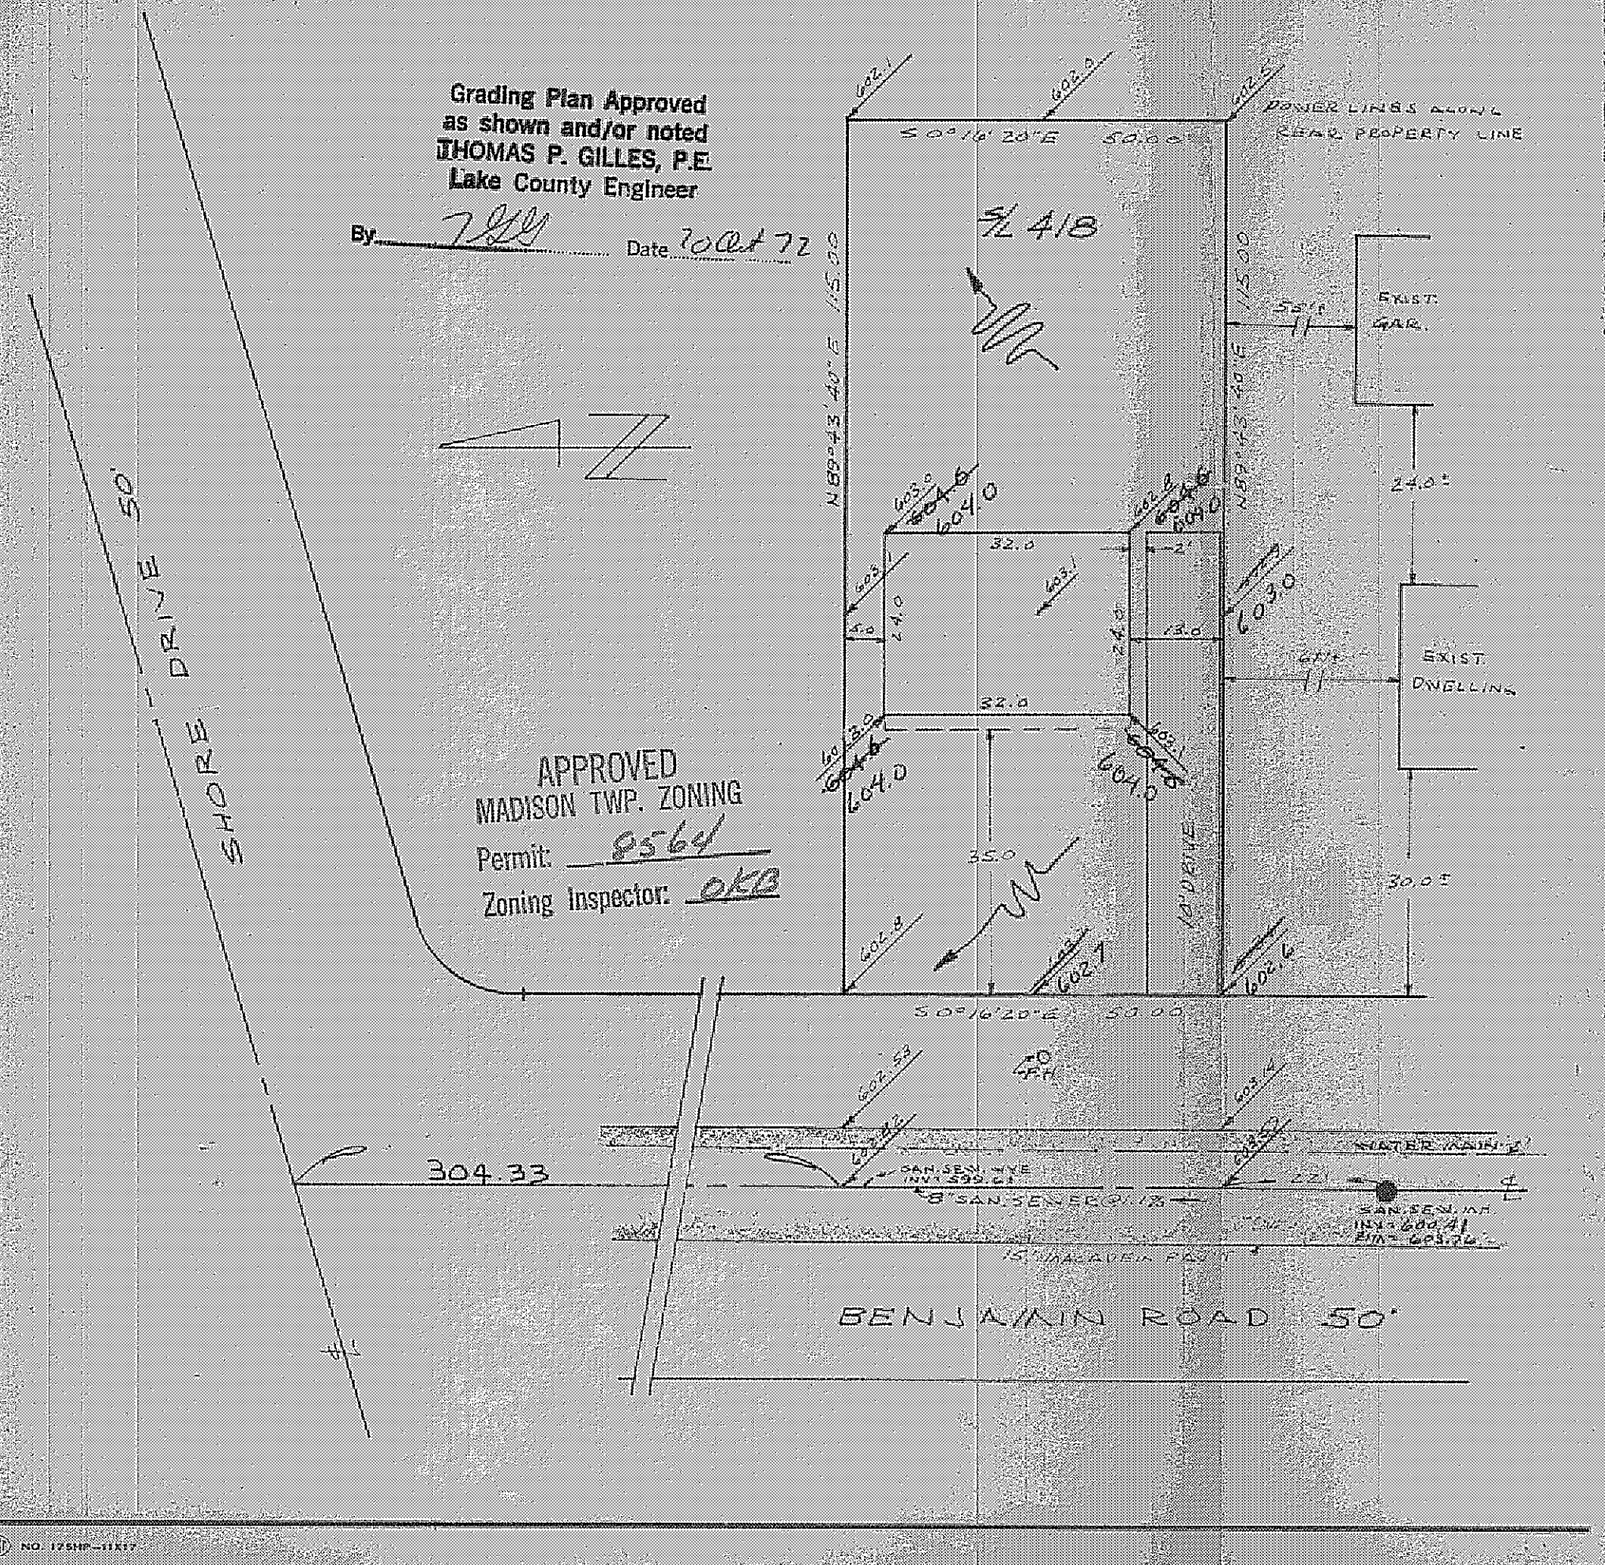

SITE PLAN

Madison TOWNSHIP LAKE COUNTY, OHIO

for: Ryan Homes CLIENT OWNER

1731 Benjamin Road Madison 44057
ADDRESS STREET CITY ZIP

Madison Golf Estates RECORD SUBDIVISION	LOT
E	C 8
VOLUME	PAGE
418	Benjamin Rd STREET
SUBLOT NO.	

LOT	TRACT
VOLUME	PAGE
PERM. PARCEL #	STREET

LEGEND

SANITARY MANHOLE
STORM MANHOLE
INLET OR CATCH BASIN
HYDRANT
EXISTING CONTOURS
PROPOSED CONTOURS
EXIST. ELEV. 100.0
PROP. ELEV. 100.0
WATER VALVE (GAS)
WATER METER (GAS)
AS BUILT ELEVATION
DIRECTION OF SURFACE DRAINAGE

REMARKS

ALL BOUNDARY DATA SHOWN WAS OBTAINED FROM (DEEDS, RECORDED SUBDIVISION PLAT, OR OTHER PUBLIC RECORDS)

DESIGN CERTIFICATION

THIS PLAT WAS PREPARED BY ME, AND IS CORRECT TO THE BEST OF MY KNOWLEDGE AND BELIEF

Richard R. Heyfield P.S. #5506
NAME SURVEYOR REGISTRATION NO.

CHECK LIST

DIMENSIONS
BEARINGS
TIE TO NEAREST STREET
SUBLOT NO PARCEL NO
SURROUNDING OWNERS
BLDG DIMENSIONS FIN GR
BLDG TIES FLR GRADES
APRON TYPE WIDTH THICKNESS
SIDEWALK TYPE WIDTH THICKNESS
CULVERT TYPE DIA LENGTH
WATER MAIN SIZE LOCATION
SAN SEWER SIZE % GR LOC
SAN M H CAST ELEV INV ELEV
SAN CONN SIZE LOC DEPTH
STORM SEWER SIZE % GR LOC
STORM MH CAST ELEV INV ELEV
PAVT TYPE GRADE CURBS
GAS LINE LOC SIZE PRESSURE
SEPTIC TANK SIZE LOC
WELL LOCATION

RIVISIONS		
NO	DATE	BY
1		
2		
3		
4		
5		

PLAN PREPARED BY:

DEBEVEC-SALO & ASSOC., INC.
CIVIL ENGINEERS - SURVEYORS NAME
130 E. Jackson St. Painesville, O.
ADDRESS

DRAWN BY Shultz	SCALE 1"=20'	PHONE NO.
CHK'D R.H.	DATE 6-20-72	DRAWING NO. 3528
CREW CHIEF	APP'D	

POST NO. 12SHP-11X17