Grading Plan Approved
as shown and/or noted
THOMAS P. GILLES, P.E.
Lake County Engineer
By JWK Date 14 May 73

SITE PLAN

Madison TOWNSHIP LAKE COUNTY, OHIO

for Hallmark Builders
CLIENT OWNER

2207 St. James St. Madison 44057
ADDRESS STREET CITY ZIP

Chapel Grove Sub. SUBDIVISION NAME
46 SUBLOT NO Byron Drive STREET

LOT ~~TRACT~~
VOLUME PAGE
PERM PARCEL # STREET

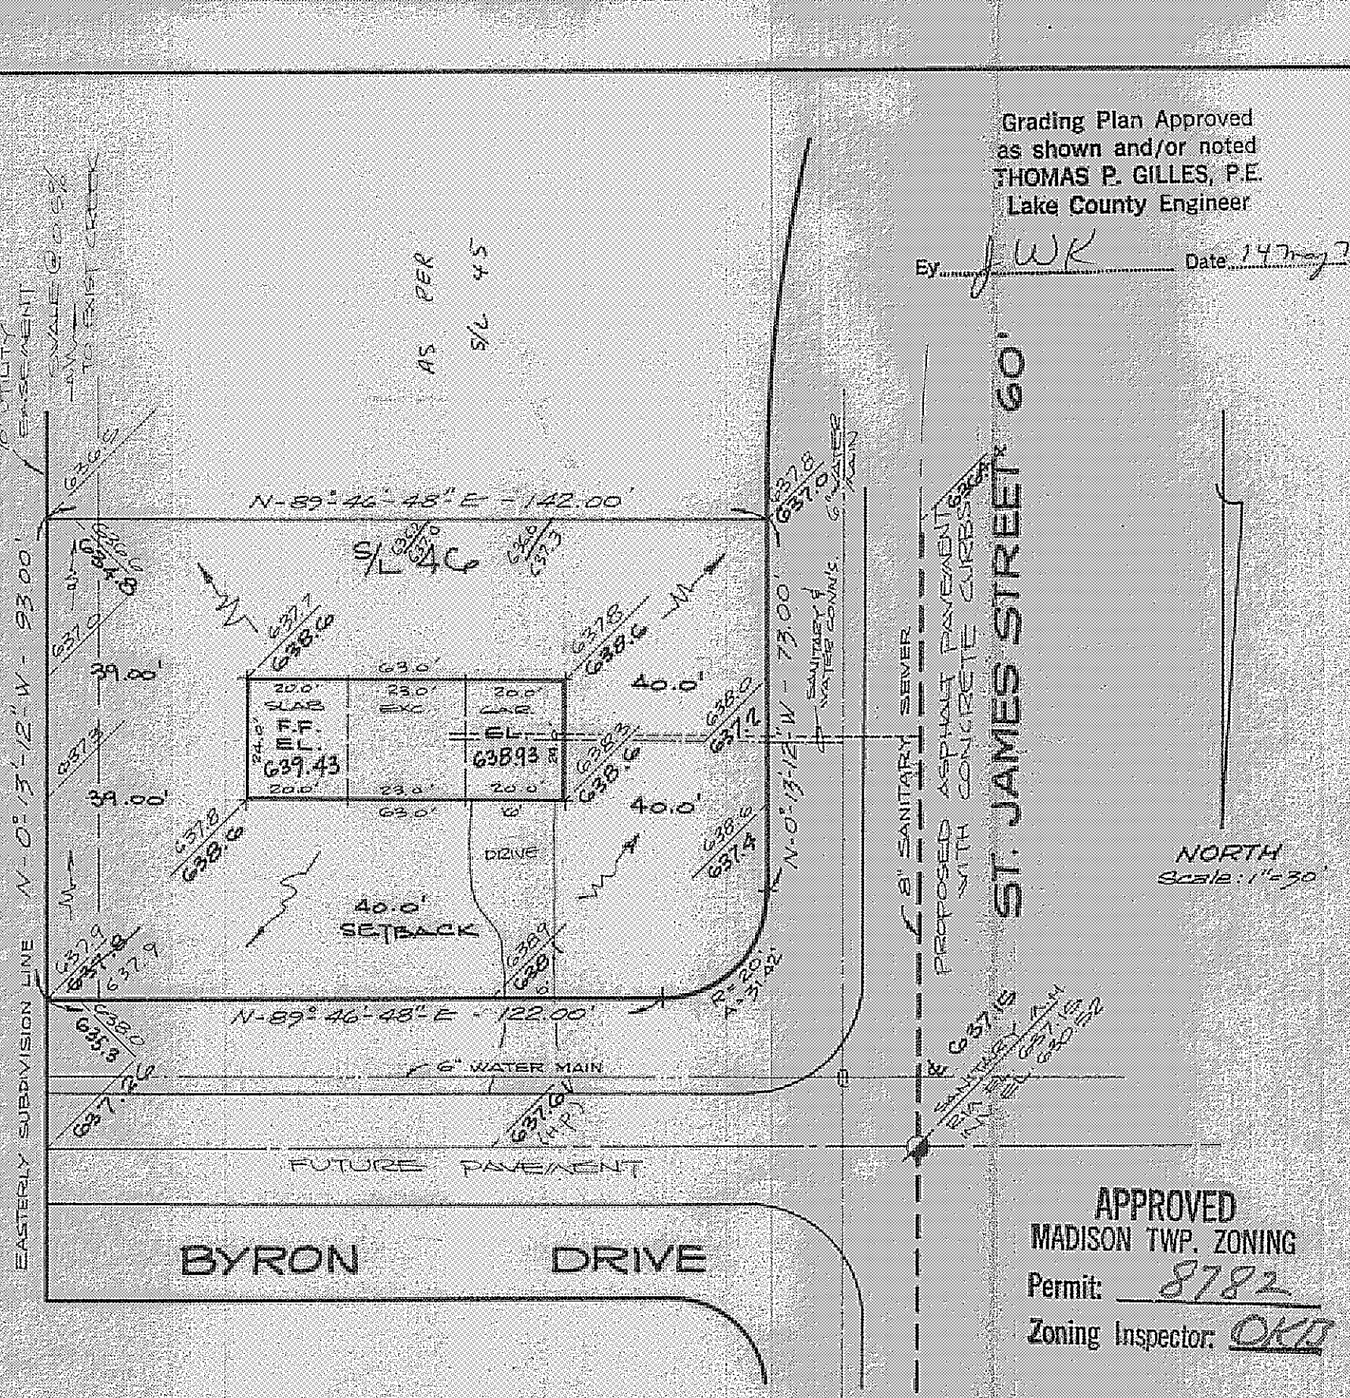

LEGEND

SANITARY MANHOLE
STORM MANHOLE
INLET OR CATCH BASIN
HYDRANT
EXISTING CONTOURS
PROPOSED CONTOURS
EXIST ELEV - 1000
100.0 - PROP ELEV

WATER VALVE (GAS)
WATER METER (GAS)
AS BUILT ELEVATION
INDICATES DIRECTION OF SURFACE DRAINAGE

REMARKS

ALL BOUNDARY DATA SHOWN WAS OBTAINED FROM (DEEDS RECORDED SUBDIVISION PLAT, OR OTHER PUBLIC RECORDS)

DESIGN CERTIFICATION

THIS PLAT WAS PREPARED BY ME, AND IS CORRECT TO THE BEST OF MY KNOWLEDGE AND BELIEF

NAME SURVEYOR REGISTRATION NO.

CHECK LIST

DIMENSIONS
BEARINGS
TIE TO NEAREST STREET
SUBLOT NO PARCEL NO
SURROUNDING OWNERS
BLDG DIMENSIONS FIN GR
BLDG TIES FLR GRADES
APRON TYPE WIDTH THICKNESS
SIDEWALK TYPE WIDTH THICKNESS
CULVERT TYPE DIA LENGTH

WATER MAIN SIZE LOCATION
SAN SEWER SIZE % GR LOC
SAN M H CAST ELEV INV ELEV
SAN CONN SIZE LOC DEPTH
STORM SEWER SIZE % GR LOC
STORM MH CAST ELEV INV ELEV
PAVT TYPE GRADE CURBS
GAS LINE LOC SIZE PRESSURE
SEPTIC TANK SIZE LOC
WELL LOCATION

APPROVED
MADISON TWP. ZONING
Permit: 8782
Zoning Inspector: OKD

"AS BUILT" CERTIFICATION

I, HEREBY CERTIFY THAT THE CIRCLED GRADES ARE EXISTING FINISH GRADES CHECKED IN FIELD ON _____ 19__ BY SURVEYING AND ARE CORRECT TO THE BEST OF MY KNOWLEDGE AND BELIEF

REGISTERED SURVEYOR REG. NO

REVISIONS		
NO	DATE	BY
1		
2		
3		
4		
5		

PLAN PREPARED BY:
DEBEVEC-SALO & ASSOC., INC.
NAME
130 EAST JACKSON ST. PAINESVILLE
ADDRESS

DRAWN BY JRB	SCALE 1"=30'	PHONE NO
CHK'D	DATE 3-21-73	DRAWING NO 3609-46
CREW CHIEF	APP'D	