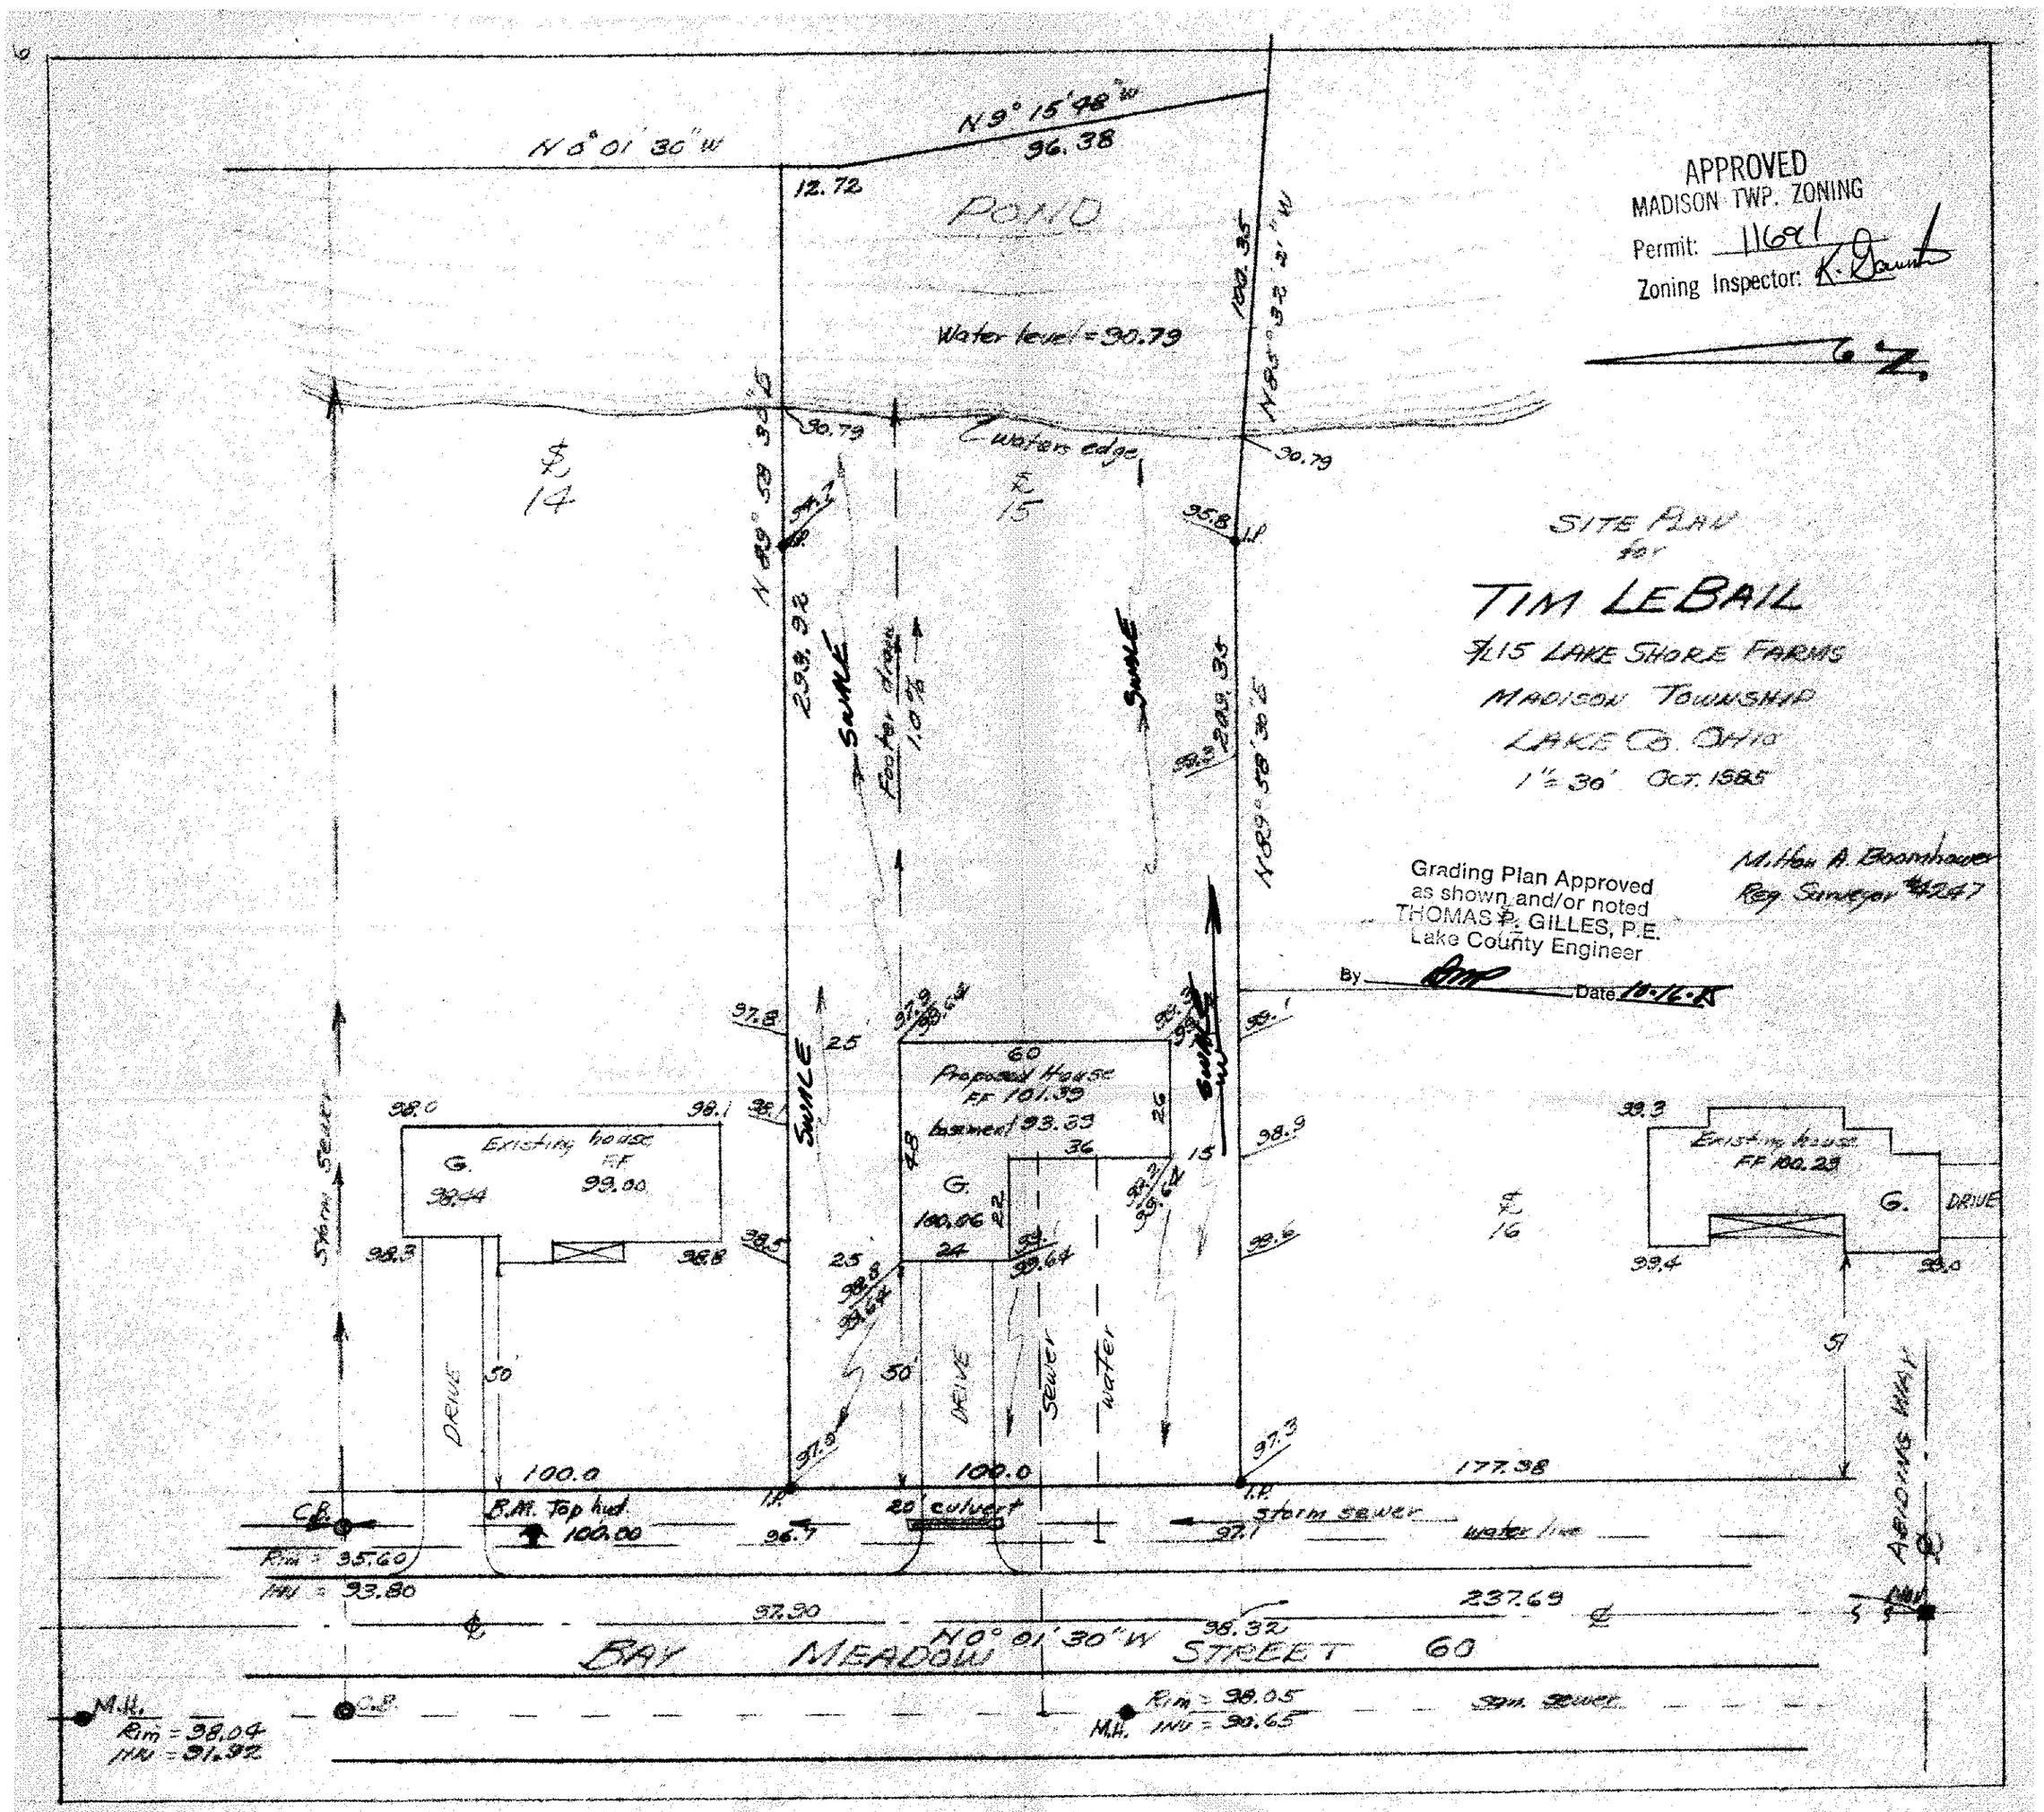

APPROVED
MADISON TWP. ZONING
Permit: 11691
Zoning Inspector: K. Gaunt
SITE PLAN
for
TIM LEBAIL
S/L 15 LAKE SHORE FARMS
MADISON TOWNSHIP
LAKE CO. OHIO
1" = 30' OCT. 1985
Milton A. Boomhower
Reg. Surveyor #4247
Grading Plan Approved
as shown and/or noted
THOMAS P. GILLES, P.E.
Lake County Engineer
By
Date 10-16-85
N 0° 01' 30" W
N 9° 15' 48" W
96.38
12.72
POND
Water level = 90.79
100.35
N 85° 32' 21" W
N 89° 58' 30" E
90.79
waters edge
℄ 14
℄ 15
℄ 16
293.92
SWALE
Footer drain 1.0%
209.35
Proposed House
FF 101.39
basement 93.39
Existing house
FF 99.00
G.
98.44
100.06
Existing house
FF 100.29
DRIVE
Storm Sewer
Sewer
water
100.0
177.38
B.M. Top hud
100.00
20' culvert
storm sewer
water line
Rim = 95.60
INV = 93.80
237.69
N 0° 01' 30" W
BAY MEADOW STREET 60
M.H.
Rim = 98.04
INV = 91.92
Rim = 98.05
INV = 90.65
San. sewer
ABIDING WAY