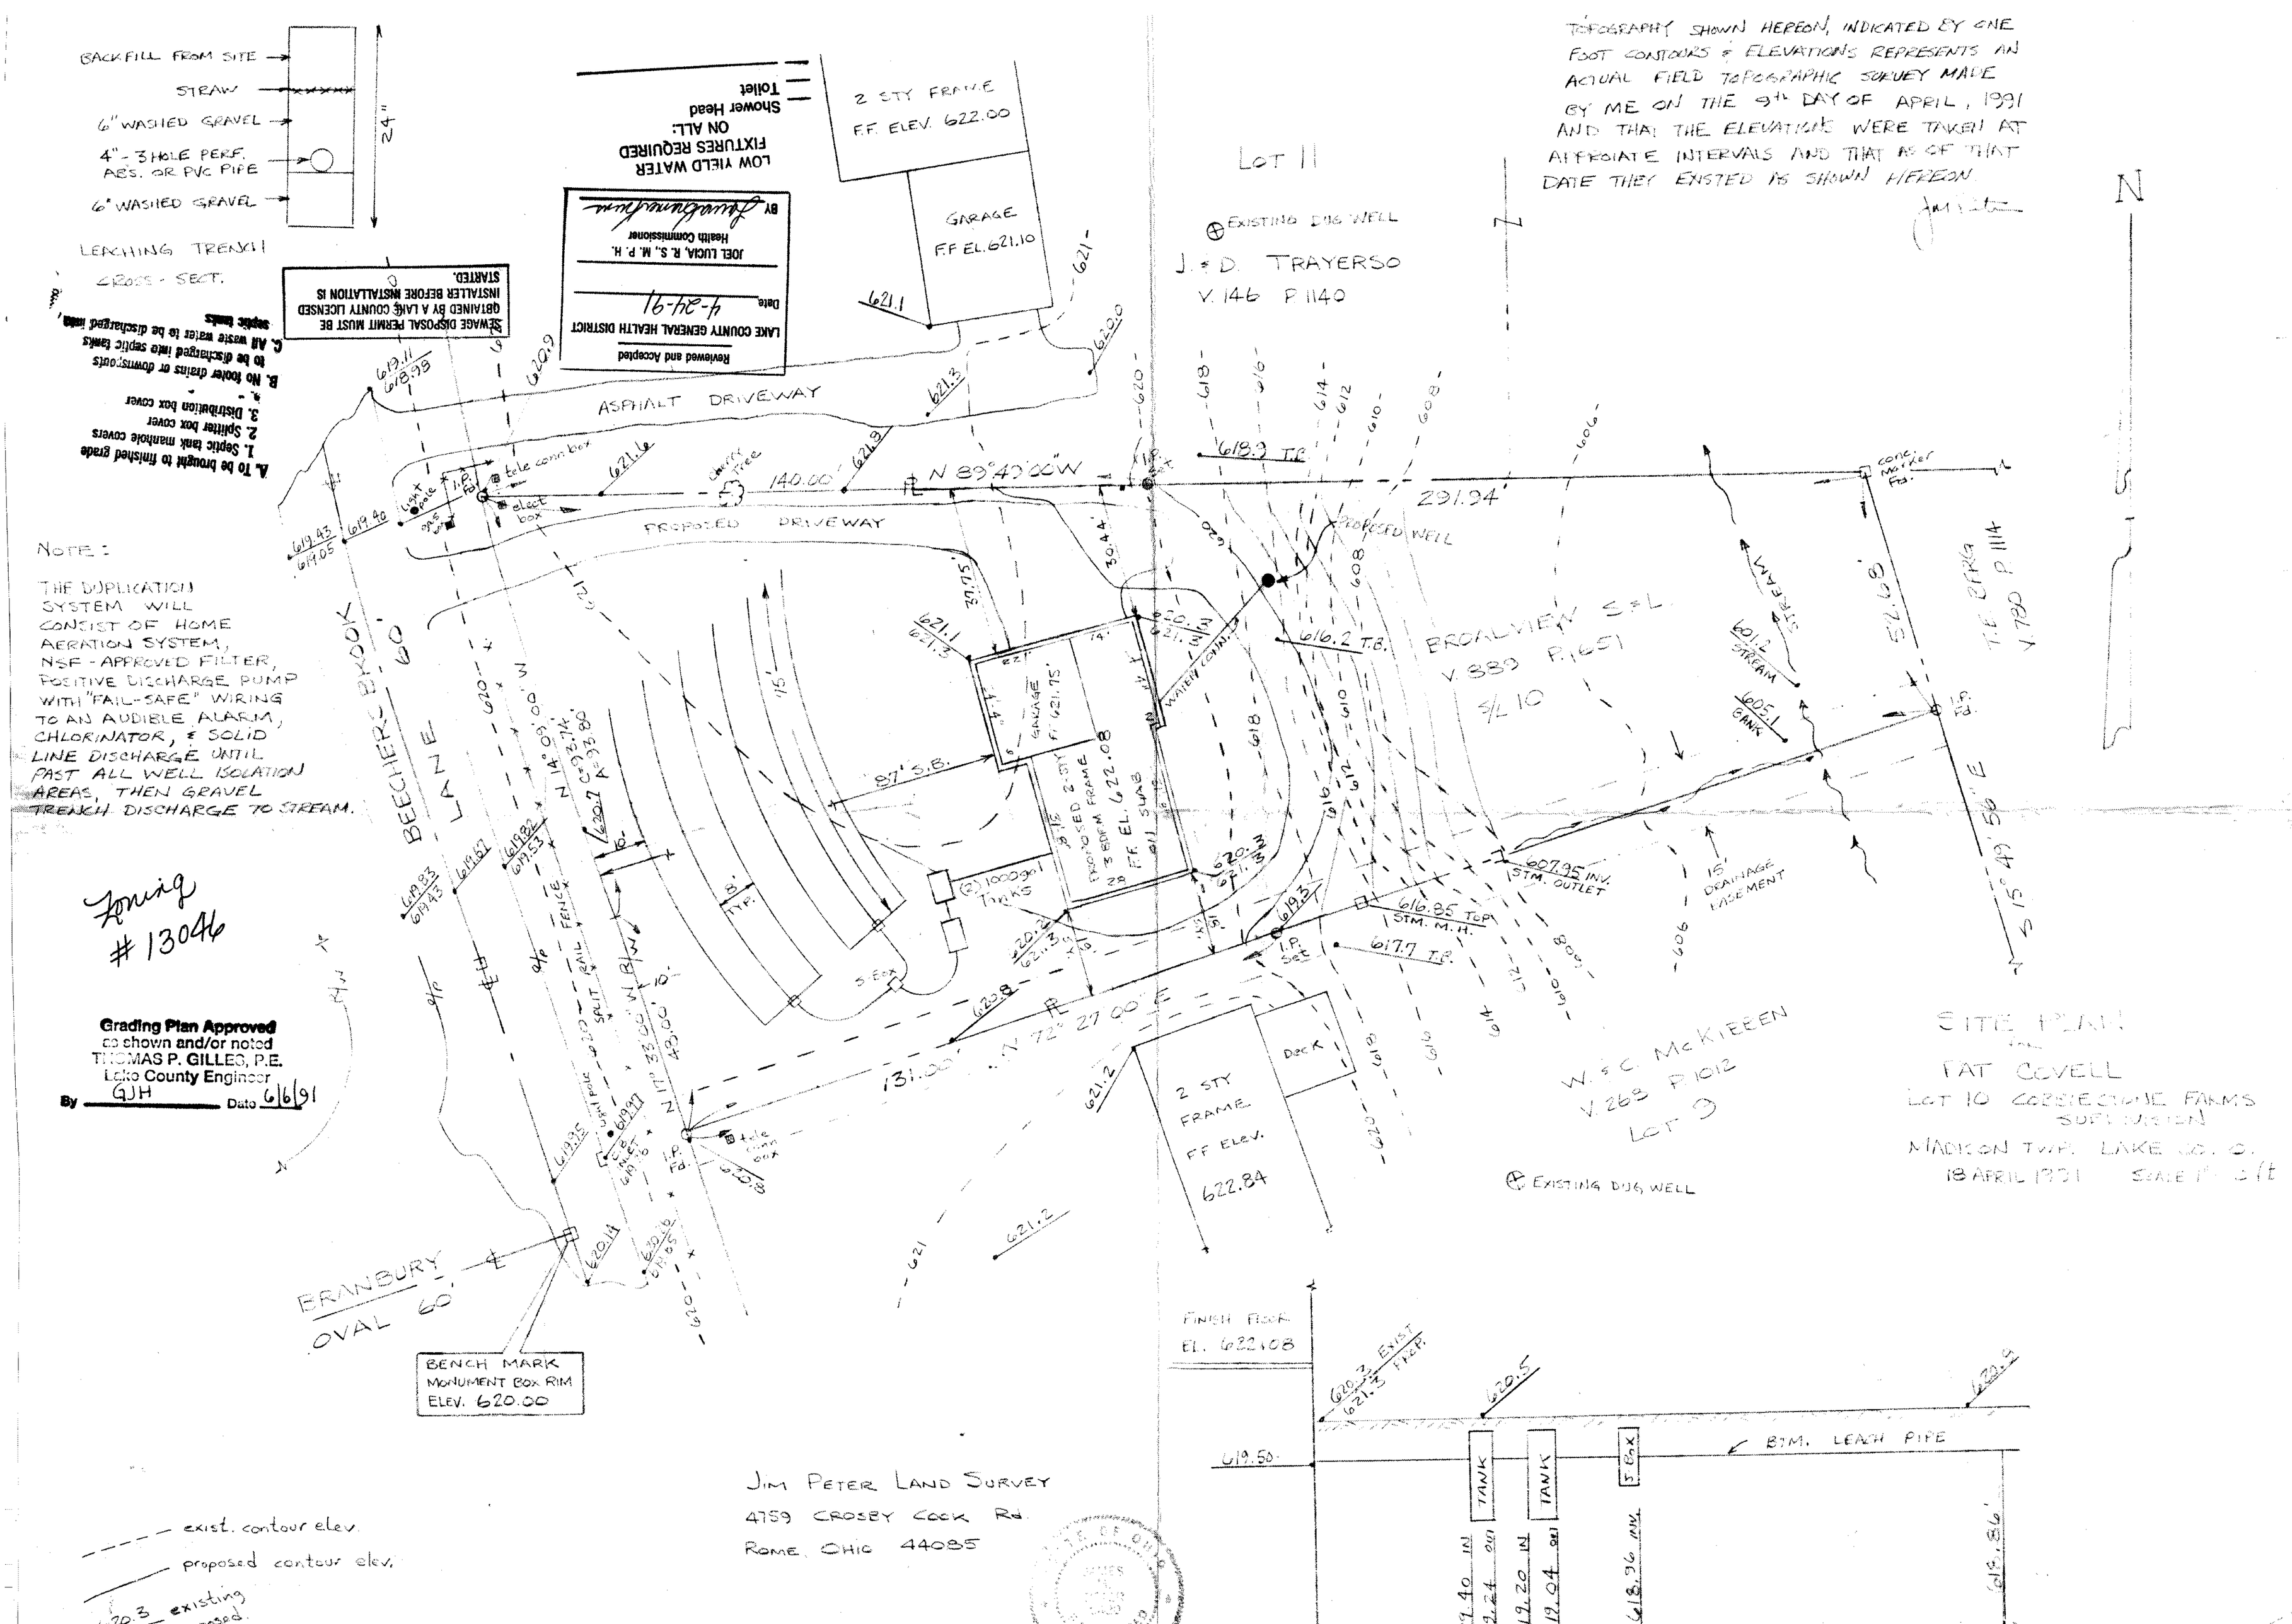TOPOGRAPHY SHOWN HEREON, INDICATED BY ONE FOOT CONTOURS & ELEVATIONS REPRESENTS AN ACTUAL FIELD TOPOGRAPHIC SURVEY MADE BY ME ON THE 9th DAY OF APRIL, 1991 AND THAT THE ELEVATIONS WERE TAKEN AT APPROPIATE INTERVALS AND THAT AS OF THAT DATE THEY EXISTED AS SHOWN HEREON.