SITE PLAN

MADISON TOWNSHIP — LAKE COUNTY, OHIO

for: KAREN HOWLEY (CLIENT / OWNER)

2444 PLEASANT PLACE, MADISON TWP. (ADDRESS / STREET / CITY / ZIP)

CURVE DATA
Δ = 42°24'00"
C = 203.52'
B = S 65°05'00" W
A = 213.36'

SEWAGE DISPOSAL PERMIT MUST BE OBTAINED BY A LAKE COUNTY LICENSED INSTALLER BEFORE INSTALLATION IS STARTED.

NOTE: IN THE EVENT OF INITIAL SYSTEM FAILURE, THE AREA BETWEEN EXISTING EVAPO-TRANSPIRATION LINES WILL BE UTILIZED FOR DUPLICATION AREA.

S/L 16

Reviewed and Accepted
LAKE COUNTY GENERAL HEALTH DISTRICT
Date 12-17-86
JOEL LUCIA, R. S., M. P. H.
Health Commissioner
By Gerald B Moore

VACANT LOT

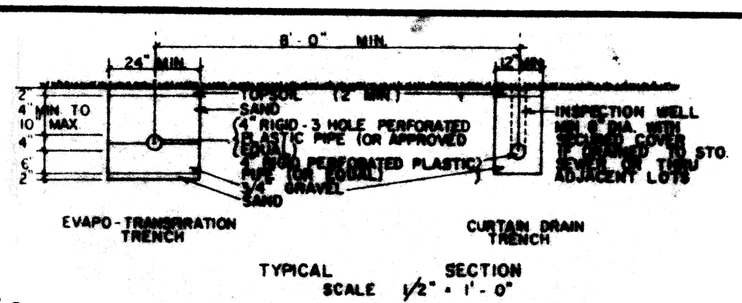

TYPICAL SECTION
SCALE 1/2" = 1'-0"

LOW YIELD WATER FIXTURES REQUIRED ON ALL:
Shower Head
Toilet

APPROVED
MADISON TWP. ZONING
Permit: 11991
Zoning Inspector: [signature]

A. To be brought to finished grade
B. Septic Tank
C. Distribution Box
D. Septic Tanks
E. Water to be [illegible] into Septic Tanks
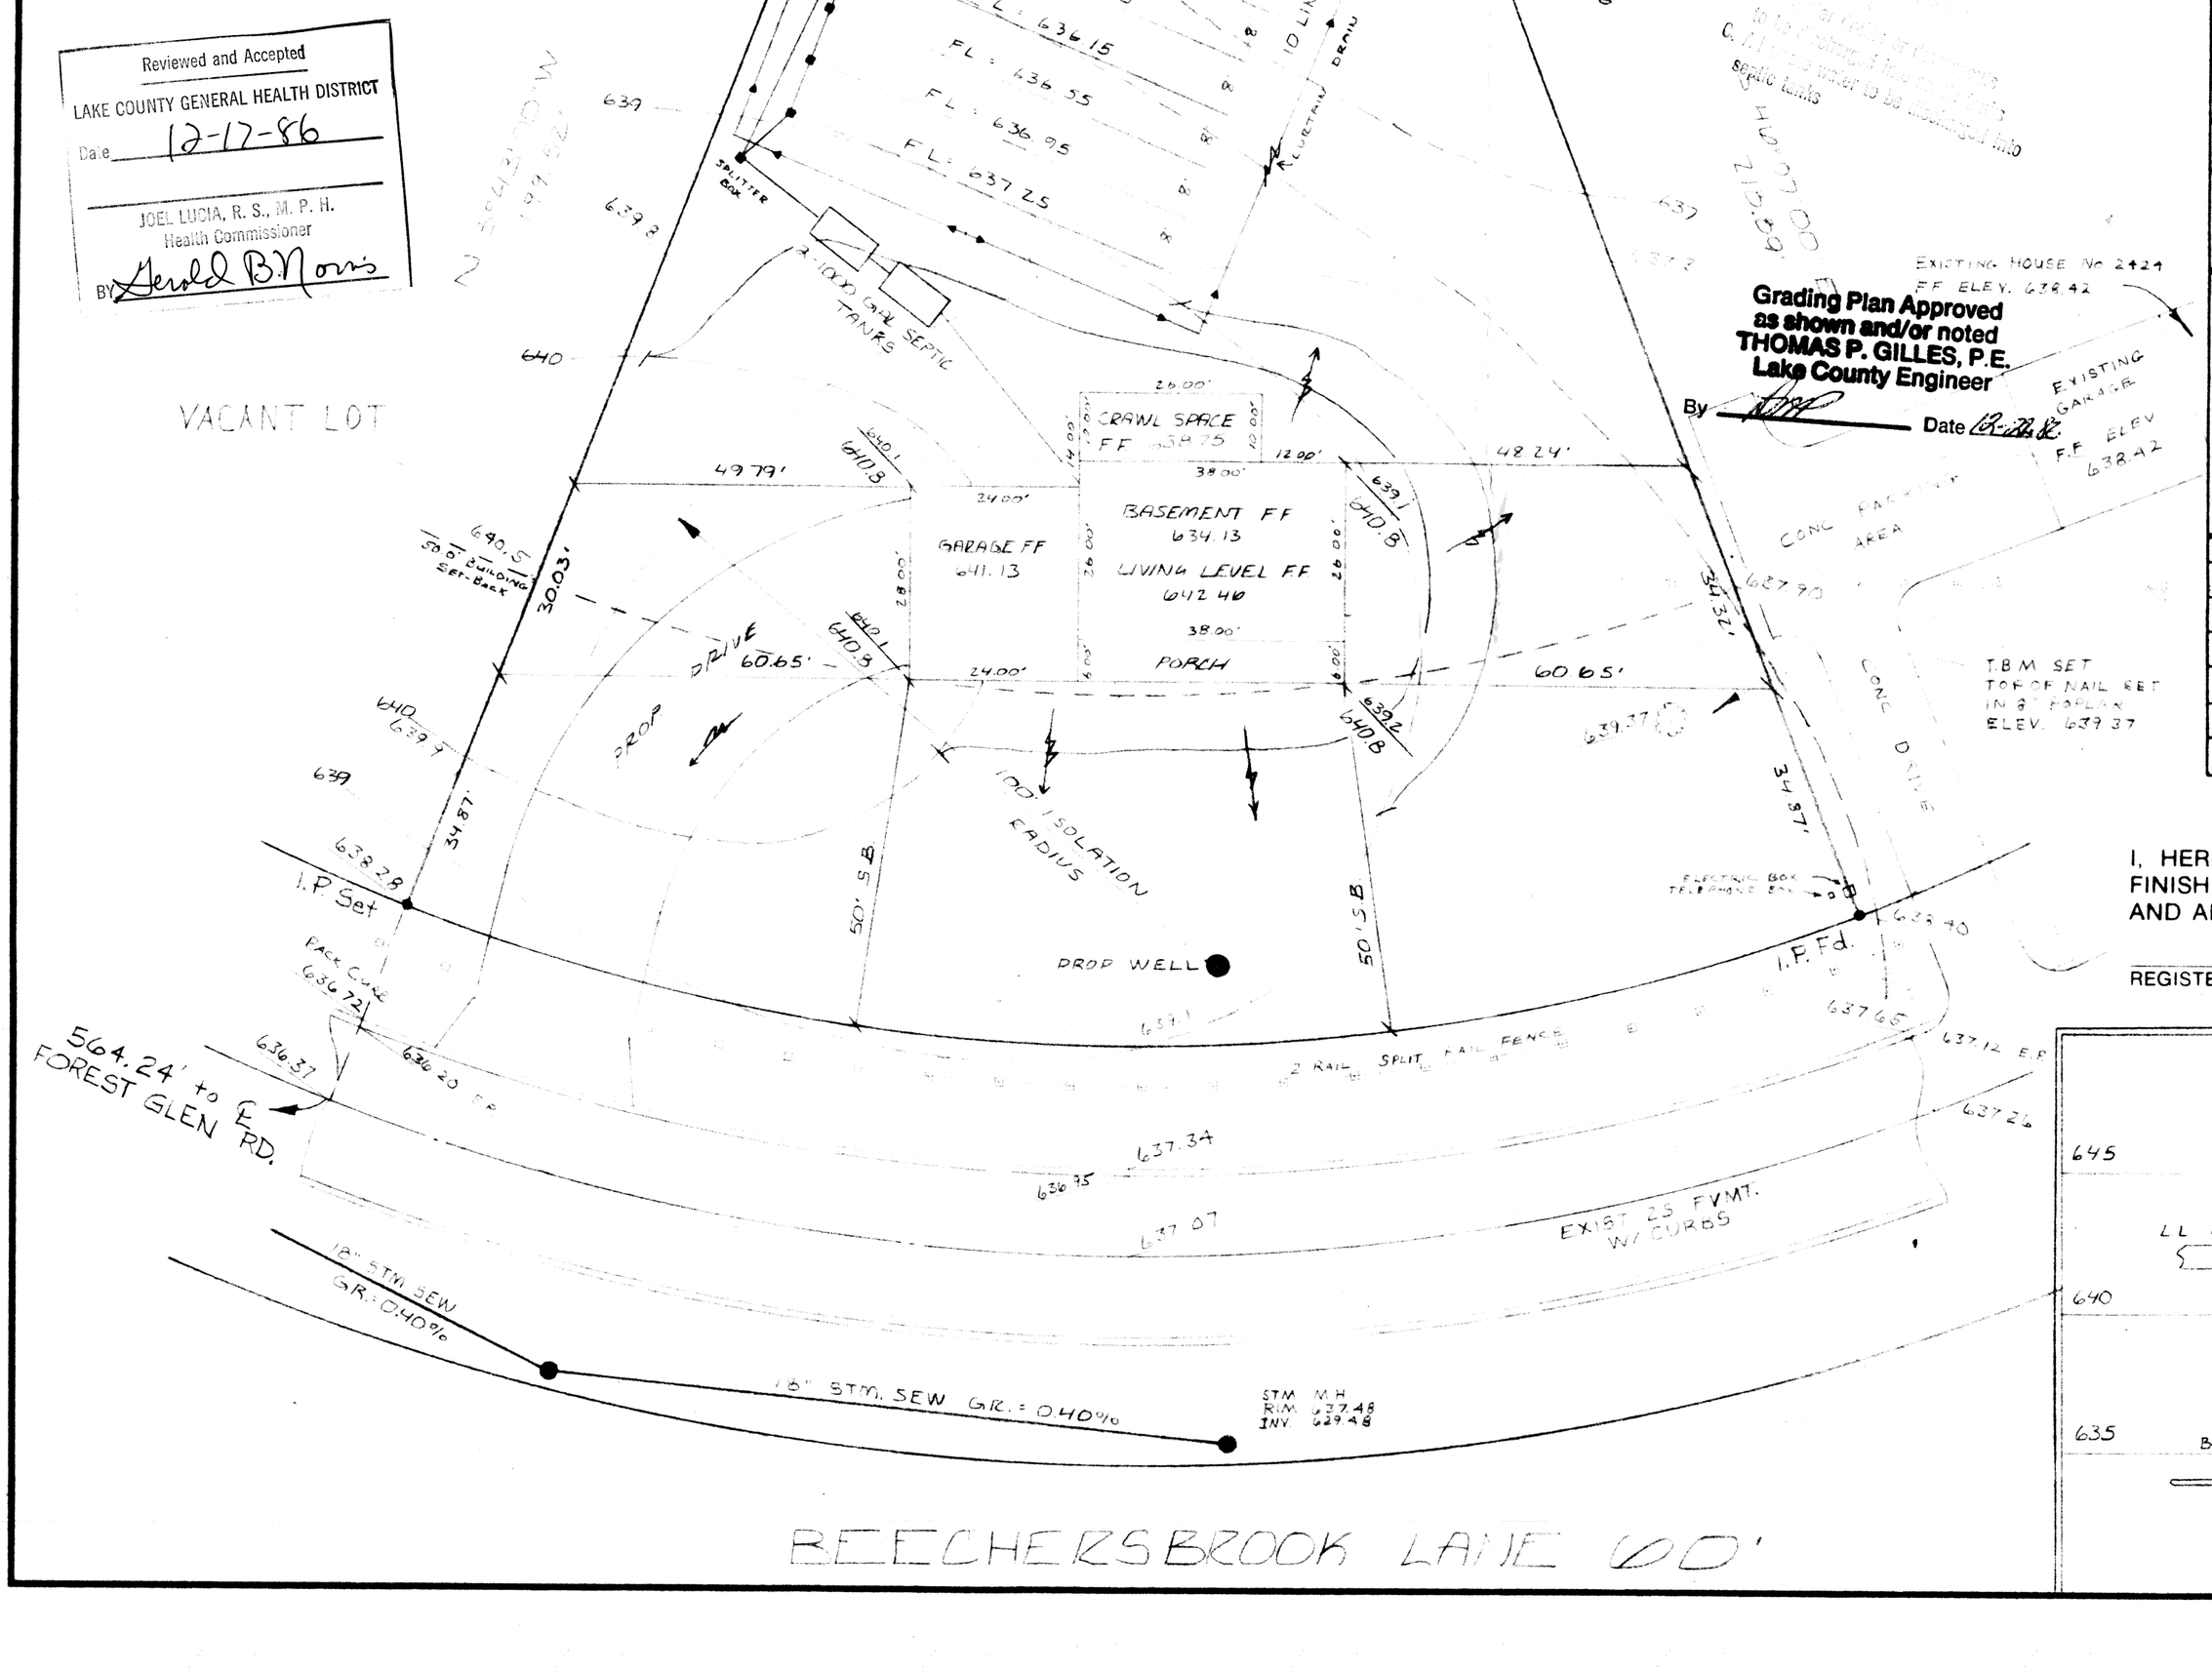
Grading Plan Approved as shown and/or noted
THOMAS P. GILLES, P.E.
Lake County Engineer
By [signature] Date 12-22-86