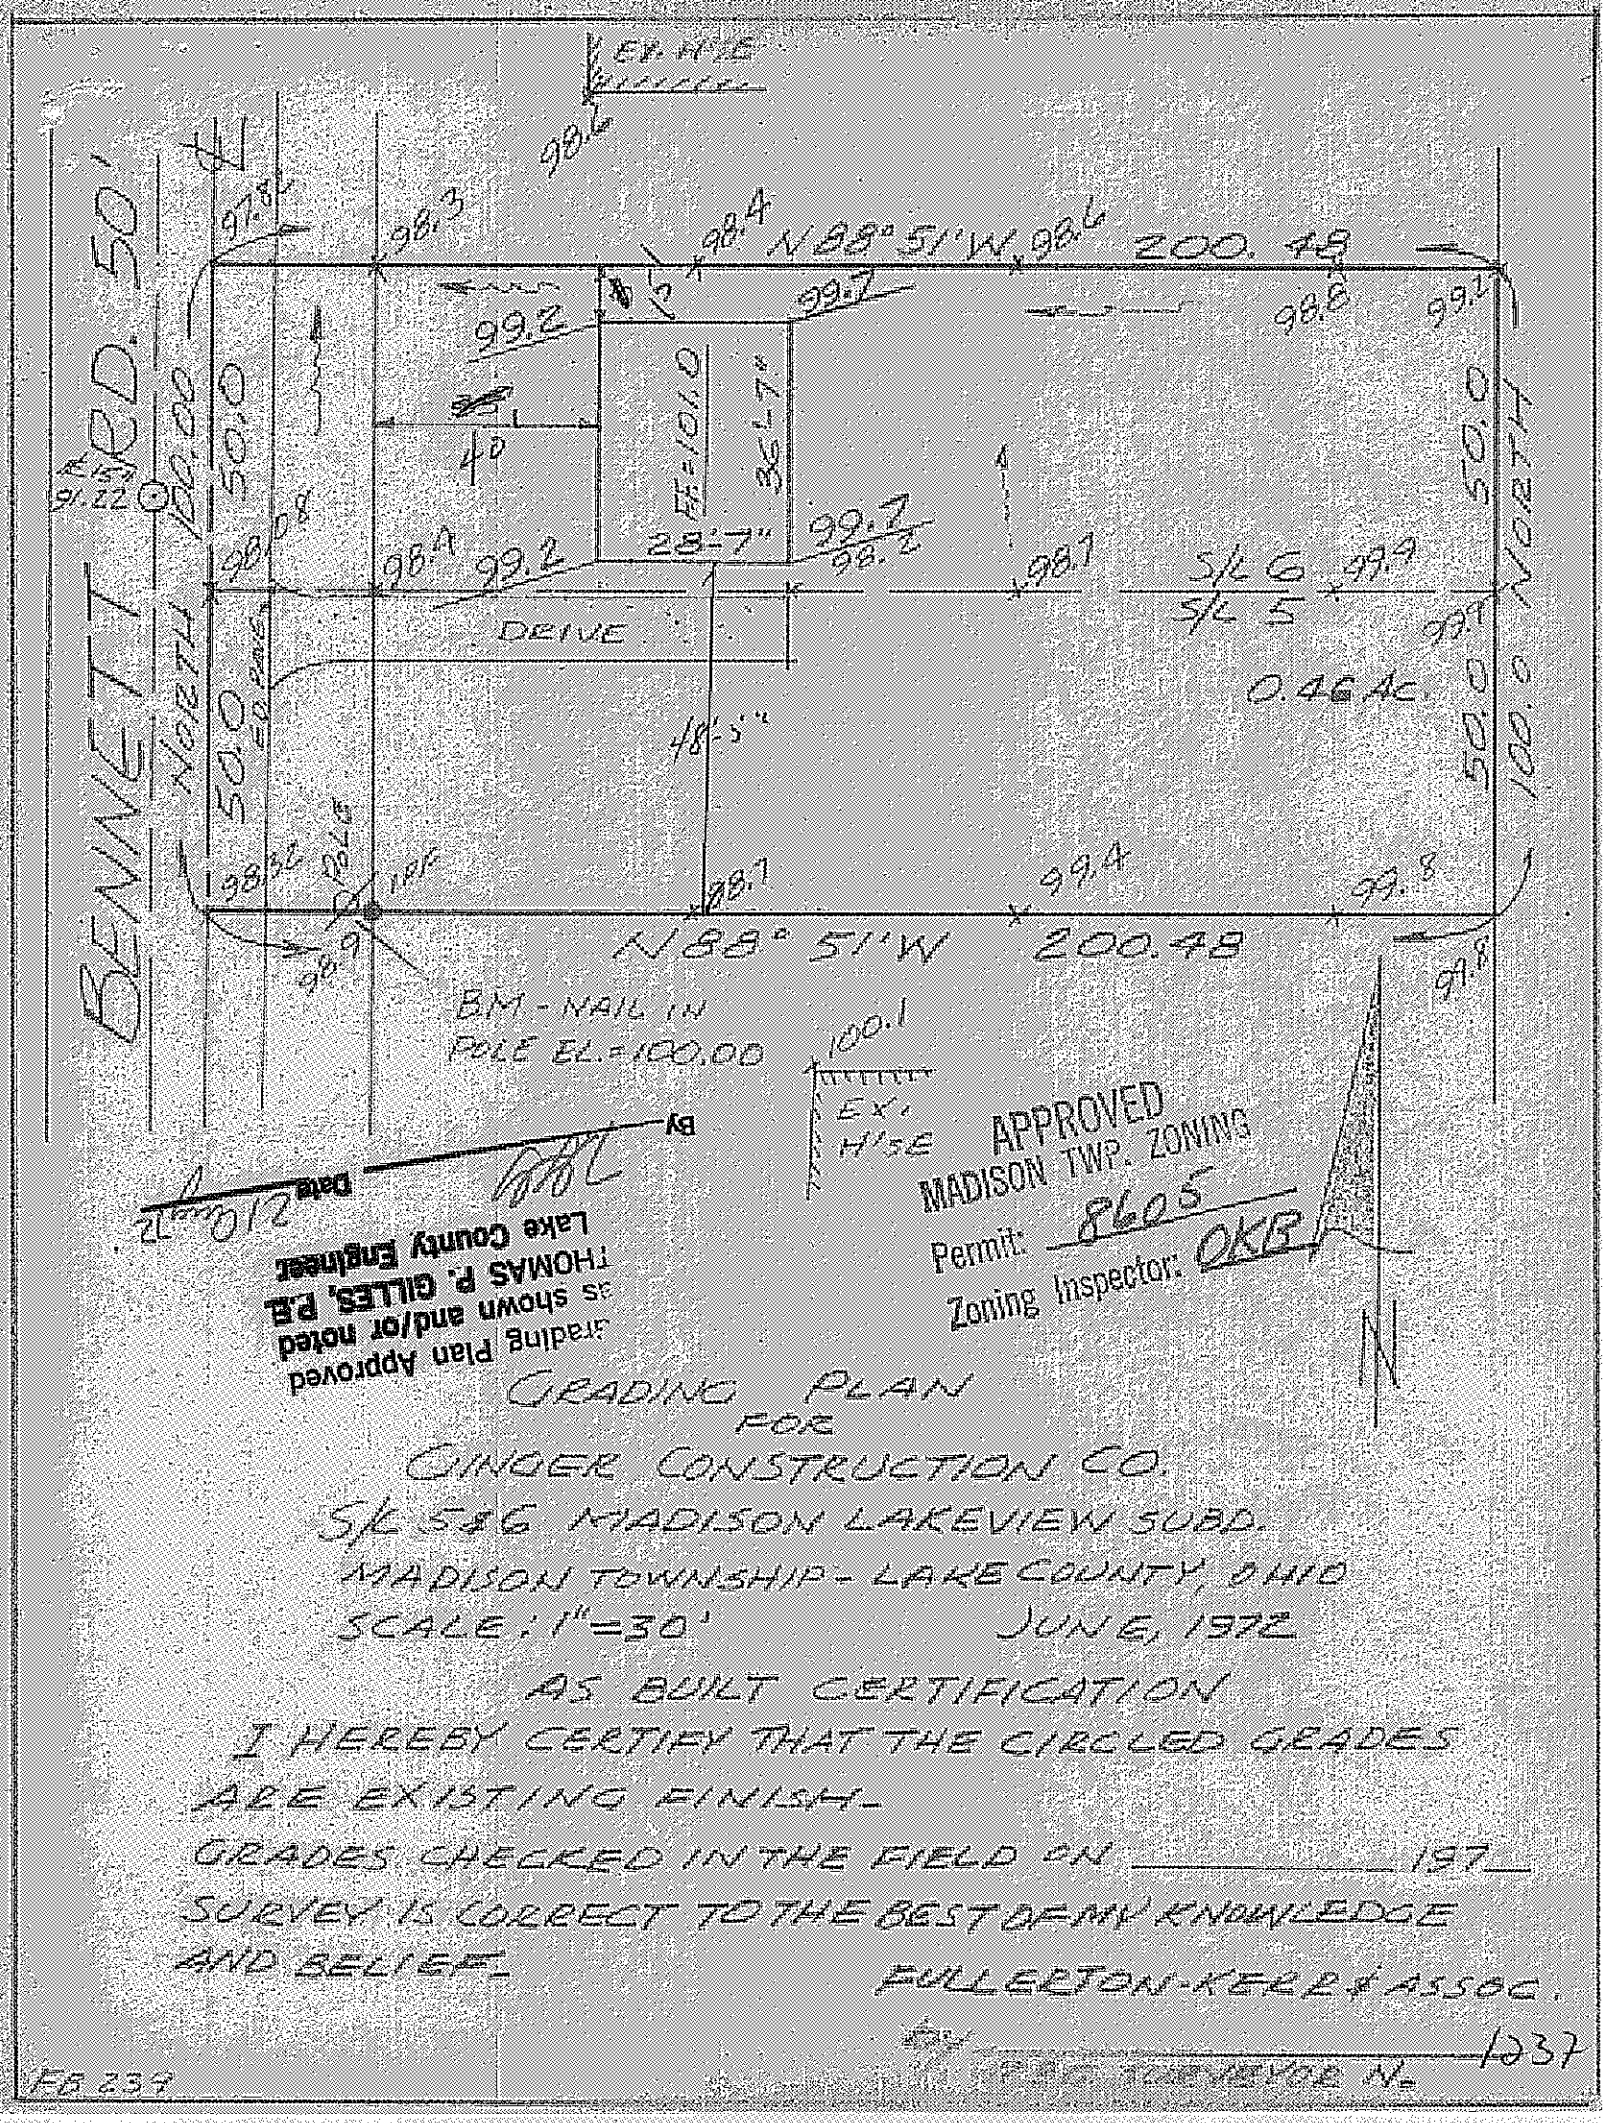

GRADING PLAN
FOR
GINGER CONSTRUCTION CO.
S/L 5&6 MADISON LAKEVIEW SUBD.
MADISON TOWNSHIP - LAKE COUNTY, OHIO
SCALE: 1"=30' JUNE, 1972

AS BUILT CERTIFICATION

I HEREBY CERTIFY THAT THE CIRCLED GRADES ARE EXISTING FINISH.

GRADES CHECKED IN THE FIELD ON _____ 197__

SURVEY IS CORRECT TO THE BEST OF MY KNOWLEDGE AND BELIEF.

FULLERTON-KERR & ASSOC.

By _____ 1237

FB 239