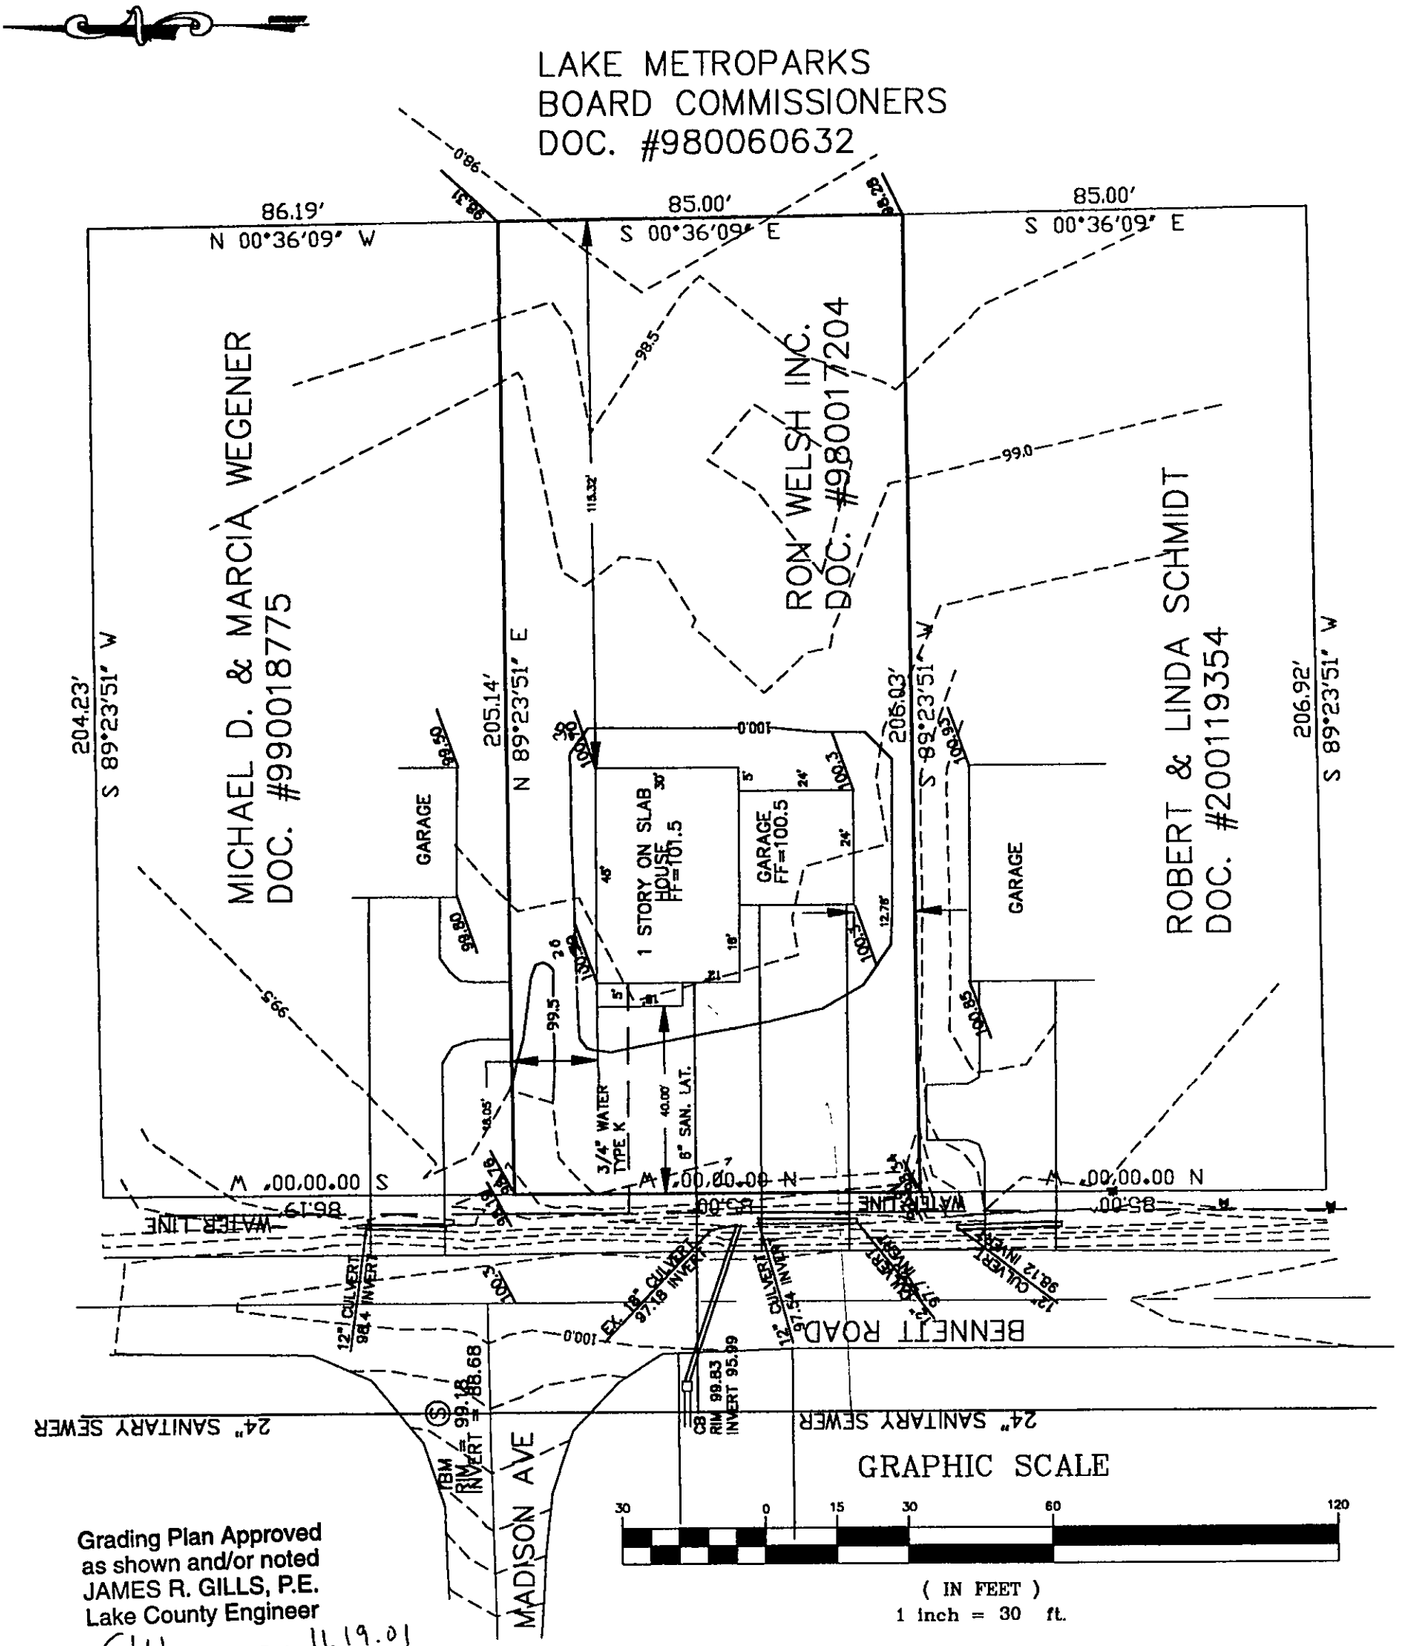

Grading Plan Approved
as shown and/or noted
JAMES R. GILLS, P.E.
Lake County Engineer
By GJH Date 11.19.01

NOTES : 1. The Contractor Shall Verify the Following Before Starting: Finish Floor Elevations and House Size. Location and elevation of existing utility connections.

2. Contractor Shall Contact OUPS at least 2 Working Days prior to construction, 1-800-362-2764.

"I, the undersigned hereby certify that this topography, indicated by 1' contours and elevations shown hereon represents an actual field survey made by COR Consultants Nov., 2001 and that the elevations were taken at appropriate intervals and that as of that date they existed as indicated hereon."

STATE OF OHIO DAVID A. RAPP 7597 REGISTERED PROFESSIONAL SURVEYOR

David A. Rapp 11/16/01 Reg. No. 21179

COR Consultants, Inc.

23 S. Forest Street Geneva, Ohio 44041
440-466-8085

DATE: Nov., 2001
DRAWN BY: W.H.H.
CHECKED BY: RMO
APPROVED BY: DAR
P.S. No. 7597

RON WELSH INC.
BENNETT ROAD
MADISON, OHIO