SITE PLAN
FOR
WANDA DAVIRRO

BEING A PART OF THE BOLLES LOT
TRACT NO. 2 IN THE TOWNSHIP OF MADISON
COUNTY OF LAKE, STATE OF OHIO

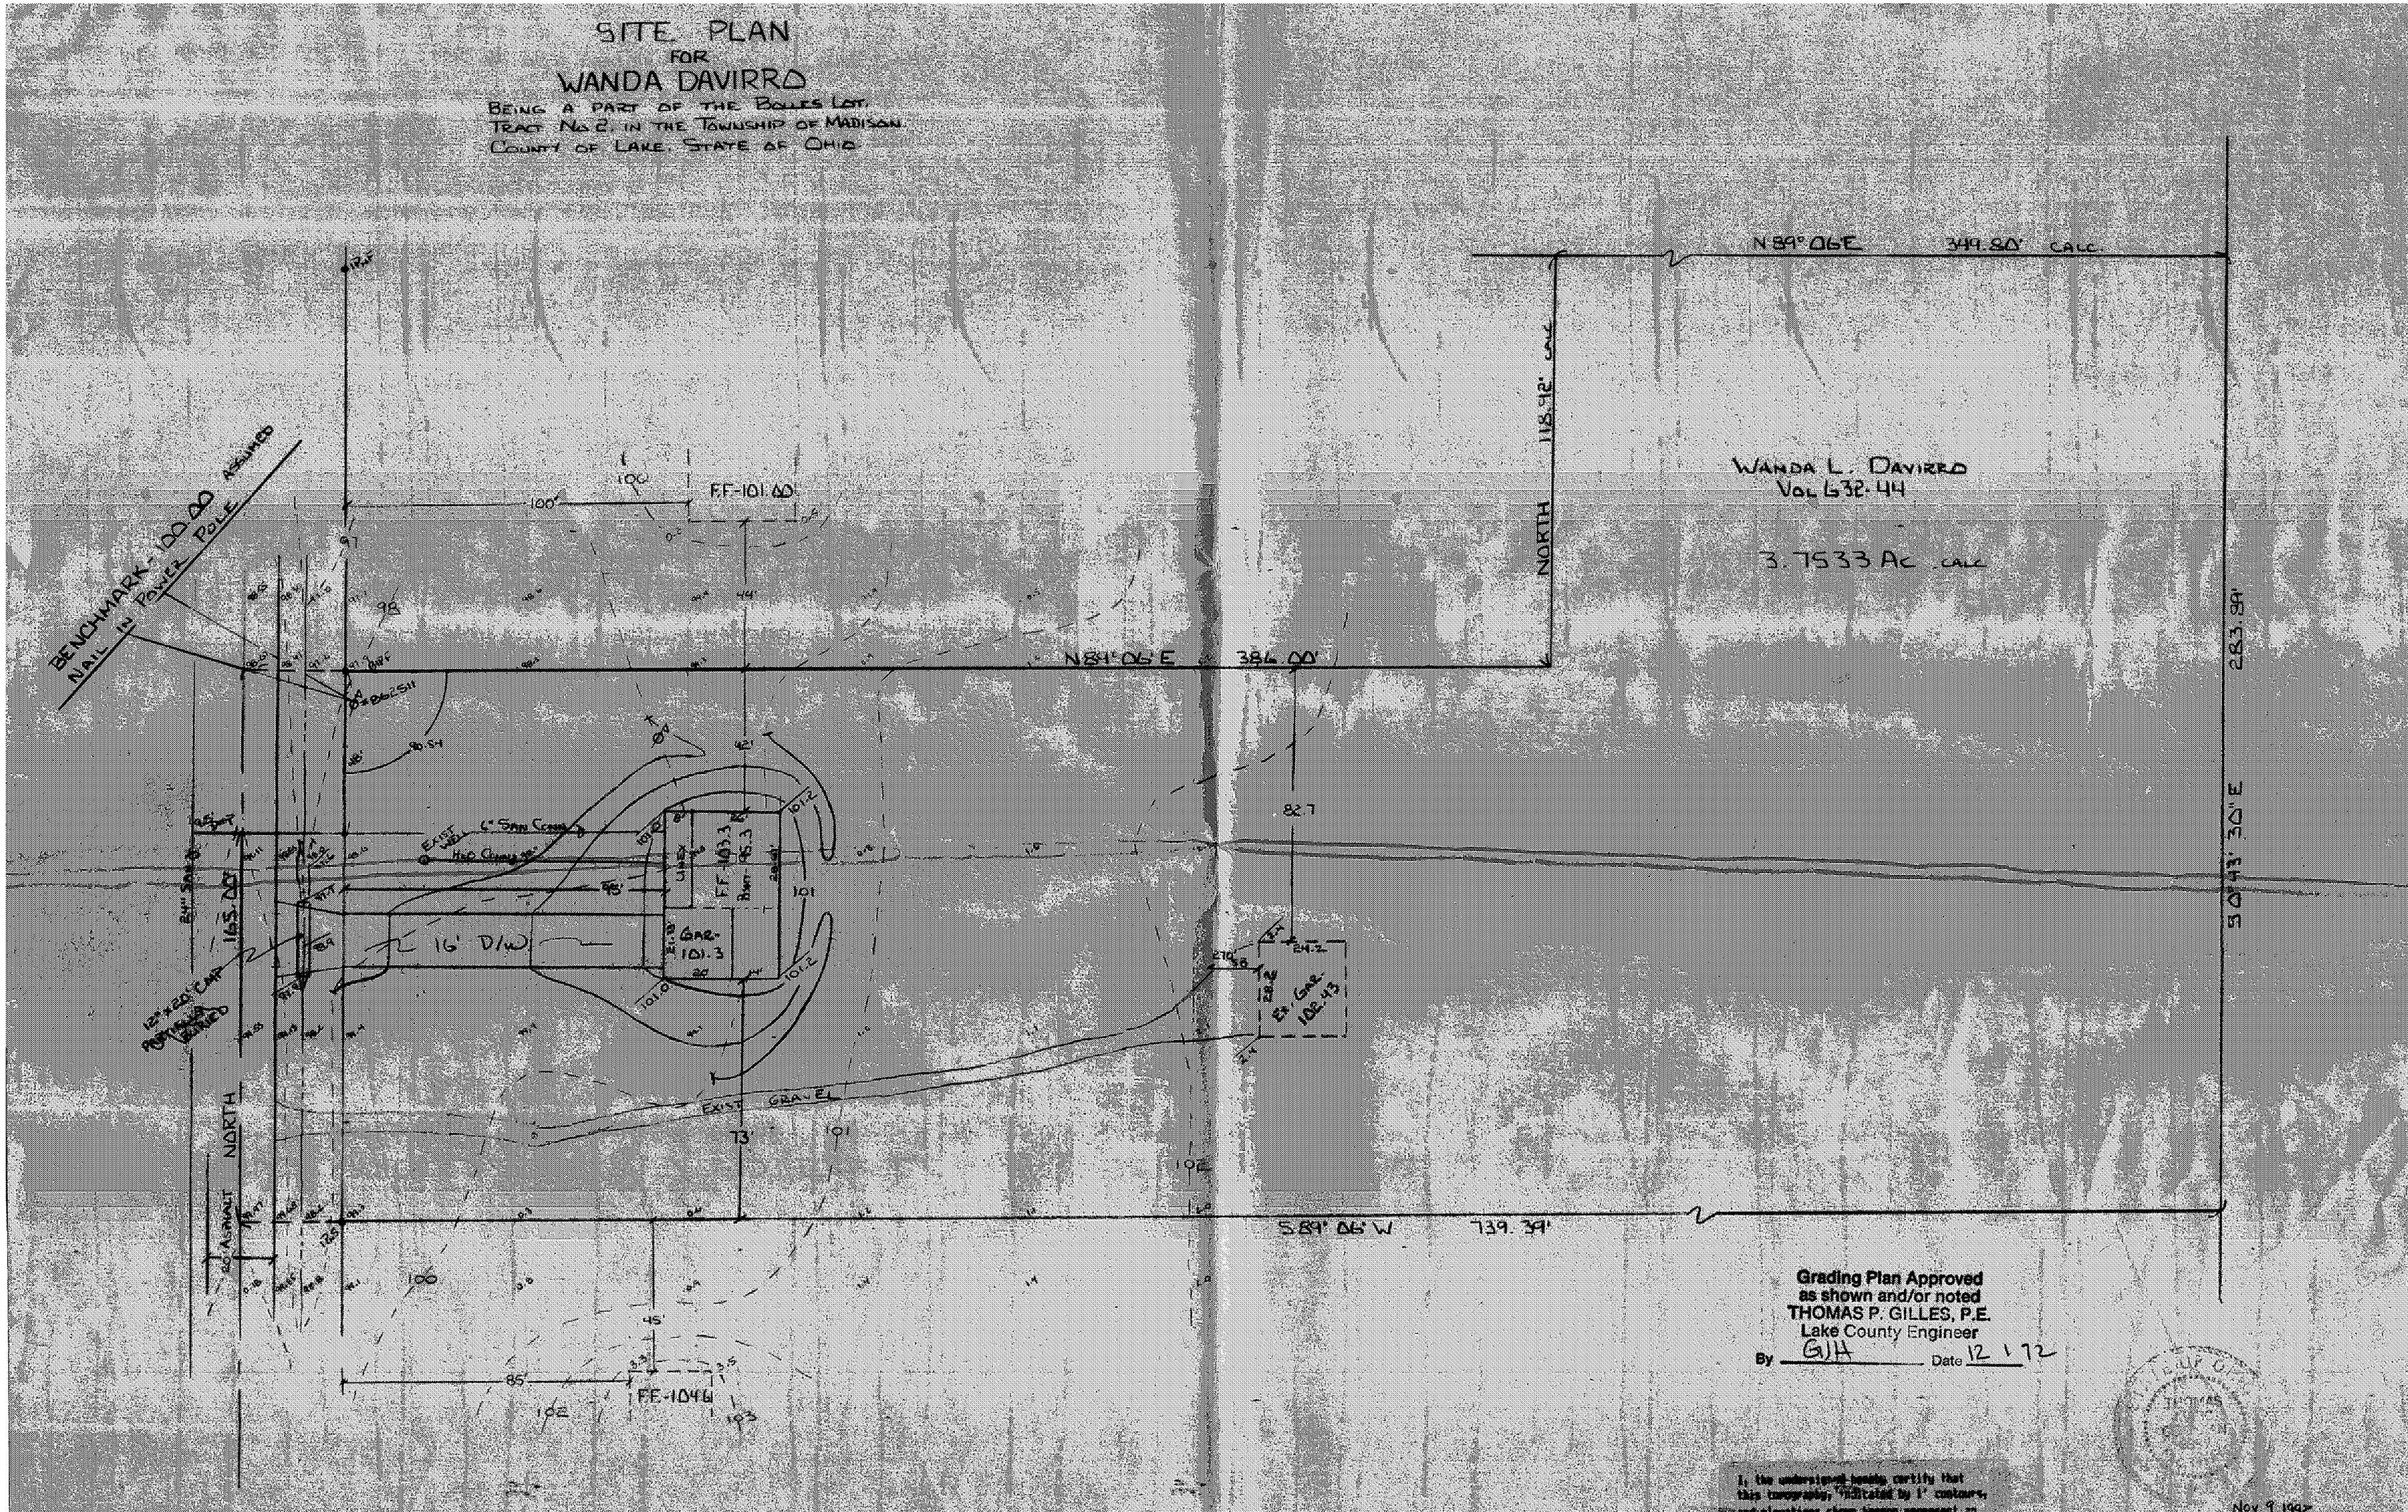

Grading Plan Approved
as shown and/or noted
THOMAS P. GILLES, P.E.
Lake County Engineer
By GJH Date 12 1 92

I, the undersigned, hereby certify that this topography, indicated by 1' contours, and elevations shown hereon represent an actual field survey made by me on OCT. 19, 1992 and that the elevations were taken at approximate intervals and that as of that date they existed as indicated hereon.

J. M. Coffman PS
No. 6651

Nov 9, 1992

APPROVED
MADISON TWP. ZONING
Permit: 13013
Zoning Inspector: OK

VILLAGE SURVEYING Co
202 THIRD ST., FAIRPORT HBR. OH 44077
(216) 357-1359