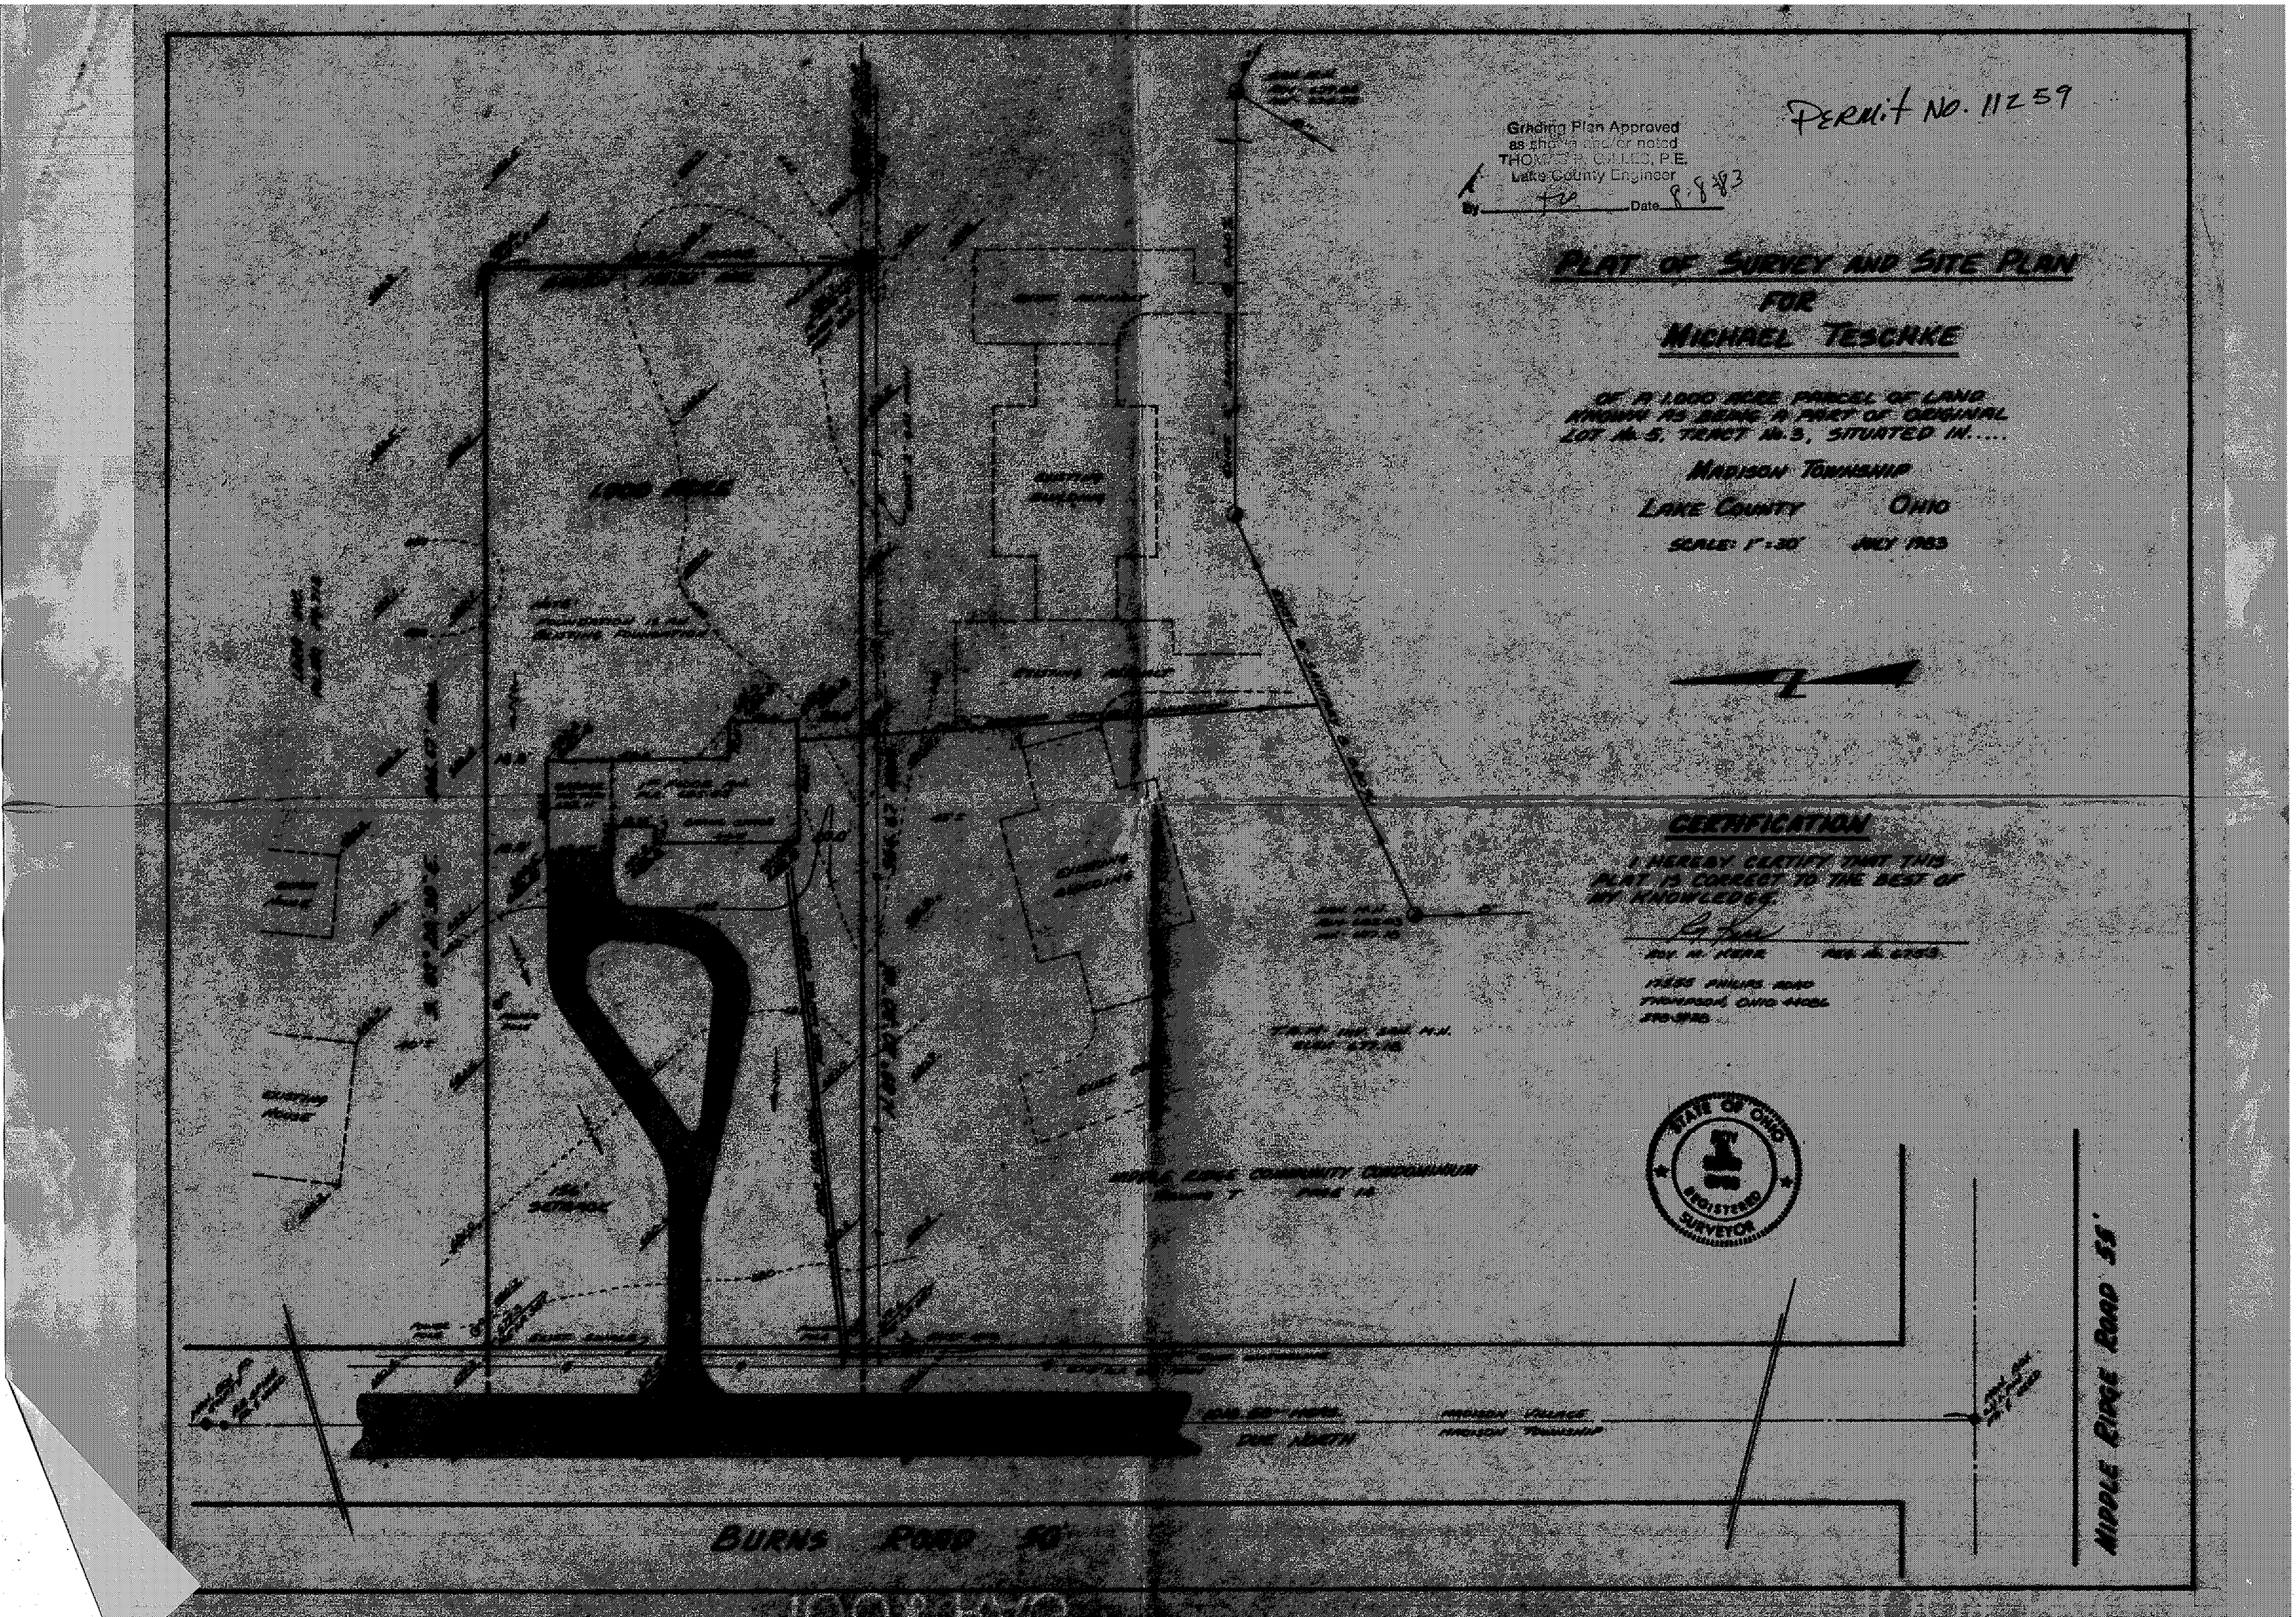
Permit No. 11259
Grading Plan Approved
as shown and/or noted
THOMAS P. GILLES, P.E.
Lake County Engineer
By
Date 8-8-83
PLAT OF SURVEY AND SITE PLAN
FOR
MICHAEL TESCHKE
OF A 1.000 ACRE PARCEL OF LAND
KNOWN AS BEING A PART OF ORIGINAL
LOT No. 5, TRACT No. 3, SITUATED IN....
MADISON TOWNSHIP
LAKE COUNTY OHIO
SCALE: 1"=30'
JULY 1983
CERTIFICATION
I HEREBY CERTIFY THAT THIS
PLAT IS CORRECT TO THE BEST OF
MY KNOWLEDGE.
ROY M. KERR
17555 PHILIPS ROAD
THOMPSON, OHIO 44086
STATE OF OHIO
REGISTERED
SURVEYOR
1.000 ACRE
MIDDLE RIDGE COMMUNITY CONDOMINIUM
DUE NORTH
MADISON VILLAGE
MADISON TOWNSHIP
BURNS ROAD 50'
MIDDLE RIDGE ROAD 55'