GRADING PLAN
FOR
GINGER CONSTR. Co.

S/L 1292 Madison Golf Lakeland

MADISON TWP., LAKE CO. OHIO

SCALE : 1"=20' JUNE 1972

As Built Certification

I Hereby Certify That The Circled Grades Are Existing Finish —

Grades Checked In The Field On _____ 197____

Survey Is Correct to The Best Of My knowledge And Belief —

Fullerton-Kerr & Associates

by _____
REG. SURVEYOR N.

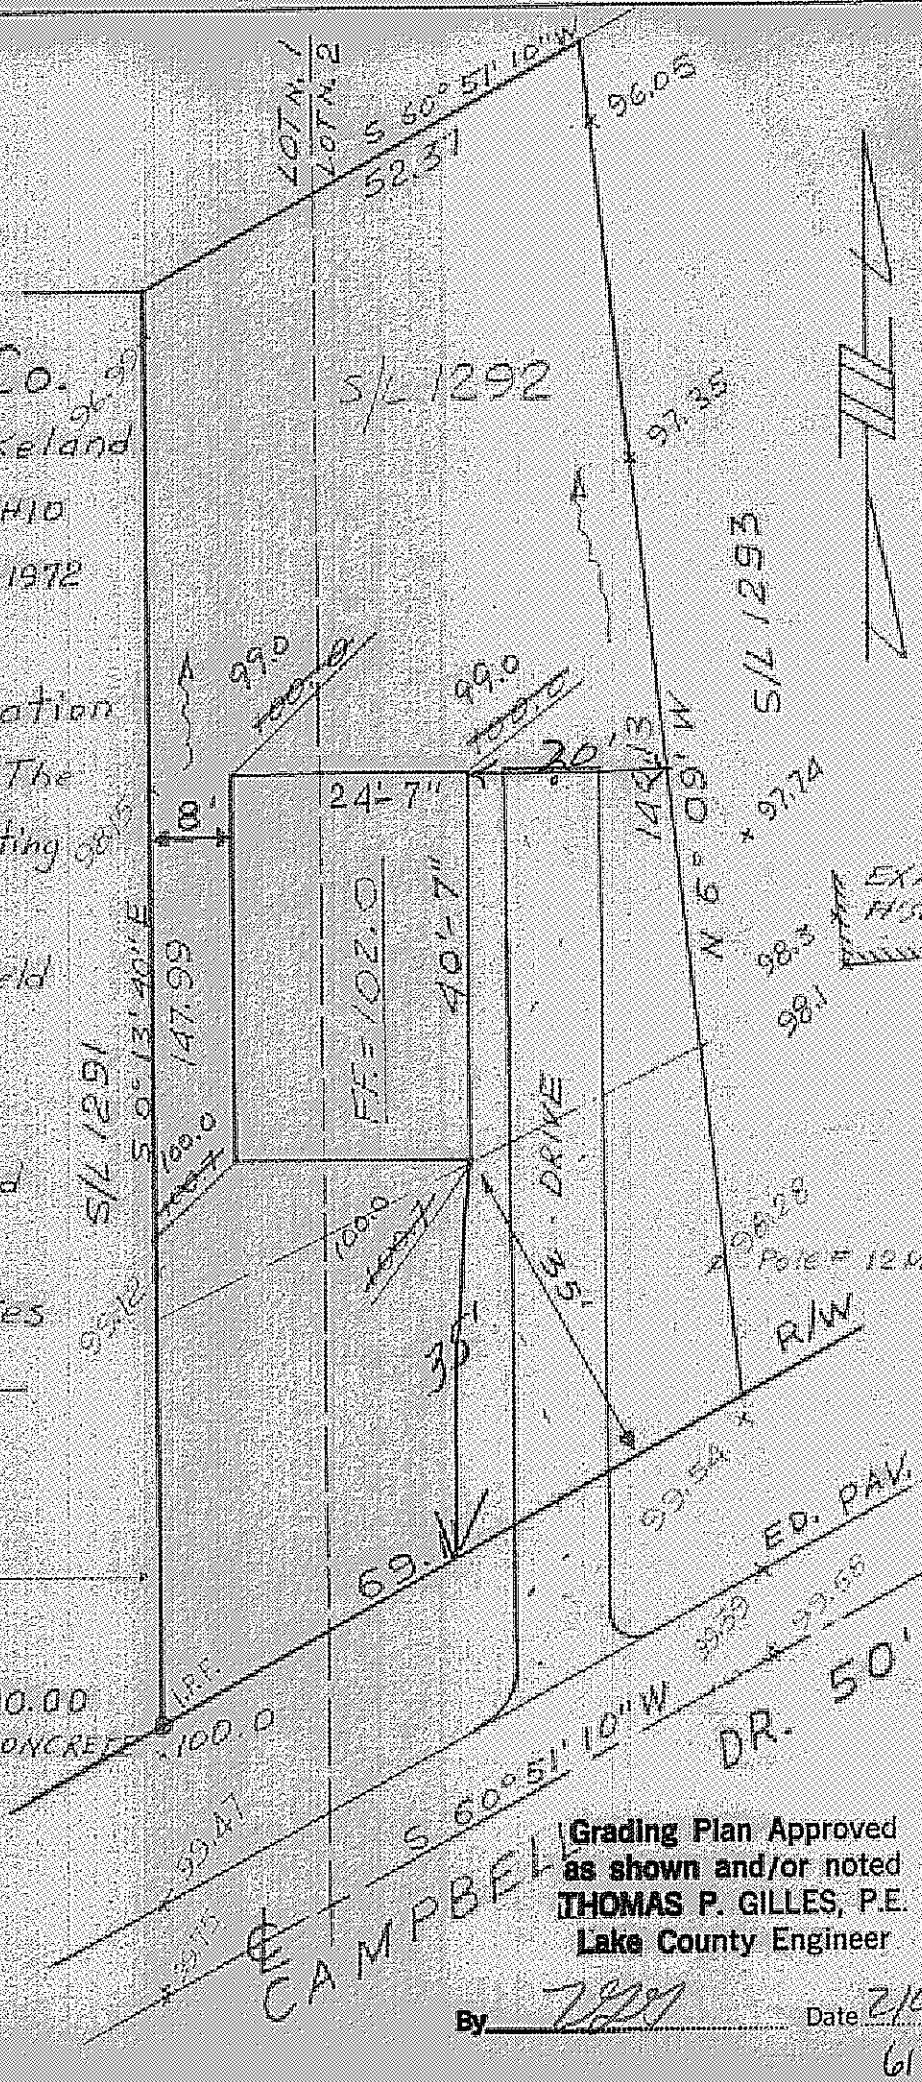

APPROVED
MADISON TWP. ZONING
Permit: 8604
Zoning Inspector: OKB

Grading Plan Approved as shown and/or noted
THOMAS P. GILLES, P.E.
Lake County Engineer

By _____ Date 21 Aug 72

6173