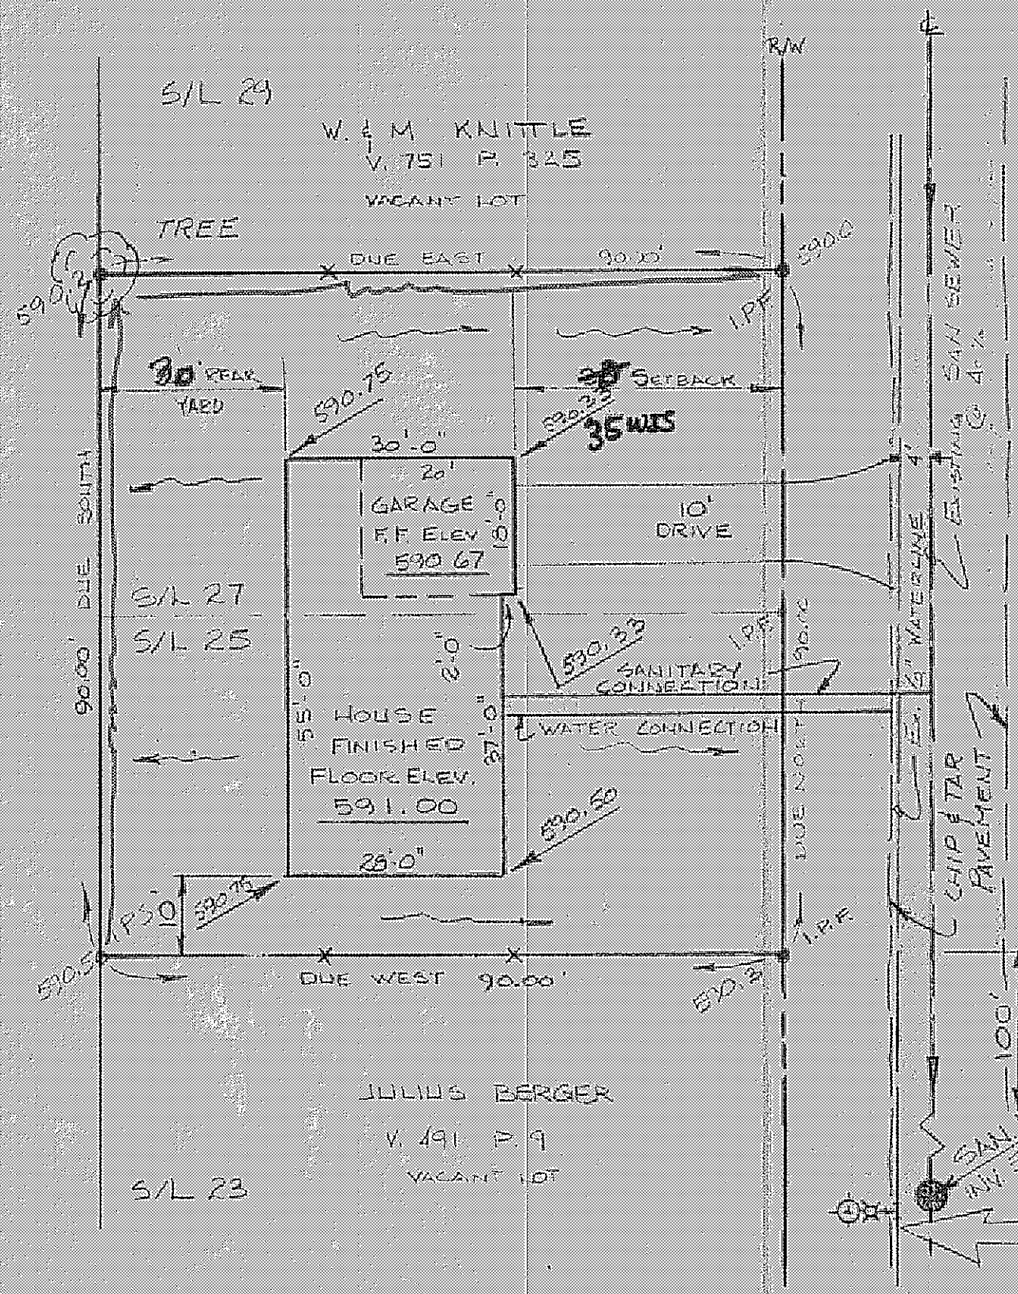

Grading Plan Approved
as shown and/or noted
THOMAS P. GILLES, P.E.
Lake County Engineer
By _____ Date 2 Aug 78

APPROVED
MADISON TWP. ZONING
Permit 1023
Zoning Inspector

NOTES:

LOCATION OF SANITARY WYE TO BE DETERMINED FROM COUNTY SANITARY ENGINEER'S RECORDS.

UNDERLINED ELEVATIONS INDICATE PROPOSED FINISHED GRADES.

* ; INDICATES HUB SET.

AREA IN DOUBLE LOT; 0.186 ACRES

BM: TOP OF FIRE HYDRANT
ELEVATION = 592.19

INDICATES DIRECTION OF RUN-OFF FLOW

DESIGN CERTIFICATION

THIS PLAT WAS PREPARED BY ME AND IS CORRECT TO THE BEST OF MY KNOWLEDGE AND BELIEF.

REG. SURVEYOR NO. 7112

AS BUILT CERTIFICATION

I HEREBY CERTIFY THAT THE CIRCLED GRADES ARE EXISTING FINISH GRADES CHECKED IN THE FIELD ON _____ AND THAT SURVEY IS CORRECT TO THE BEST OF MY KNOWLEDGE AND BELIEF.

REG. SURVEYOR NO. _____

COLPETZER · WOODS
CONSULTANTS, INC.
180 SOUTH STATE STREET • PAINESVILLE, OHIO 44077 • (216) 357-7569
947 MENTOR AVE. • MENTOR, 44060

DATE AUG. 15, '78
SCALE 1" = 20'
DRWN BY JTG.
CHKD BY E
JOB NO 78223
FB 354 PG 42

REVISED SITE PLAN FOR NORTHERN INDUSTRIES

BEING SUBLOTS 26 & 27 IN THE CLOVERLEIGH BEACH RESUBDIVISION, MADISON TWP., LAKE COUNTY, OHIO