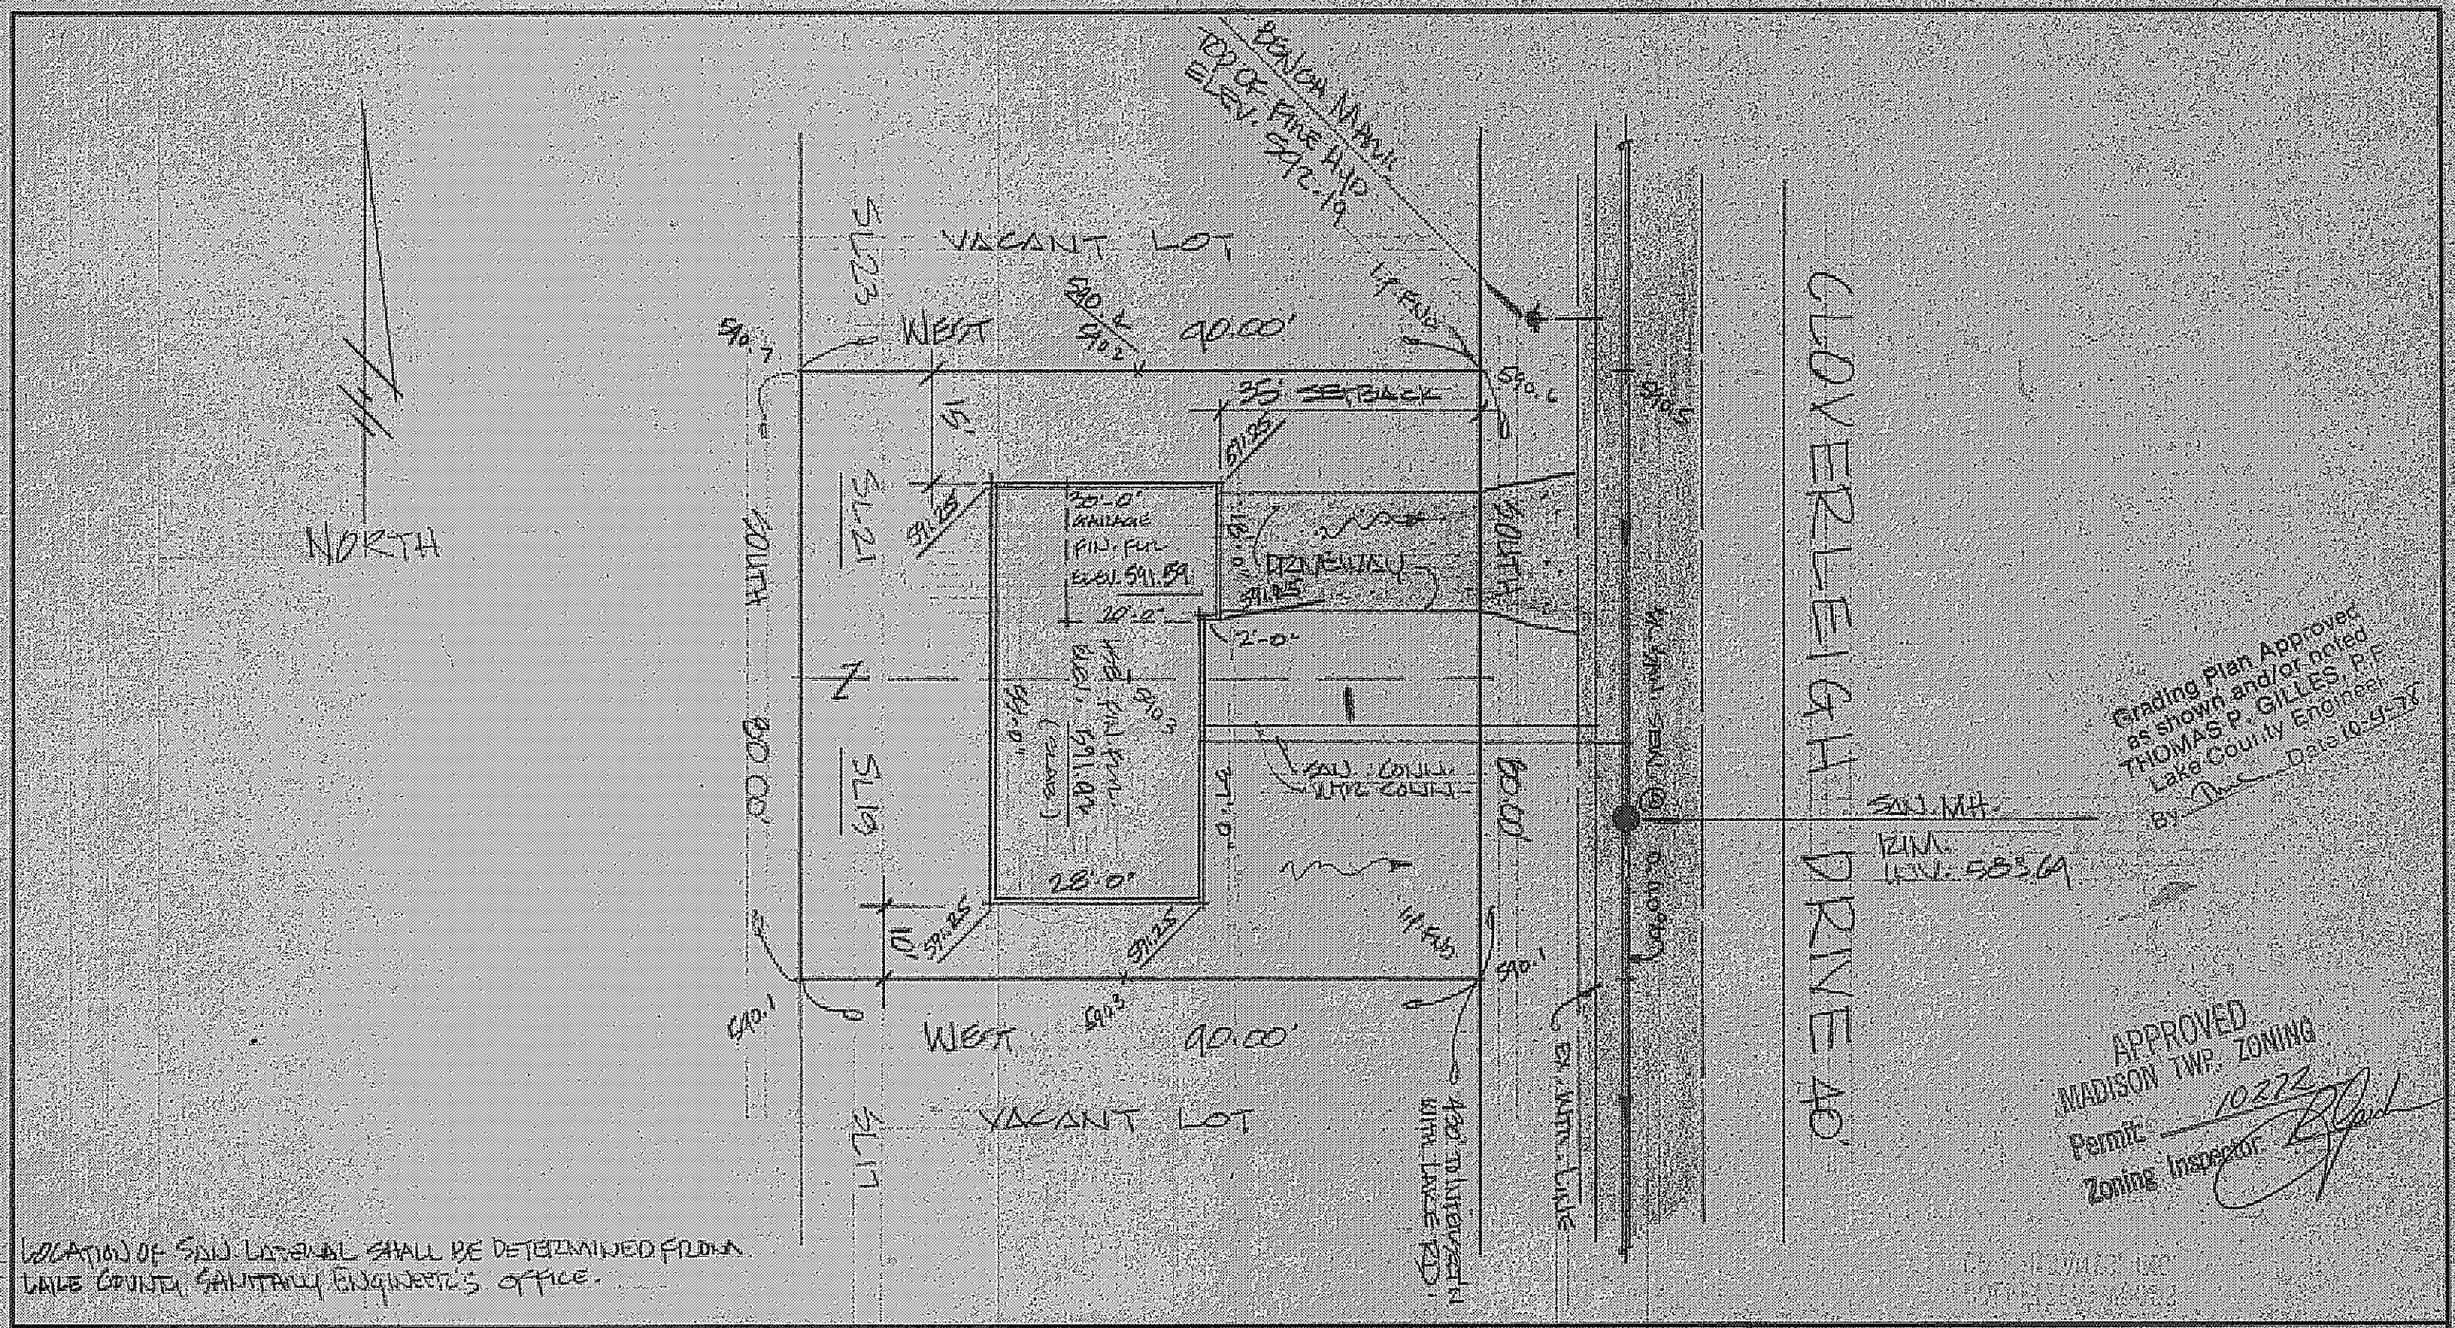

LOCATION OF SAN. LATERAL SHALL BE DETERMINED FROM LAKE COUNTY SANITARY ENGINEER'S OFFICE.

DESIGN CERTIFICATION	AS BUILT CERTIFICATION			
THIS PLAT WAS PREPARED BY ME AND IS CORRECT TO THE BEST OF MY KNOWLEDGE AND BELIEF.	I HEREBY CERTIFY THAT THE CIRCLED GRADES ARE EXISTING FINISH GRADES CHECKED IN THE FIELD ON _____ AND THAT SURVEY IS CORRECT TO THE BEST OF MY KNOWLEDGE AND BELIEF.	COLPETZER · WOODS CONSULTANTS, INC. ~~180 SOUTH STATE STREET • PAINESVILLE, OHIO 44077~~ • (216) 357-7569 9470 MENTOR AVE., MENTOR, OH. 44060	DATE OCT. 2, 1978 SCALE 1"=20' DRWN BY CB CHKD BY JOB NO 78-223 FB 384 PG 42	SITE PLAN FOR: NORTHERN INDUSTRIES BEING SUBLOT NO. 19 & 21 IN THE CLOVERLEIGH RESUBDIVISION IN THE TOWNSHIP OF MADISON, OHIO.
REG. SURVEYOR NO. 4785	REG. SURVEYOR NO. _____			