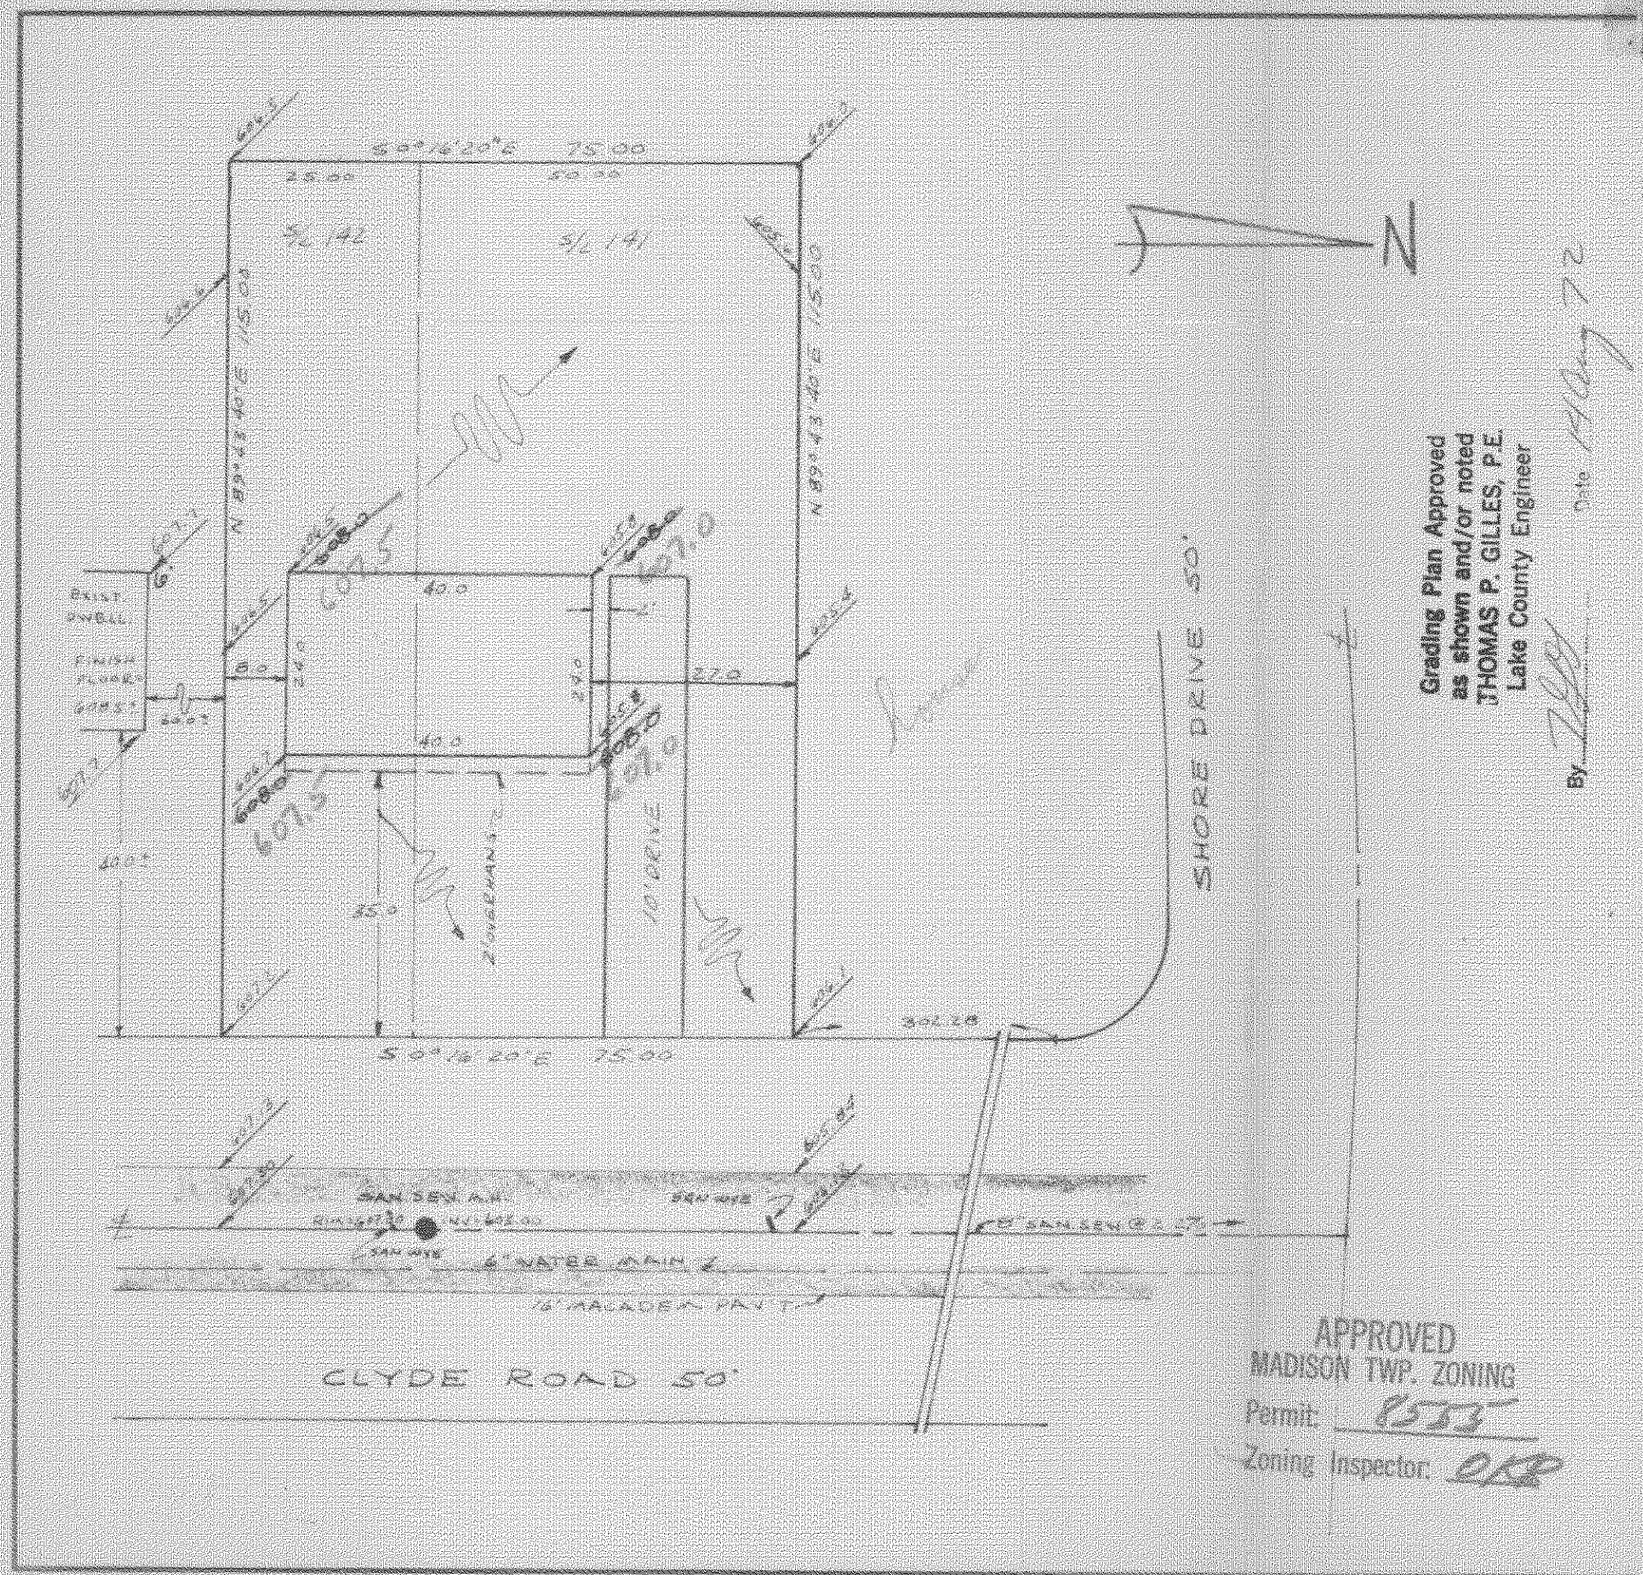

Grading Plan Approved
as shown and/or noted
THOMAS P. GILLES, P.E.
Lake County Engineer

By [signature] Date May 72

APPROVED
MADISON TWP. ZONING
Permit: 8553
Zoning Inspector: OKP

SITE PLAN

MADISON LAKE COUNTY, OHIO
TOWNSHIP

for RYAN HOMES
CLIENT OWNER

1774 Clyde Road Madison 44057
ADDRESS STREET CITY ZIP

MADISON GOLF LAKELAND
RECORD SUBDIVISION
E 68
VOLUME PAGE
141 & 142 CLYDE Rd
SUBLOT NO STREET

LOT TRACT
VOLUME PAGE
PERM PARCEL # STREET

LEGEND

SANITARY MANHOLE
STORM MANHOLE
INLET OR CATCH BASIN
HYDRANT
EXISTING CONTOURS
PROPOSED CONTOURS
EXIST ELEV 100.0 / 100.0 PROP ELEV

WATER VALVE (GAS)
WATER METER (GAS)
AS BUILT ELEVATION
DIRECTION OF SURFACE DRAINAGE

REMARKS

ALL BOUNDARY DATA SHOWN WAS OBTAINED FROM (DEEDS RECORDED SUBDIVISION PLAT OR OTHER PUBLIC RECORDS)

DESIGN CERTIFICATION

THIS PLAT WAS PREPARED BY ME, AND IS CORRECT TO THE BEST OF MY KNOWLEDGE AND BELIEF

Richard R. Hegfield P.S. # 5506
NAME SURVEYOR REGISTRATION NO.

CHECK LIST

DIMENSIONS
BEARINGS
TIE TO NEAREST STREET
SUBLOT NO PARCEL NO
SURROUNDING OWNERS
BLDG DIMENSIONS FIN GR
BLDG TIES FLR GRADES
APRON TYPE WIDTH THICKNESS
SIDEWALK TYPE WIDTH THICKNESS
CULVERT TYPE DIA LENGTH

WATER MAIN SIZE LOCATION
SAN SEWER SIZE % GR LOC
SAN MH CAST ELEV INV ELEV
SAN CONN SIZE LOC DEPTH
STORM SEWER SIZE % GR LOC
STORM MH CAST ELEV INV ELEV
PAVT TYPE GRADE CURBS
GAS LINE LOC SIZE PRESSURE
SEPTIC TANK SIZE LOC
WELL LOCATION

RIVISIONS		
NO.	DATE	BY
1		
2		
3		
4		

PLAN PREPARED BY

DEBEVEC-SALO & ASSOC, INC.
NAME
130 E JACKSON ST PAINESVILLE, O.
ADDRESS

DRAWN BY SWARTZ	SCALE 1" = 20'	PHONE NO
CHK'D R.H.	DATE 6-20-72	DRAWING NO 3528
CREW CHIEF	APP'D	