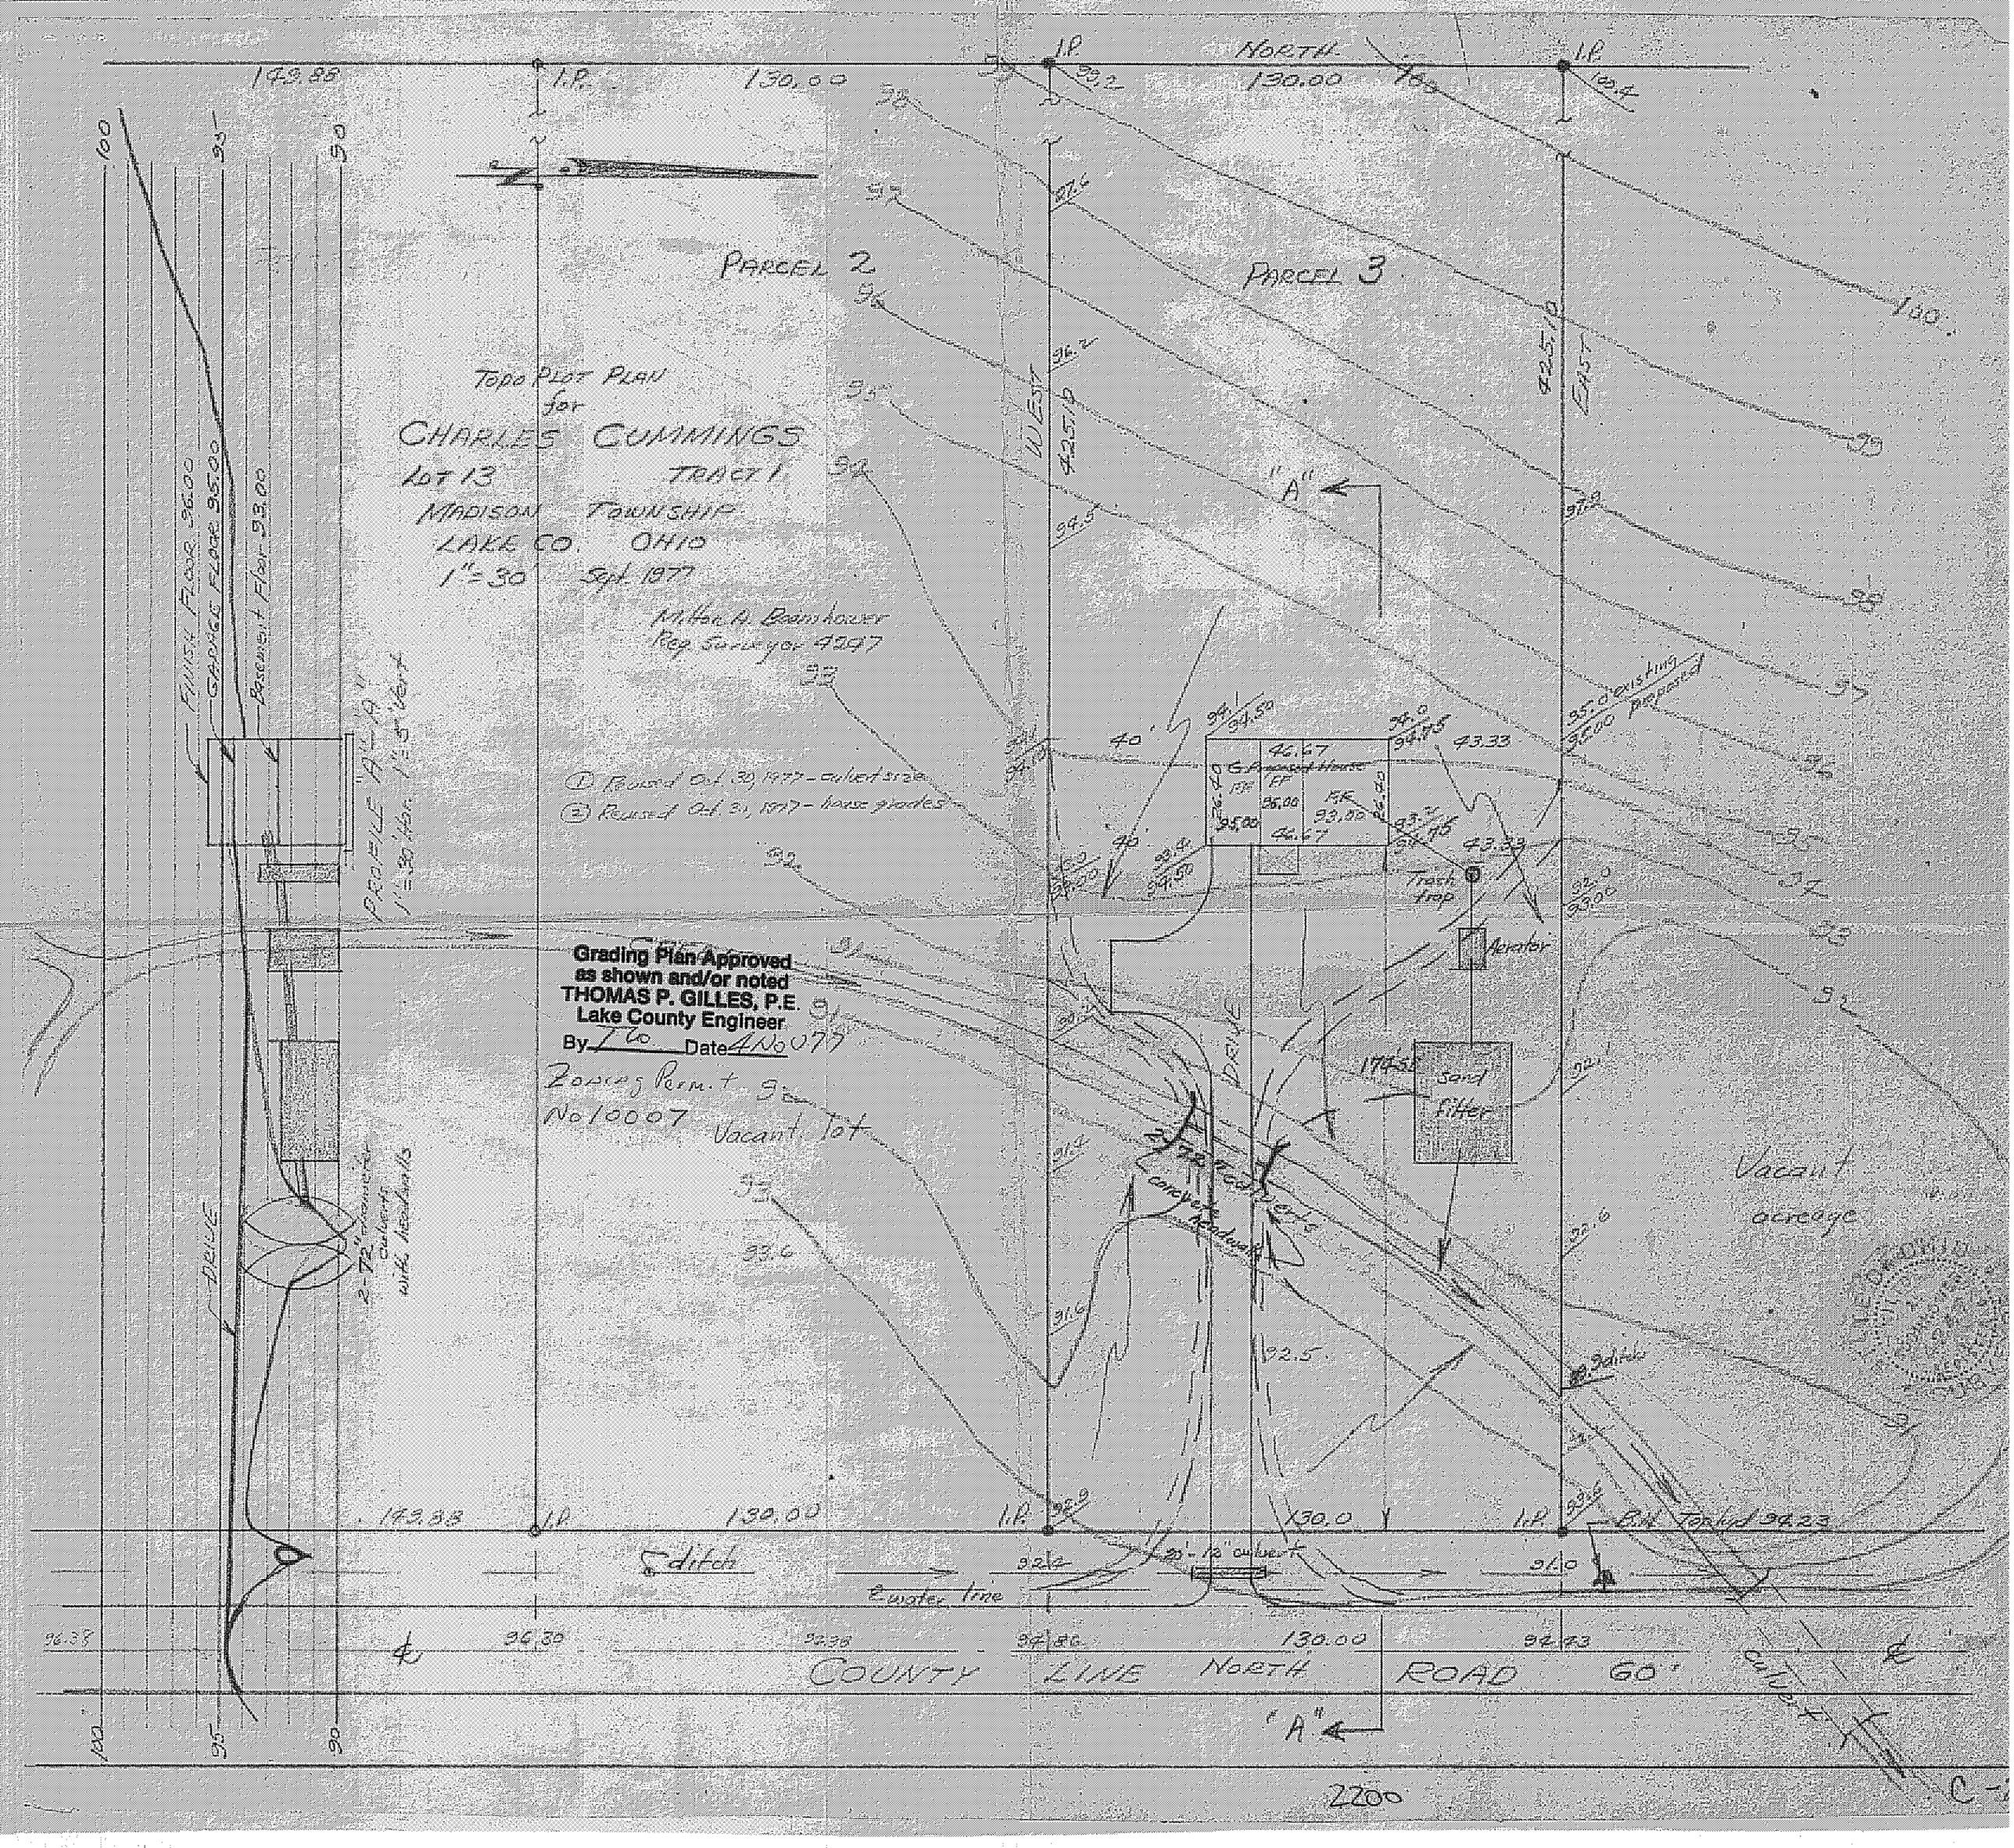

Topo Plot Plan
for
CHARLES CUMMINGS
Lot 13 Tract 1
Madison Township
Lake Co. Ohio
1" = 30' Sept. 1977
Milton A. Boomhower
Reg. Surveyor 4297
① Revised Oct. 30, 1977 - culvert size
② Revised Oct. 31, 1977 - house grades
Grading Plan Approved
as shown and/or noted
THOMAS P. GILLES, P.E.
Lake County Engineer
By TG Date 4 Nov 77
Zoning Permit
No 10007
Vacant lot
Parcel 2
Parcel 3
North
West
East
Finish Floor 96.00
Garage Floor 95.00
Basement Floor 93.00
Profile "A"-"A"
1" = 30' Hor. 1" = 5' Vert
Drive
2-72" diameter culverts with headwalls
Trash trap
Aerator
Sand filter
Vacant acreage
Ditch
Water line
Culvert
County Line North Road 60'
"A"
2200