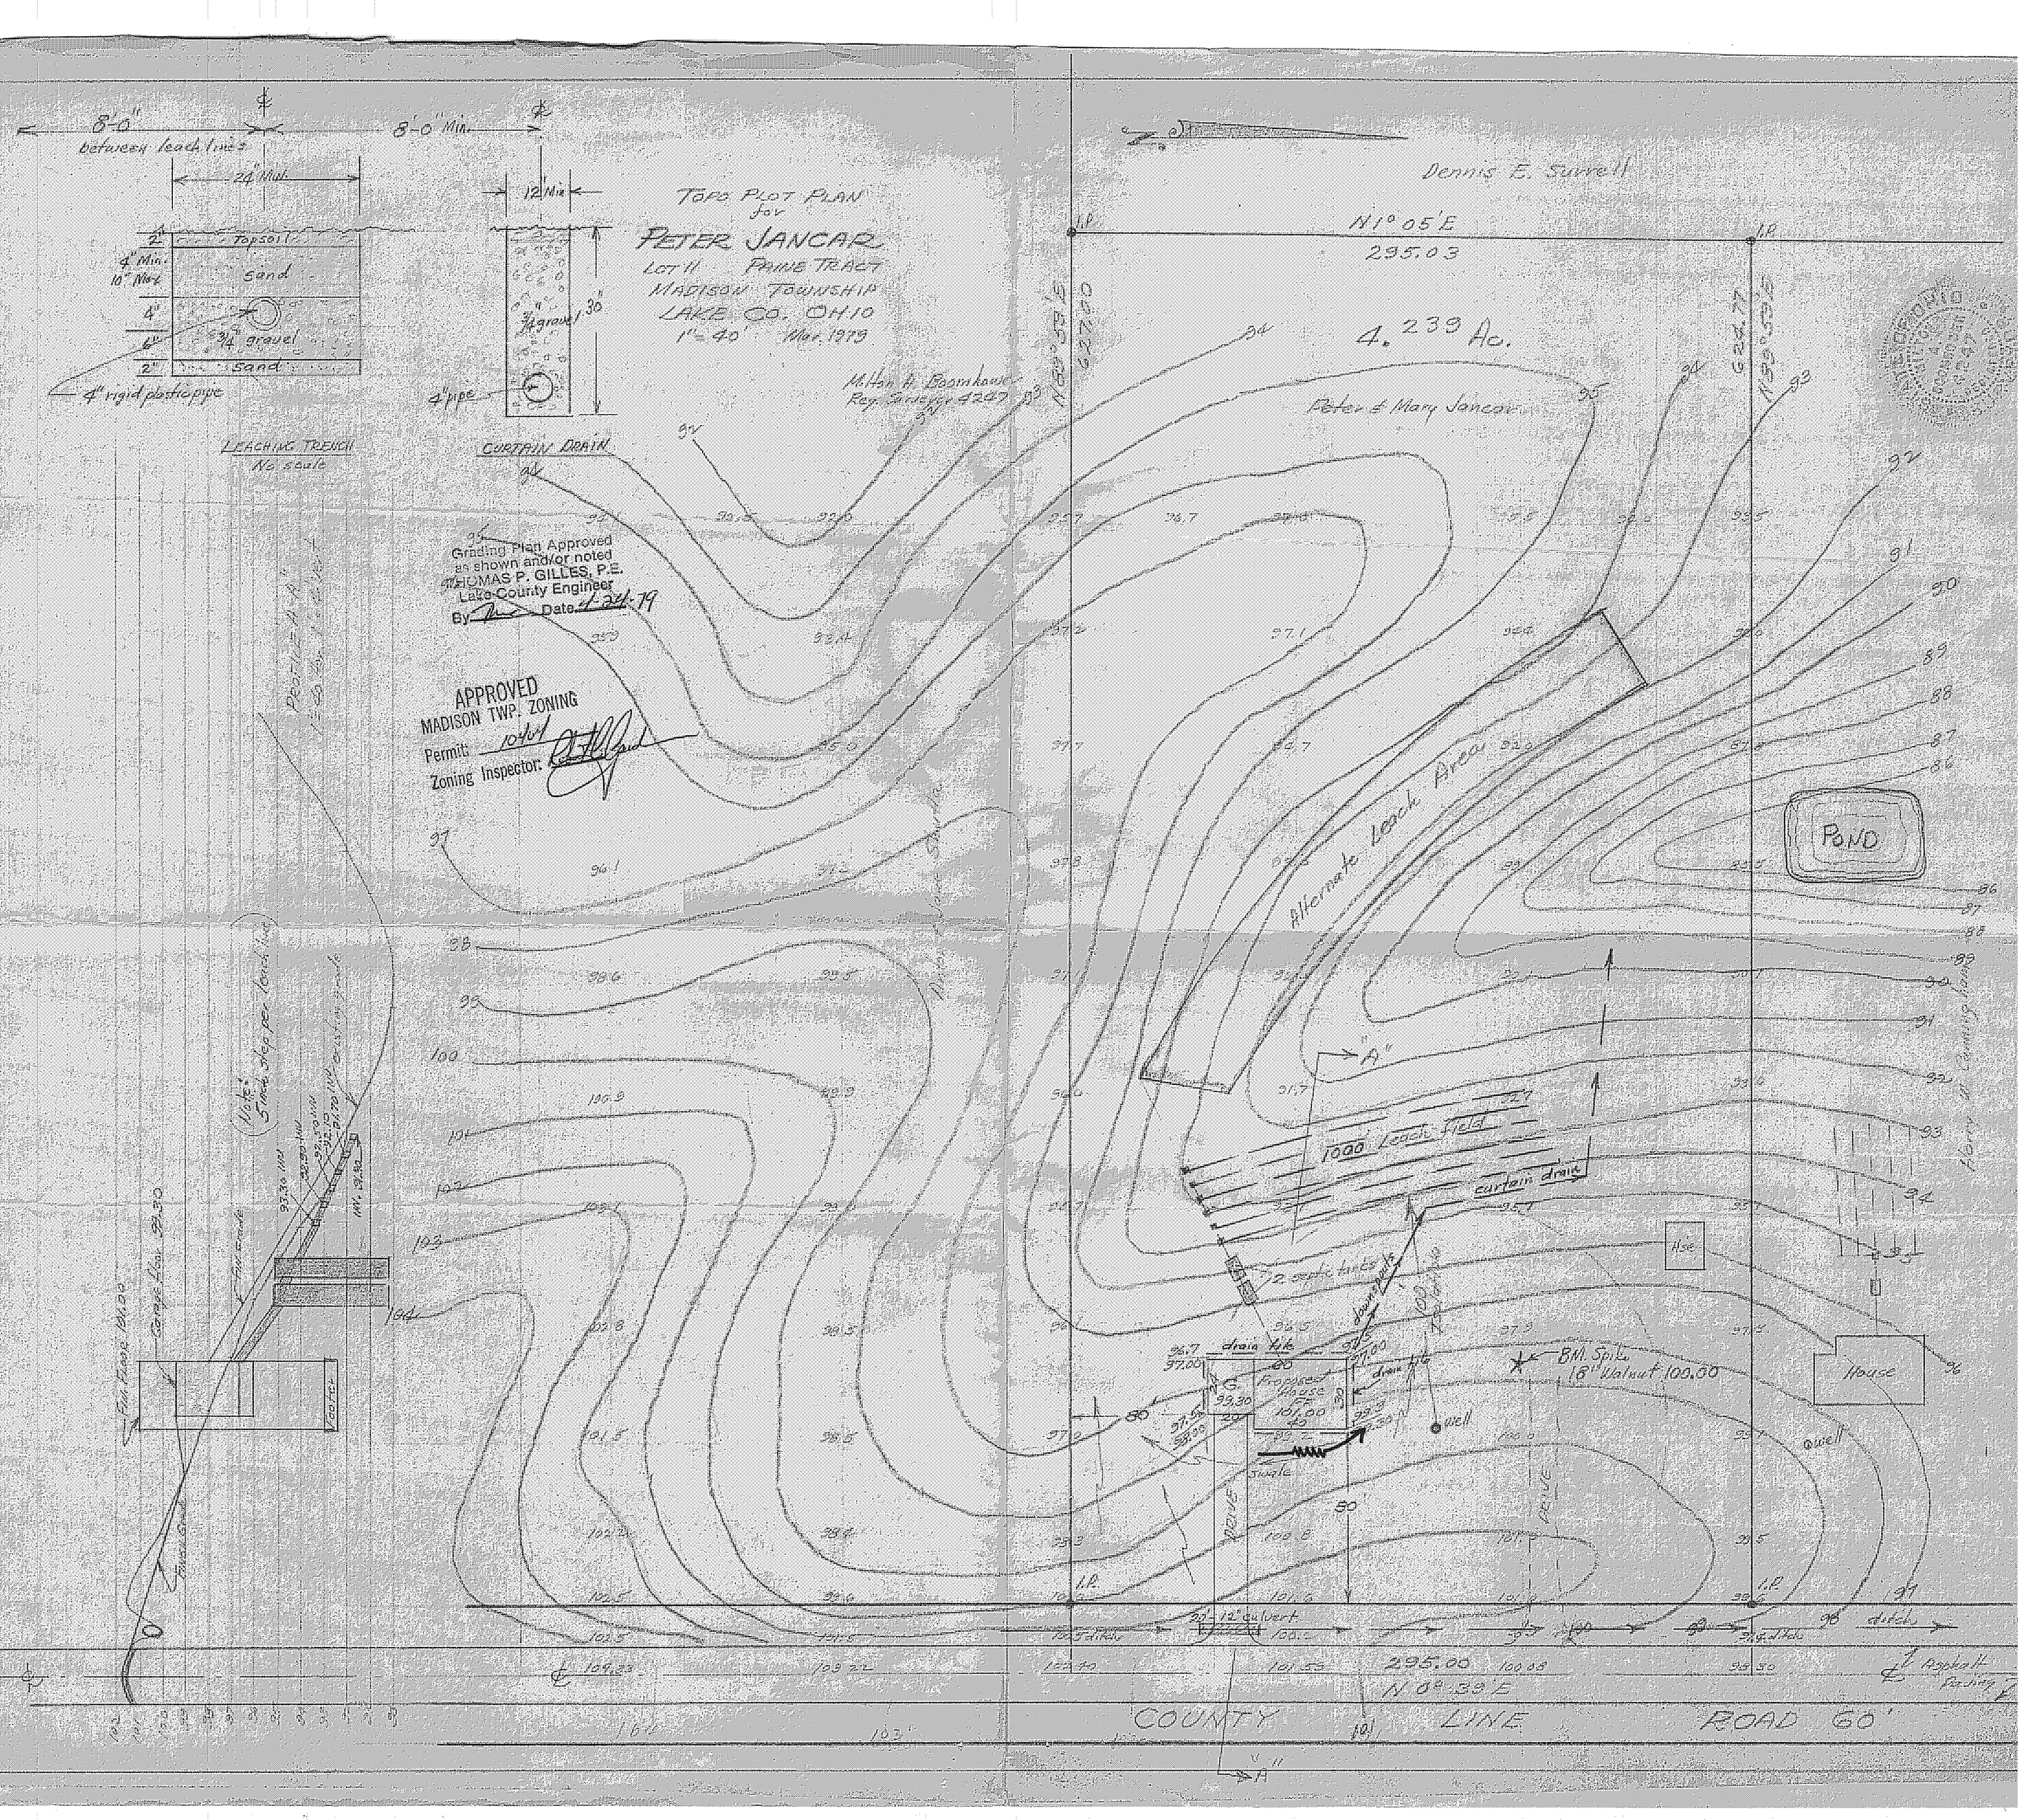

TOPO PLOT PLAN
for
PETER JANCAR
LOT 11 PAINE TRACT
MADISON TOWNSHIP
LAKE CO. OHIO
1"=40' Mar. 1979
8'-0" between leach lines
8'-0" Min.
24" Min.
12" Min.
Topsoil
Sand
3/4" gravel
4" rigid plastic pipe
4" pipe
LEACHING TRENCH
No scale
CURTAIN DRAIN
Milton A. Boomhouse
Reg. Surveyor 4247
Dennis E. Surrell
N1° 05'E
295.03
4.239 Ac.
Peter & Mary Jancar
Grading Plan Approved
as shown and/or noted
THOMAS P. GILLES, P.E.
Lake County Engineer
By
Date 4-24-79
APPROVED
MADISON TWP. ZONING
Permit
Zoning Inspector
Alternate Leach Area
POND
1000 Leach Field
curtain drain
2 septic tanks
drain tile
BM. Spike
18" Walnut 100.00
House
well
Garage Floor 99.30
Fin. Floor 101.00
Footer
12" culvert
295.00
N 0° 39'E
COUNTY LINE ROAD 60'