Grading Plan Approved
as shown and/or noted
THOMAS P. GILLES, P.E.
Lake County Engineer
By _____ Date 20 Oct 72

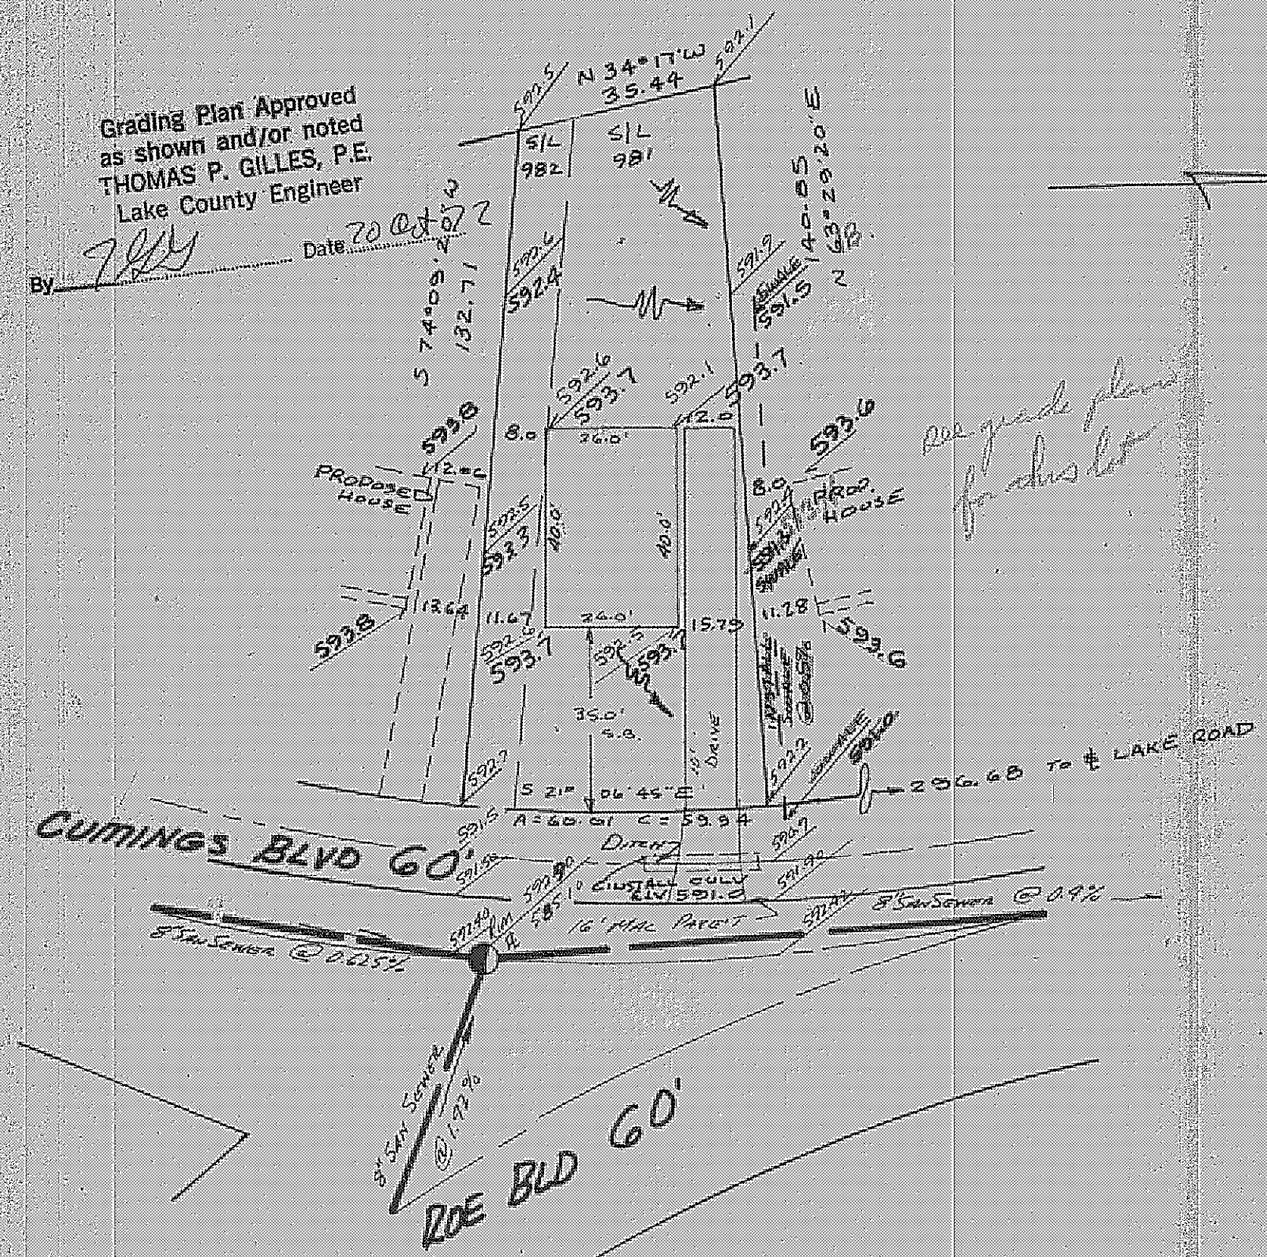

"AS BUILT" CERTIFICATION

I, HEREBY CERTIFY THAT THE CIRCLED GRADES ARE EXISTING FINISH GRADES CHECKED IN FIELD ON _____ 19__ BY _____ SURVEYING AND ARE CORRECT TO THE BEST OF MY KNOWLEDGE AND BELIEF

REGISTERED SURVEYOR _____ NO.

APPROVED
MADISON TWP. ZONING
Permit: 8574
Zoning Inspector: DKB

SITE PLAN

MADISON (TOWNSHIP) LAKE COUNTY, OHIO

for RYAN HOMES (CLIENT OWNER)

ADDRESS STREET CITY ZIP

CUMINGS BEACH PARK — RECORD SUBDIVISION
F — VOLUME
49 — PAGE
981-982 — SUBLOT NO
CUMING BLVD — STREET

LOT — TRACT
VOLUME — PAGE
PERM PARCEL # — STREET

LEGEND

SANITARY MANHOLE
STORM MANHOLE
INLET OR CATCH BASIN
HYDRANT
EXISTING CONTOURS
PROPOSED CONTOURS
EXIST. ELEV 100.0
100.0 PROP. ELEV.

WATER VALVE (GAS)
WATER METER (GAS)
AS BUILT ELEVATION
DIRECTION OF SURFACE DRAINAGE

REMARKS

ALL BOUNDARY DATA SHOWN WAS OBTAINED FROM (DEEDS RECORDED SUBDIVISION PLAT, OR OTHER PUBLIC RECORDS)

DESIGN CERTIFICATION

THIS PLAT WAS PREPARED BY ME, AND IS CORRECT TO THE BEST OF MY KNOWLEDGE AND BELIEF

Richard R. Neufeld PS #5506
NAME SURVEYOR REGISTRATION NO.

CHECK LIST

DIMENSIONS
BEARINGS
TIE TO NEAREST STREET
SUBLOT NO PARCEL NO
SURROUNDING OWNERS
BLDG DIMENSIONS FIN GR
BLDG TIES FLR GRADES
APRON TYPE WIDTH THICKNESS
SIDEWALK TYPE WIDTH THICKNESS
CULVERT TYPE DIA LENGTH

WATER MAIN SIZE LOCATION
SAN SEWER SIZE % GR LOC
SAN MH CAST ELEV INV ELEV
SAN CONN SIZE LOC DEPTH
STORM SEWER SIZE % GR LOC
STORM MH CAST ELEV INV ELEV
PAVT TYPE GRADE CURBS
GAS LINE LOC SIZE PRESSURE
SEPTIC TANK SIZE LOC
WELL LOCATION

REVISIONS		
NO	DATE	BY
1	8/9/72	RJB
2		
3		
4		
5		

PLAN PREPARED BY:
DEBEVEC-SALO & ASSOC, INC.
CIVIL ENGINEERS - SURVEYORS NAME
130 E. JACKSON ST PAINESVILLE, O.
ADDRESS

DRAWN BY Swartz	SCALE 1"=20'	PHONE NO.
CHK'D R.H.	DATE 6-21-72	DRAWING NO 3528
CREW CHIEF	APP'D	