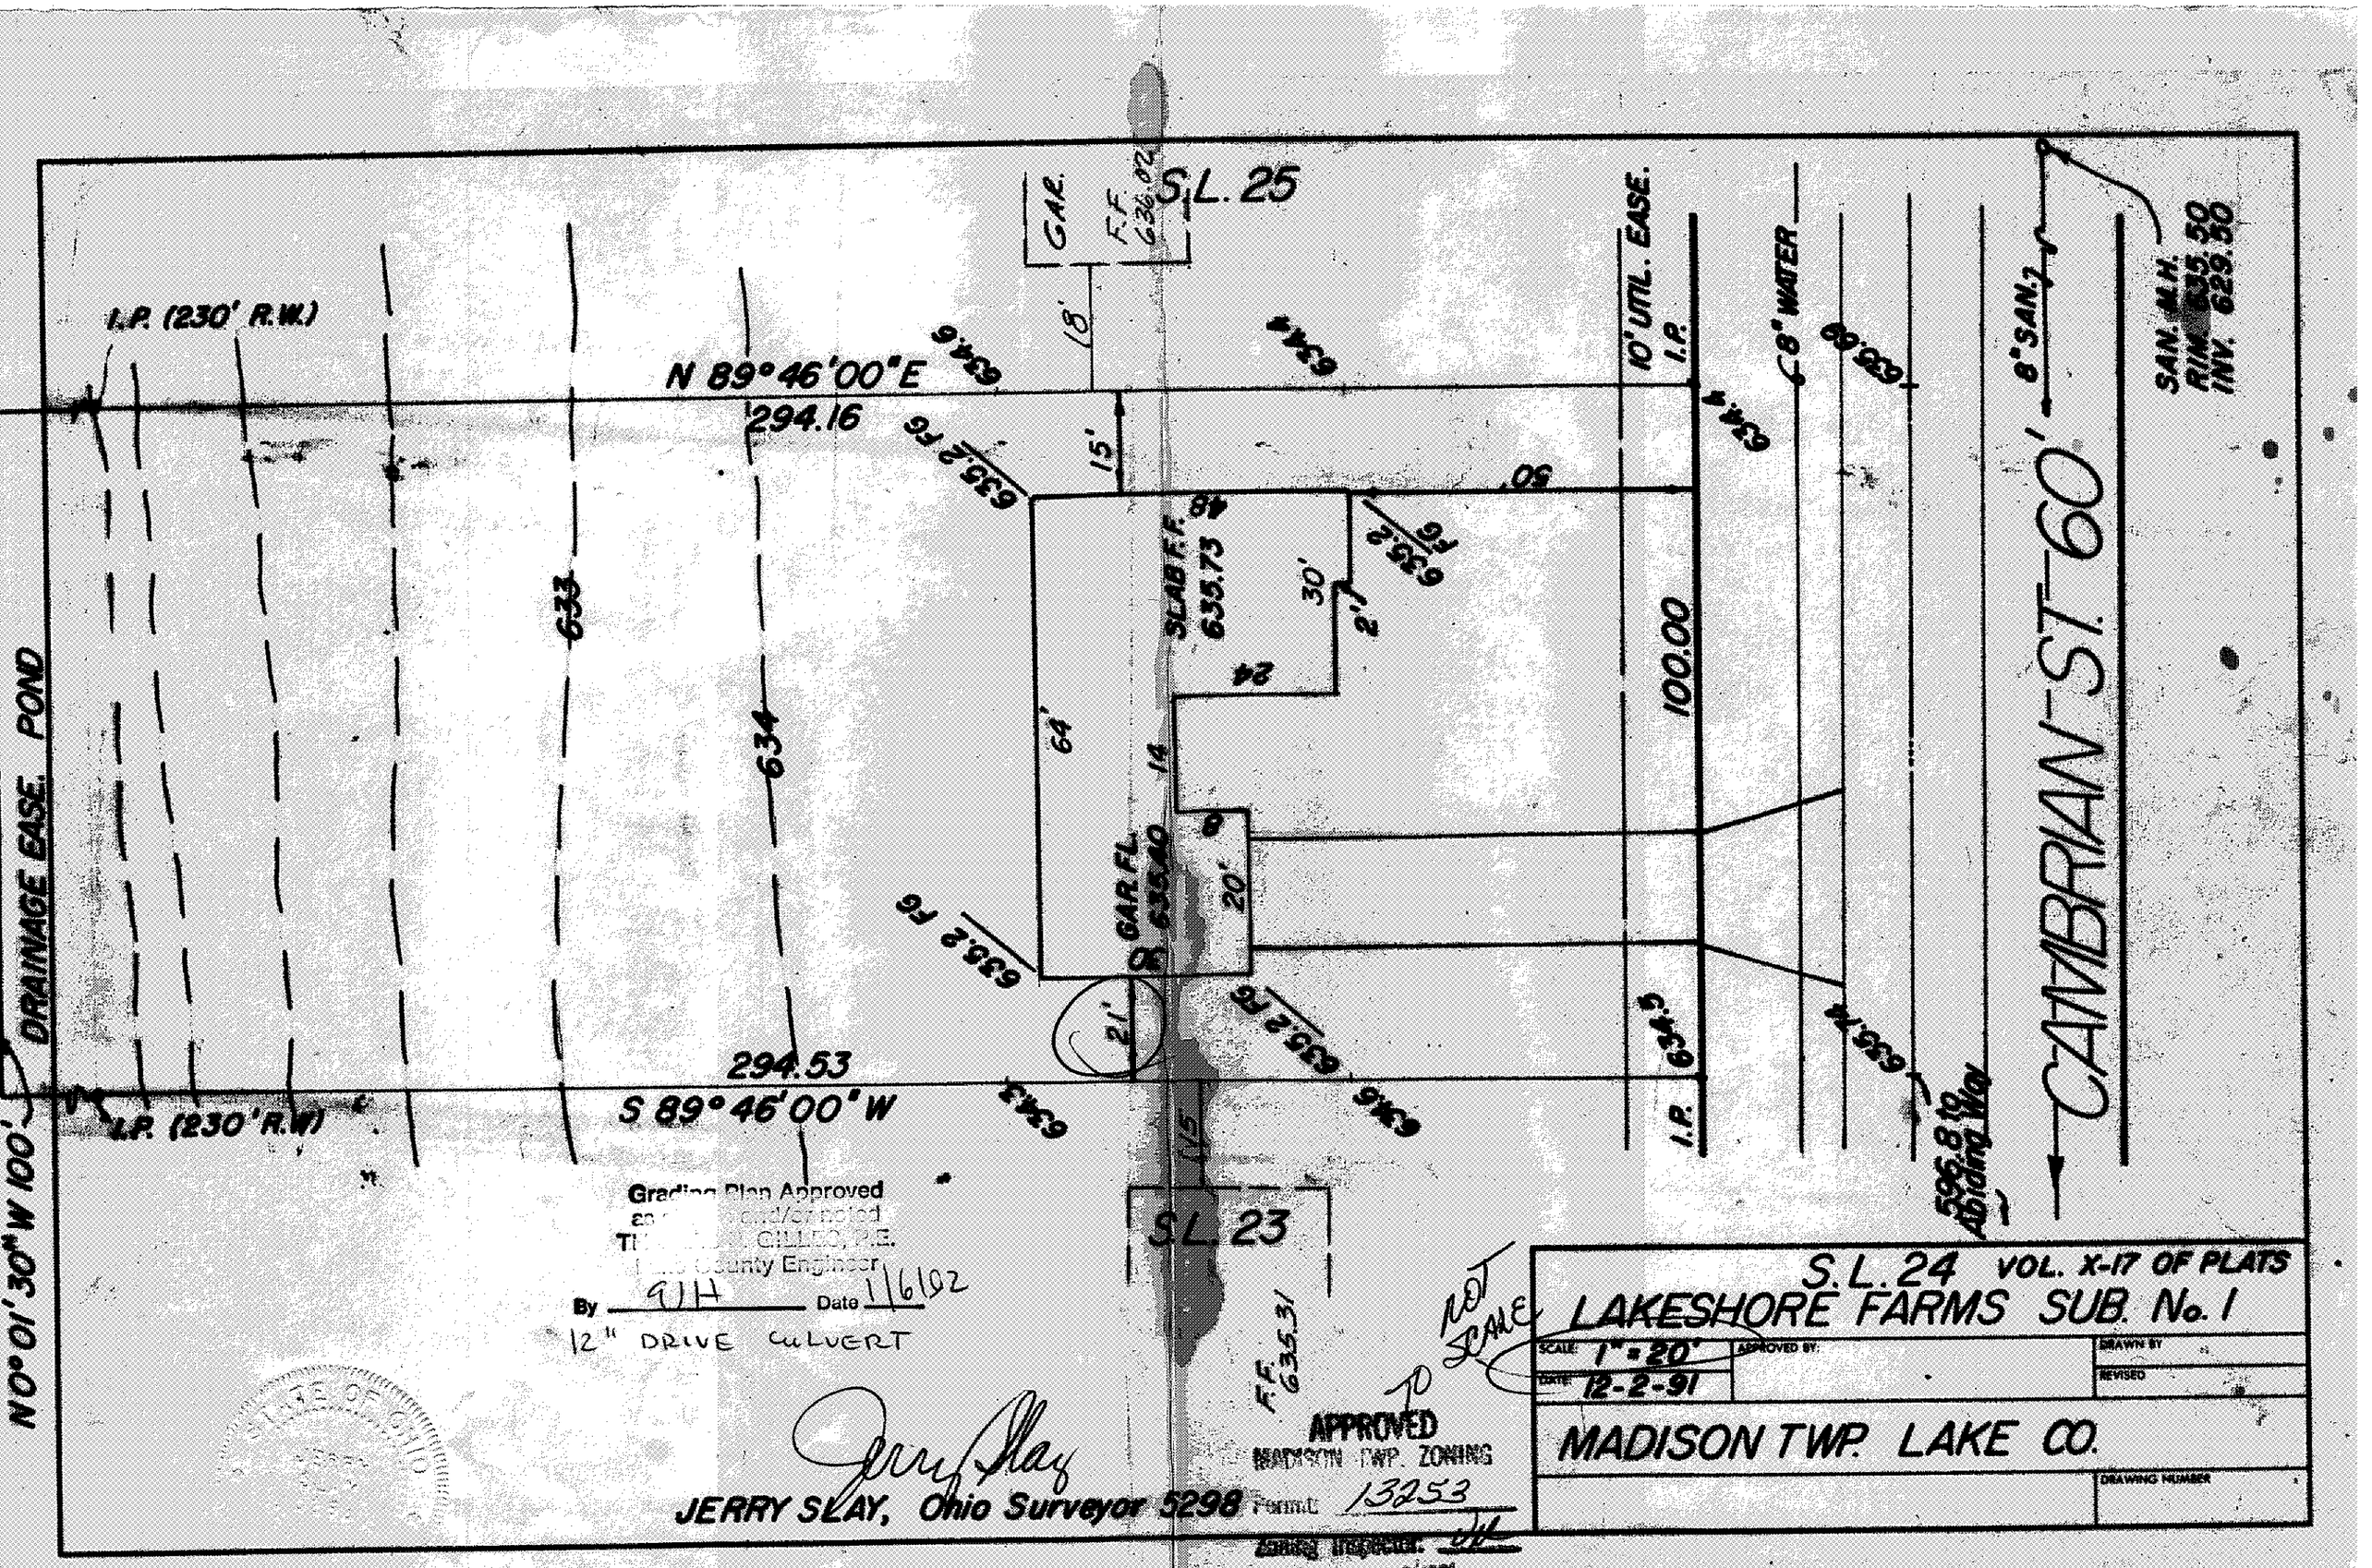

Grading Plan Approved
as [illegible] and/or noted
T[illegible] GILLES, P.E.
[illegible] County Engineer
By [illegible] Date 1/6/92
12" DRIVE CULVERT

JERRY SLAY, Ohio Surveyor 5298

APPROVED
MADISON TWP. ZONING
Permit 13253
Zoning Inspector: [illegible]
DEC. 30 1991

S.L. 24 VOL. X-17 OF PLATS
LAKESHORE FARMS SUB. No. 1

SCALE: 1" = 20'	APPROVED BY:	DRAWN BY
DATE: 12-2-91		REVISED

MADISON TWP. LAKE CO.

DRAWING NUMBER