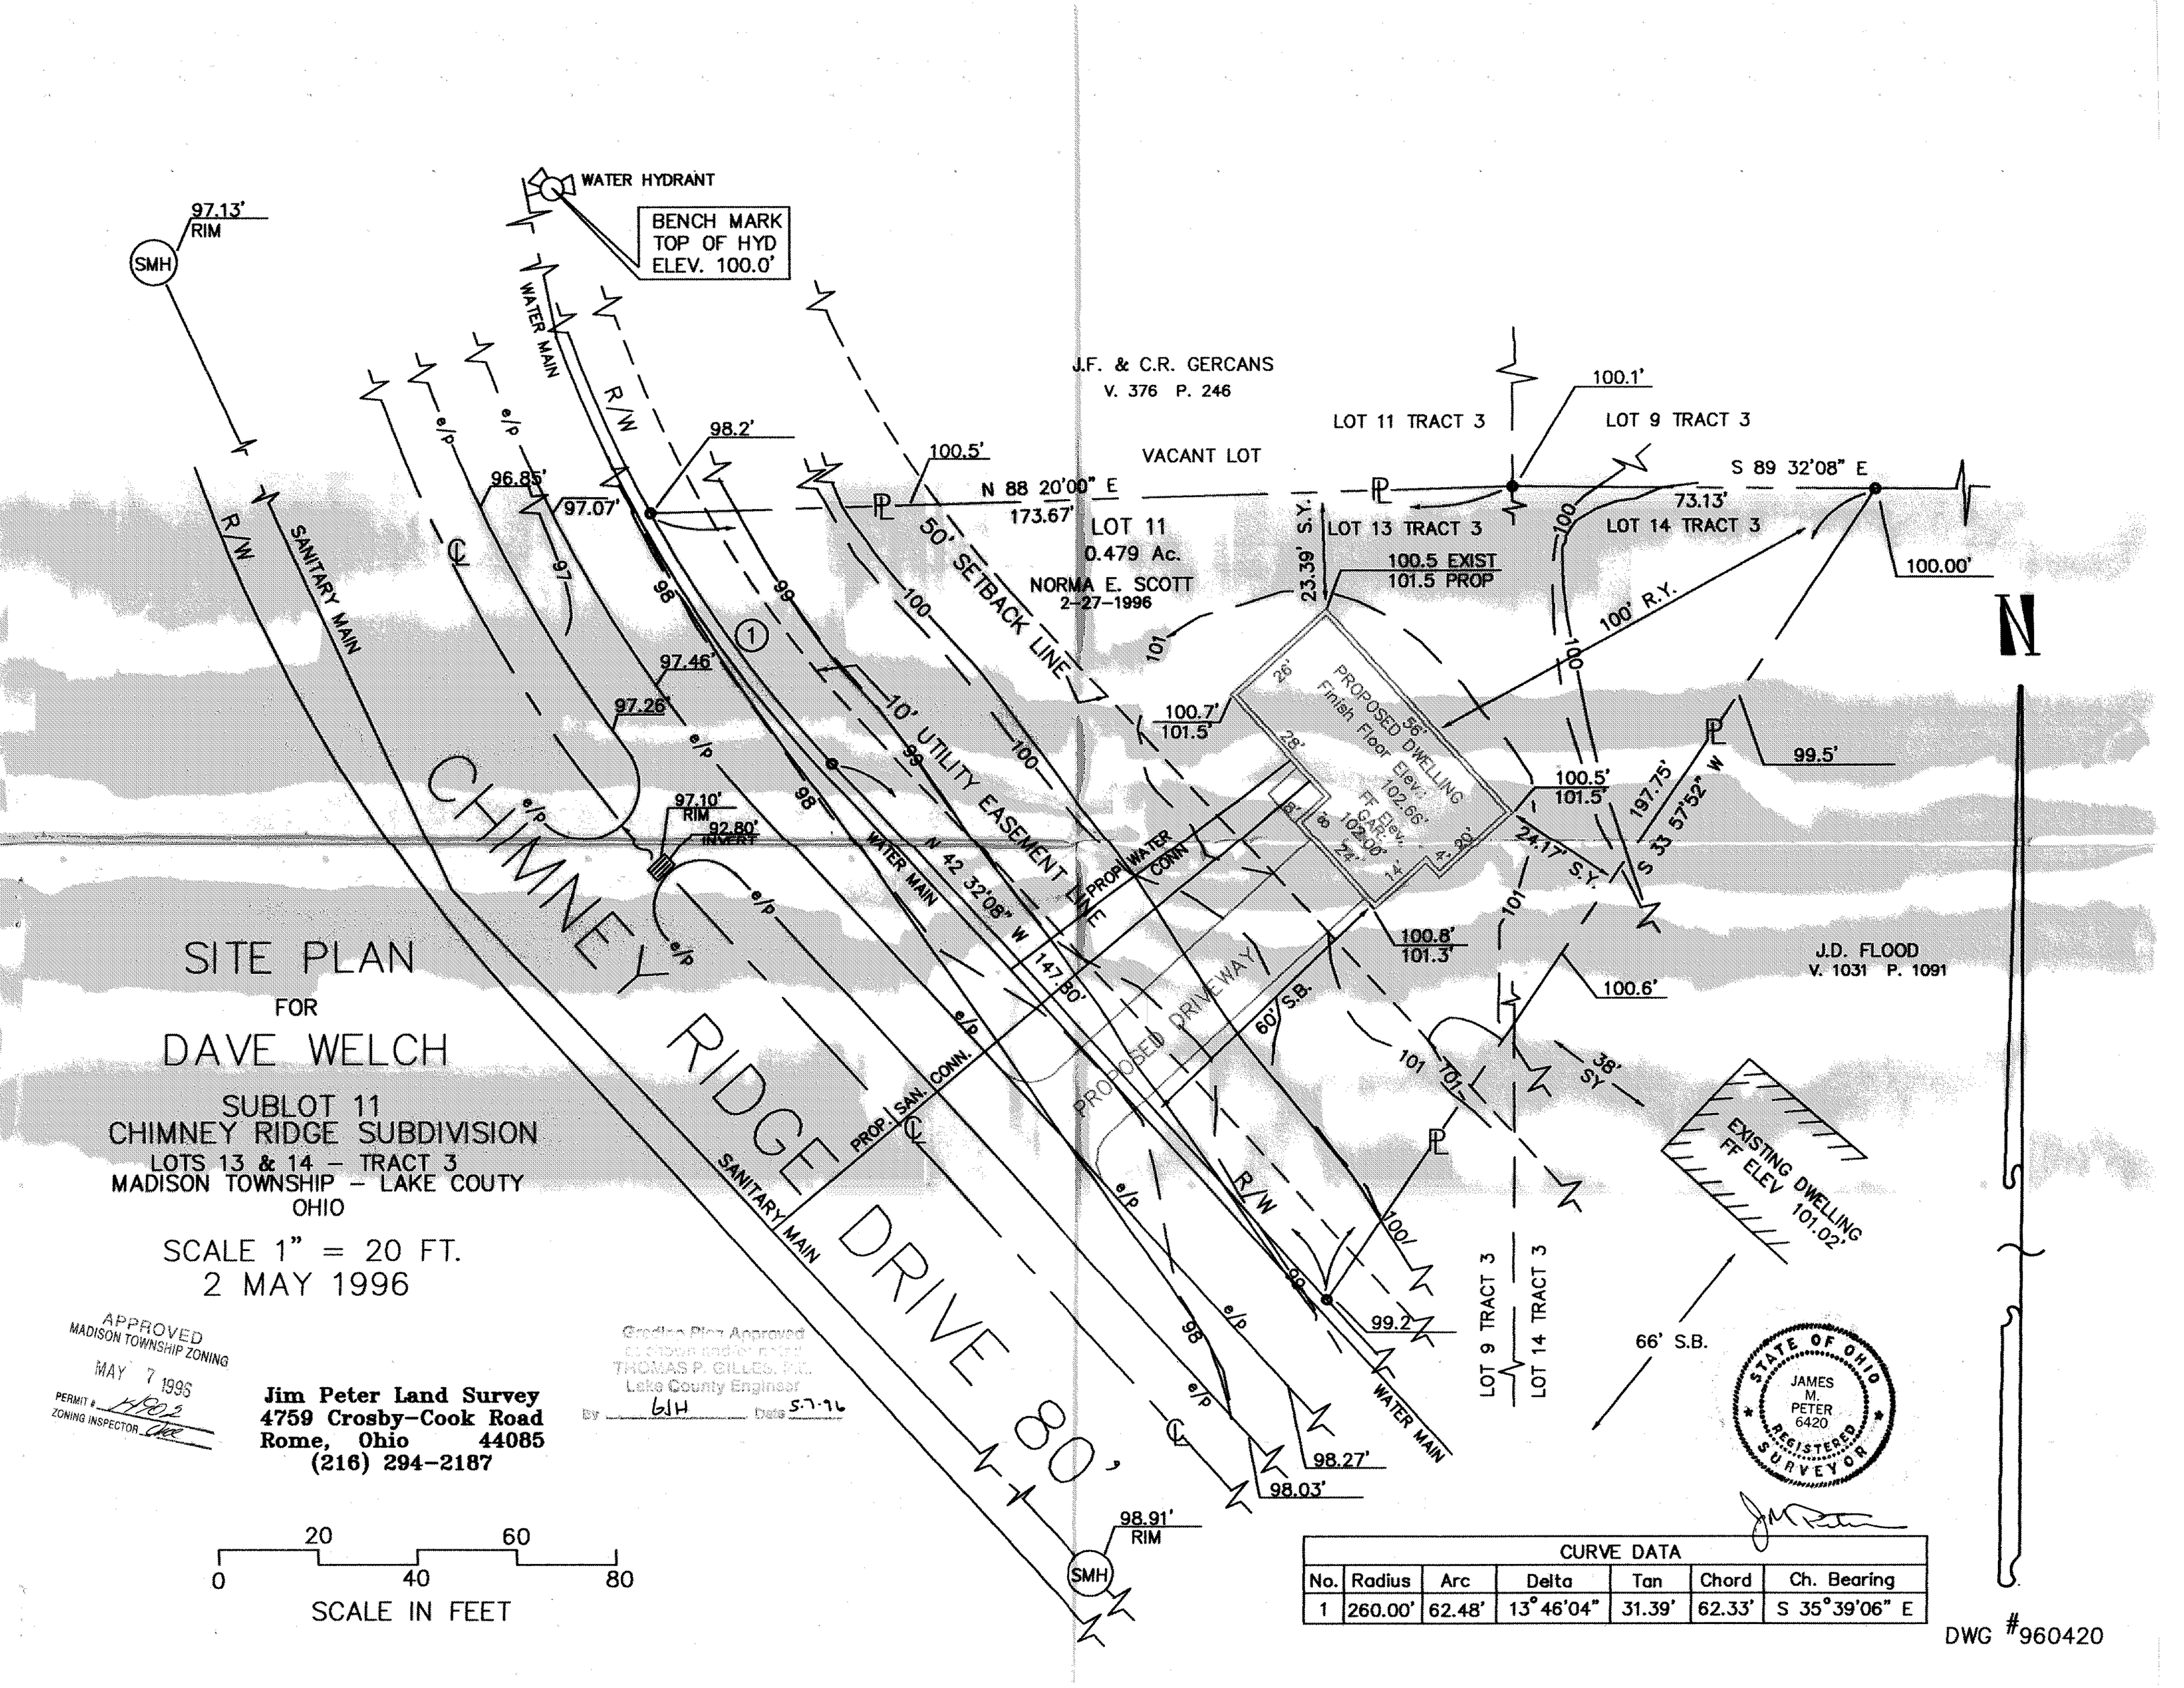

SITE PLAN
FOR
DAVE WELCH

SUBLOT 11
CHIMNEY RIDGE SUBDIVISION
LOTS 13 & 14 – TRACT 3
MADISON TOWNSHIP – LAKE COUTY
OHIO

SCALE 1" = 20 FT.
2 MAY 1996

APPROVED
MADISON TOWNSHIP ZONING
MAY 7 1996
PERMIT # 14902
ZONING INSPECTOR

Grading Plan Approved
as shown and/or noted
THOMAS P. GILLES, P.E.
Lake County Engineer
By GJH Date 5-7-96

Jim Peter Land Survey
4759 Crosby-Cook Road
Rome, Ohio 44085
(216) 294-2187

STATE OF OHIO
JAMES M. PETER
6420
REGISTERED SURVEYOR

0 20 40 60 80
SCALE IN FEET

CURVE DATA						
No.	Radius	Arc	Delta	Tan	Chord	Ch. Bearing
1	260.00'	62.48'	13°46'04"	31.39'	62.33'	S 35°39'06" E

DWG #960420