# SITE PLAN
FOR
# GLENN GNAGY

BEING KNOWN AS S/L 4 & 6 IN THE PARKVIEW SUBDIVISION, MADISON TOWNSHIP, LAKE COUNTY, OHIO.

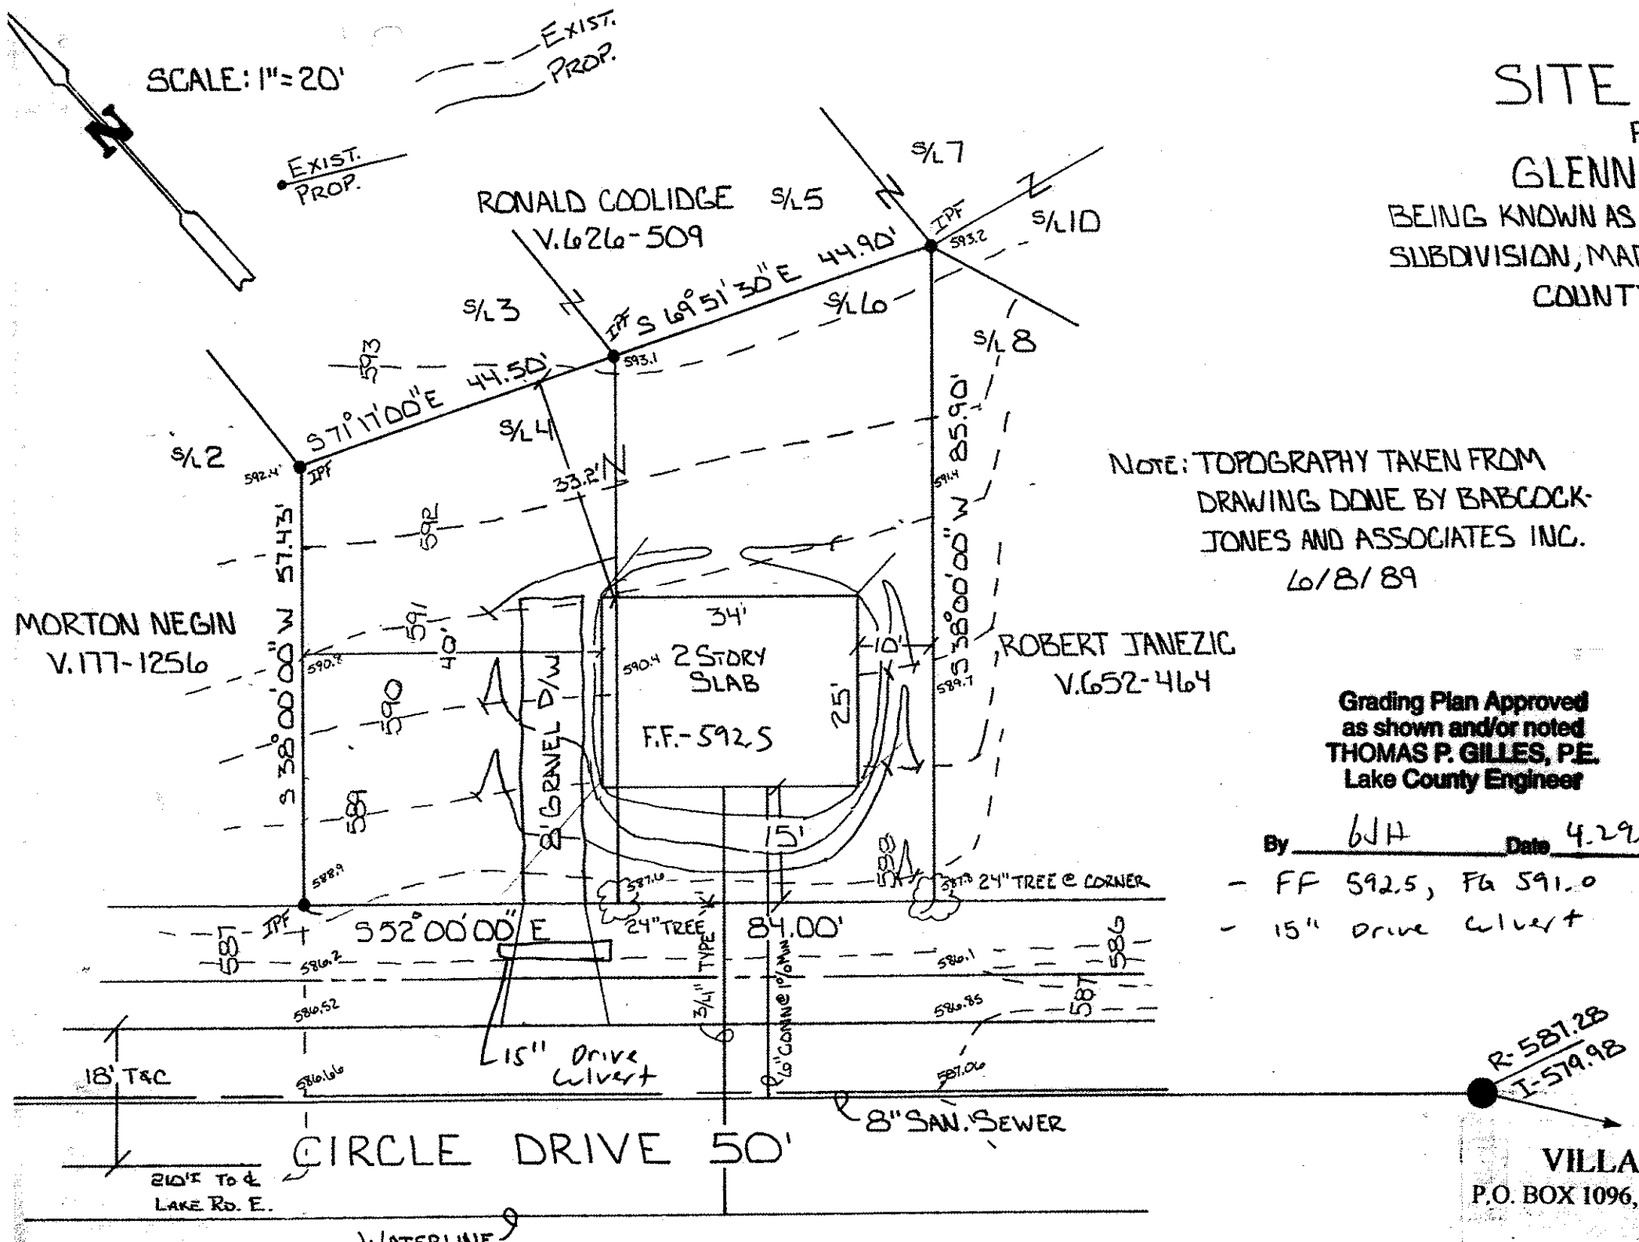


NOTE: TOPOGRAPHY TAKEN FROM DRAWING DONE BY BABCOCK-JONES AND ASSOCIATES INC. 6/8/89

STATE OF OHIO
THOMAS MARC COFFMAN
6857
REGISTERED SURVEYOR

APRIL 12, 1997

**Grading Plan Approved as shown and/or noted**
**THOMAS P. GILLES, P.E.**
**Lake County Engineer**

By 6JH Date 4.29.97

- FF 592.5, FG 591.0
- 15" Drive Culvert

APPROVED
MADISON TOWNSHIP ZONING
APR 21 1997
PERMIT # 15312
ZONING INSPECTOR


**VILLAGE SURVEYING CO.**
P.O. BOX 1096, FAIRPORT HARBOR, OHIO 44077
(216) 357-1359