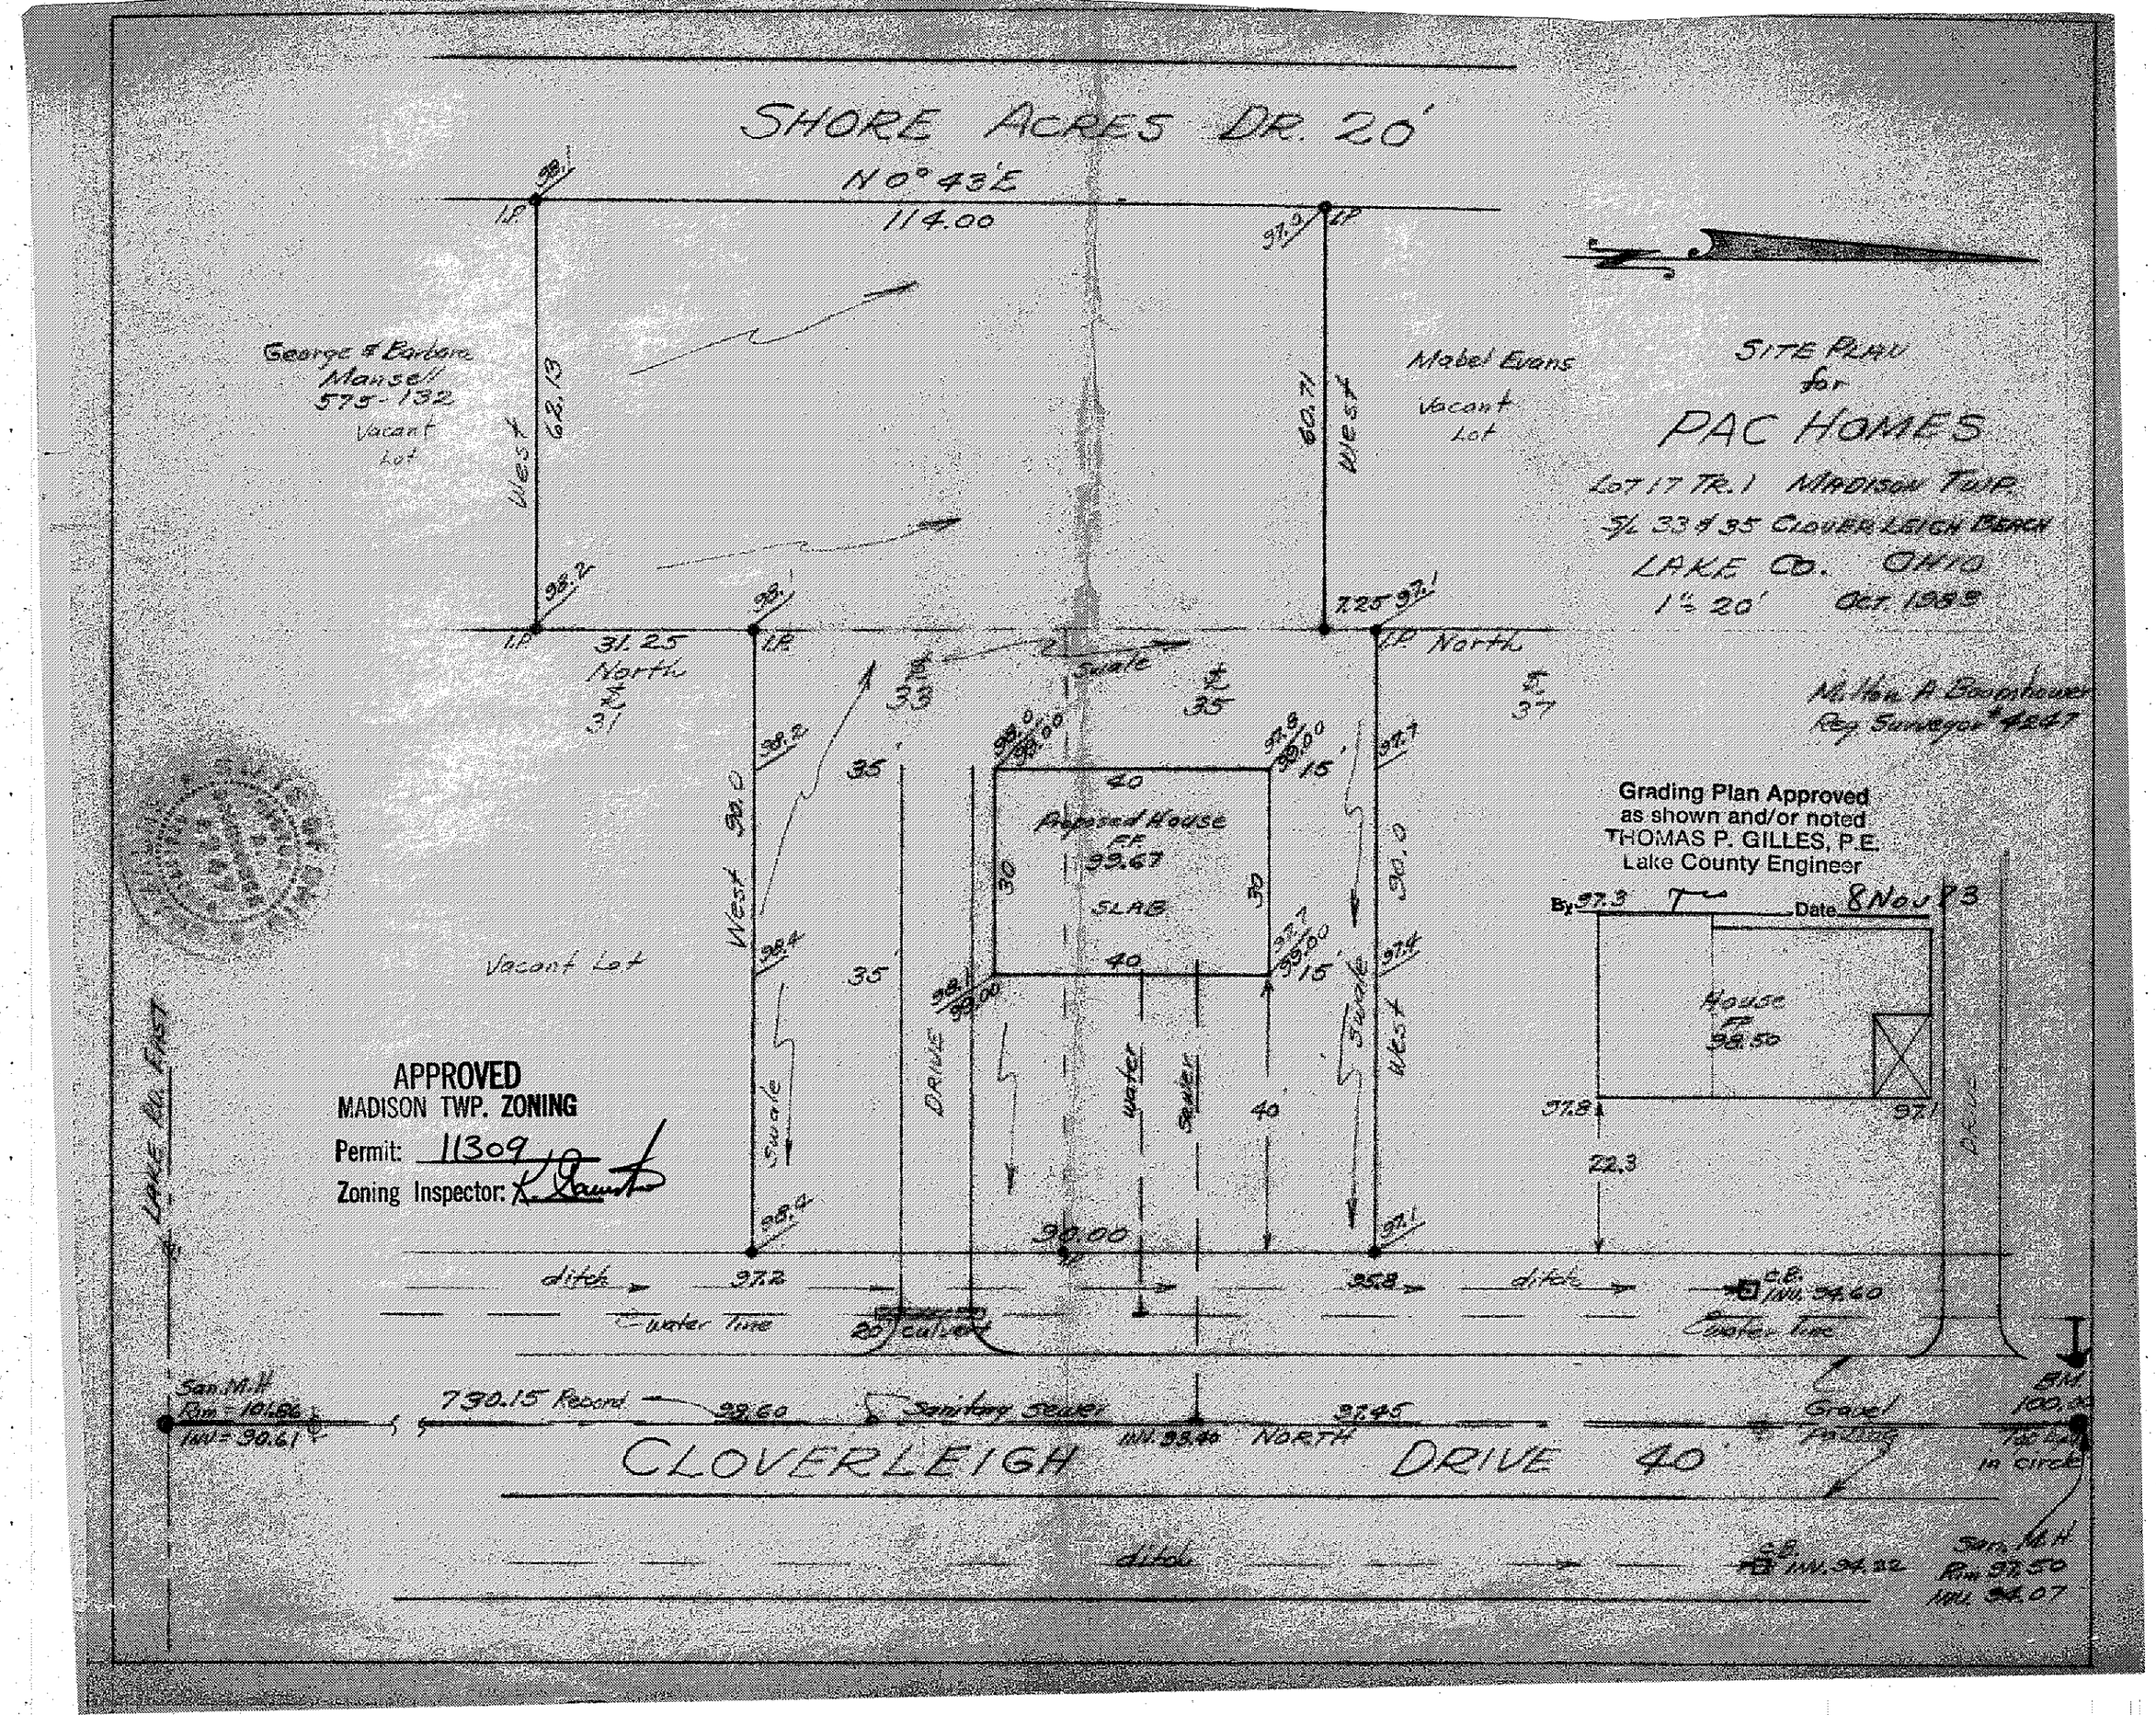
SHORE ACRES DR. 20'
N 0° 43' E
114.00
George & Barbara Mansell 575-132
Vacant Lot
Mabel Evans
Vacant Lot
SITE PLAN for PAC HOMES
LOT 17 TR. 1 MADISON TWP.
S/L 33 & 35 CLOVERLEIGH BEACH
LAKE CO. OHIO
1" = 20' OCT. 1983
Milton A. Boomhower
Reg. Surveyor #4247
Grading Plan Approved as shown and/or noted
THOMAS P. GILLES, P.E.
Lake County Engineer
By 97.3 Date 8 Nov 83
Proposed House FF 99.67
SLAB
House FF 98.50
Vacant Lot
APPROVED
MADISON TWP. ZONING
Permit: 11309
Zoning Inspector:
LAKE RD. EAST
ditch
water line
20' culvert
730.15 Record
Sanitary Sewer
CLOVERLEIGH DRIVE 40'
Gravel Paving
San. M.H. Rim = 101.86 INV = 90.61
San. M.H. Rim 97.50 INV. 94.07