SITE PLAN
SUBLOTS 12-14 & 24-26
CLOVERLEIGH BEACH SUB.
VOL. F-44 of PLATS

MADISON TWP. LAKE CO.

1" = 20' 6-23-89

APPROVED
MADISON TWP. ZONING
Permit: 12535 + 12536
Zoning Inspector: DPL
JUN. 23 1989

Grading Plan Approved
as shown and/or noted
THOMAS P. GILLES, P.E.
Lake County Engineer
By GJH Date 7/11/89

DEVELOPER
PENFIELD, Inc.
BOX 488
MADISON, OHIO 44057

PROP. GR.
EX. GR

— — — EX. CONTOUR
———— FINAL CONTOUR
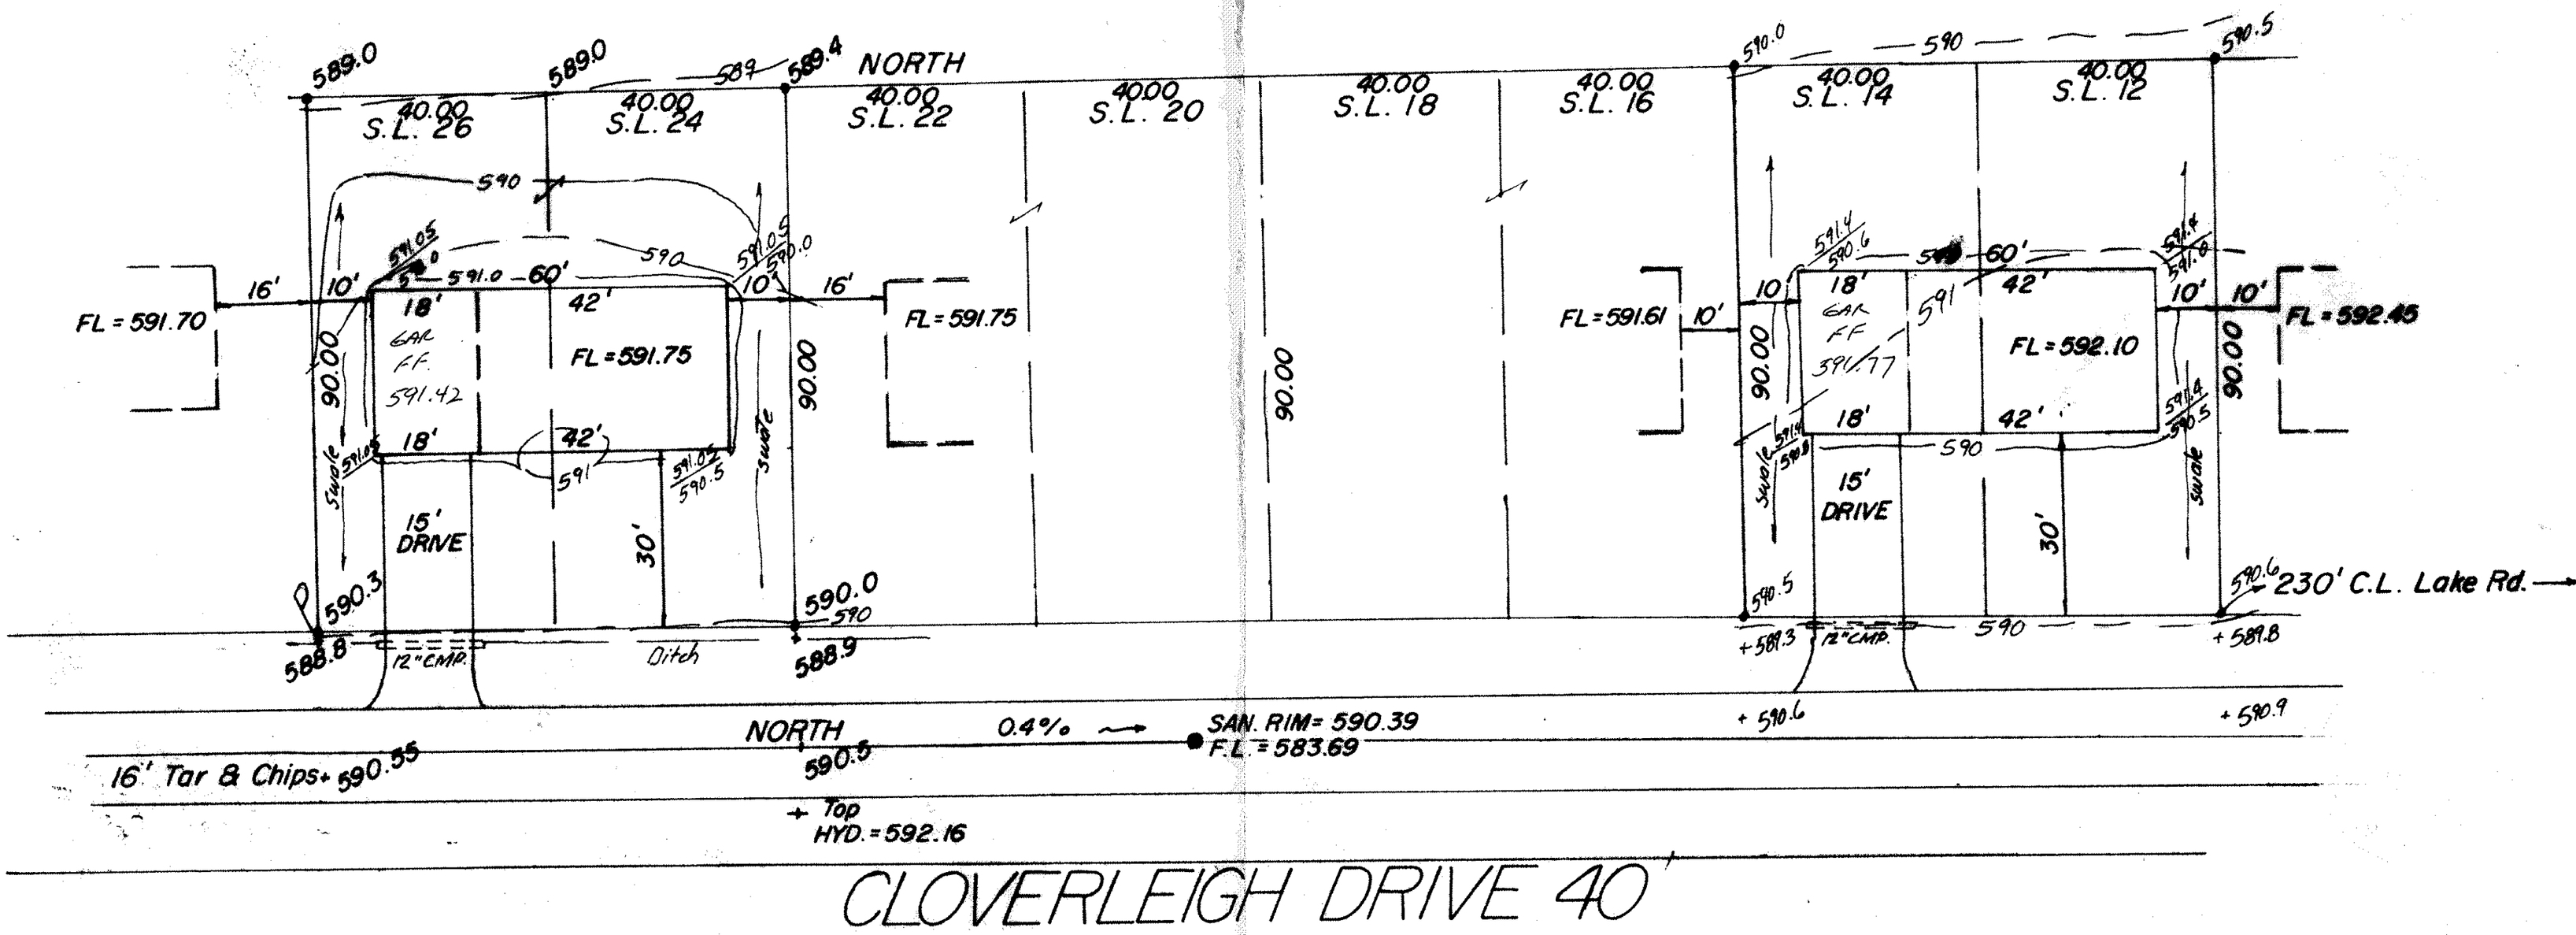
JERRY SLAY, Ohio Surveyor 5298
Box 1252
ASHTABULA, OHIO 44004
216-993-7205