APPROVED
MADISON TWP. ZONING
Permit: 12555
Zoning Inspector: DW
JUL 13 1989

SITE PLAN
SUBLOT 869
CUMINGS BEACH PARK SUB.
VOL. F-50
MADISON TWP. LAKE CO.

1" = 20' 6-22-89

DEVELOPER
PENFIELD, Inc.
BOX 488
MADISON, OHIO 44057
216-428-6662

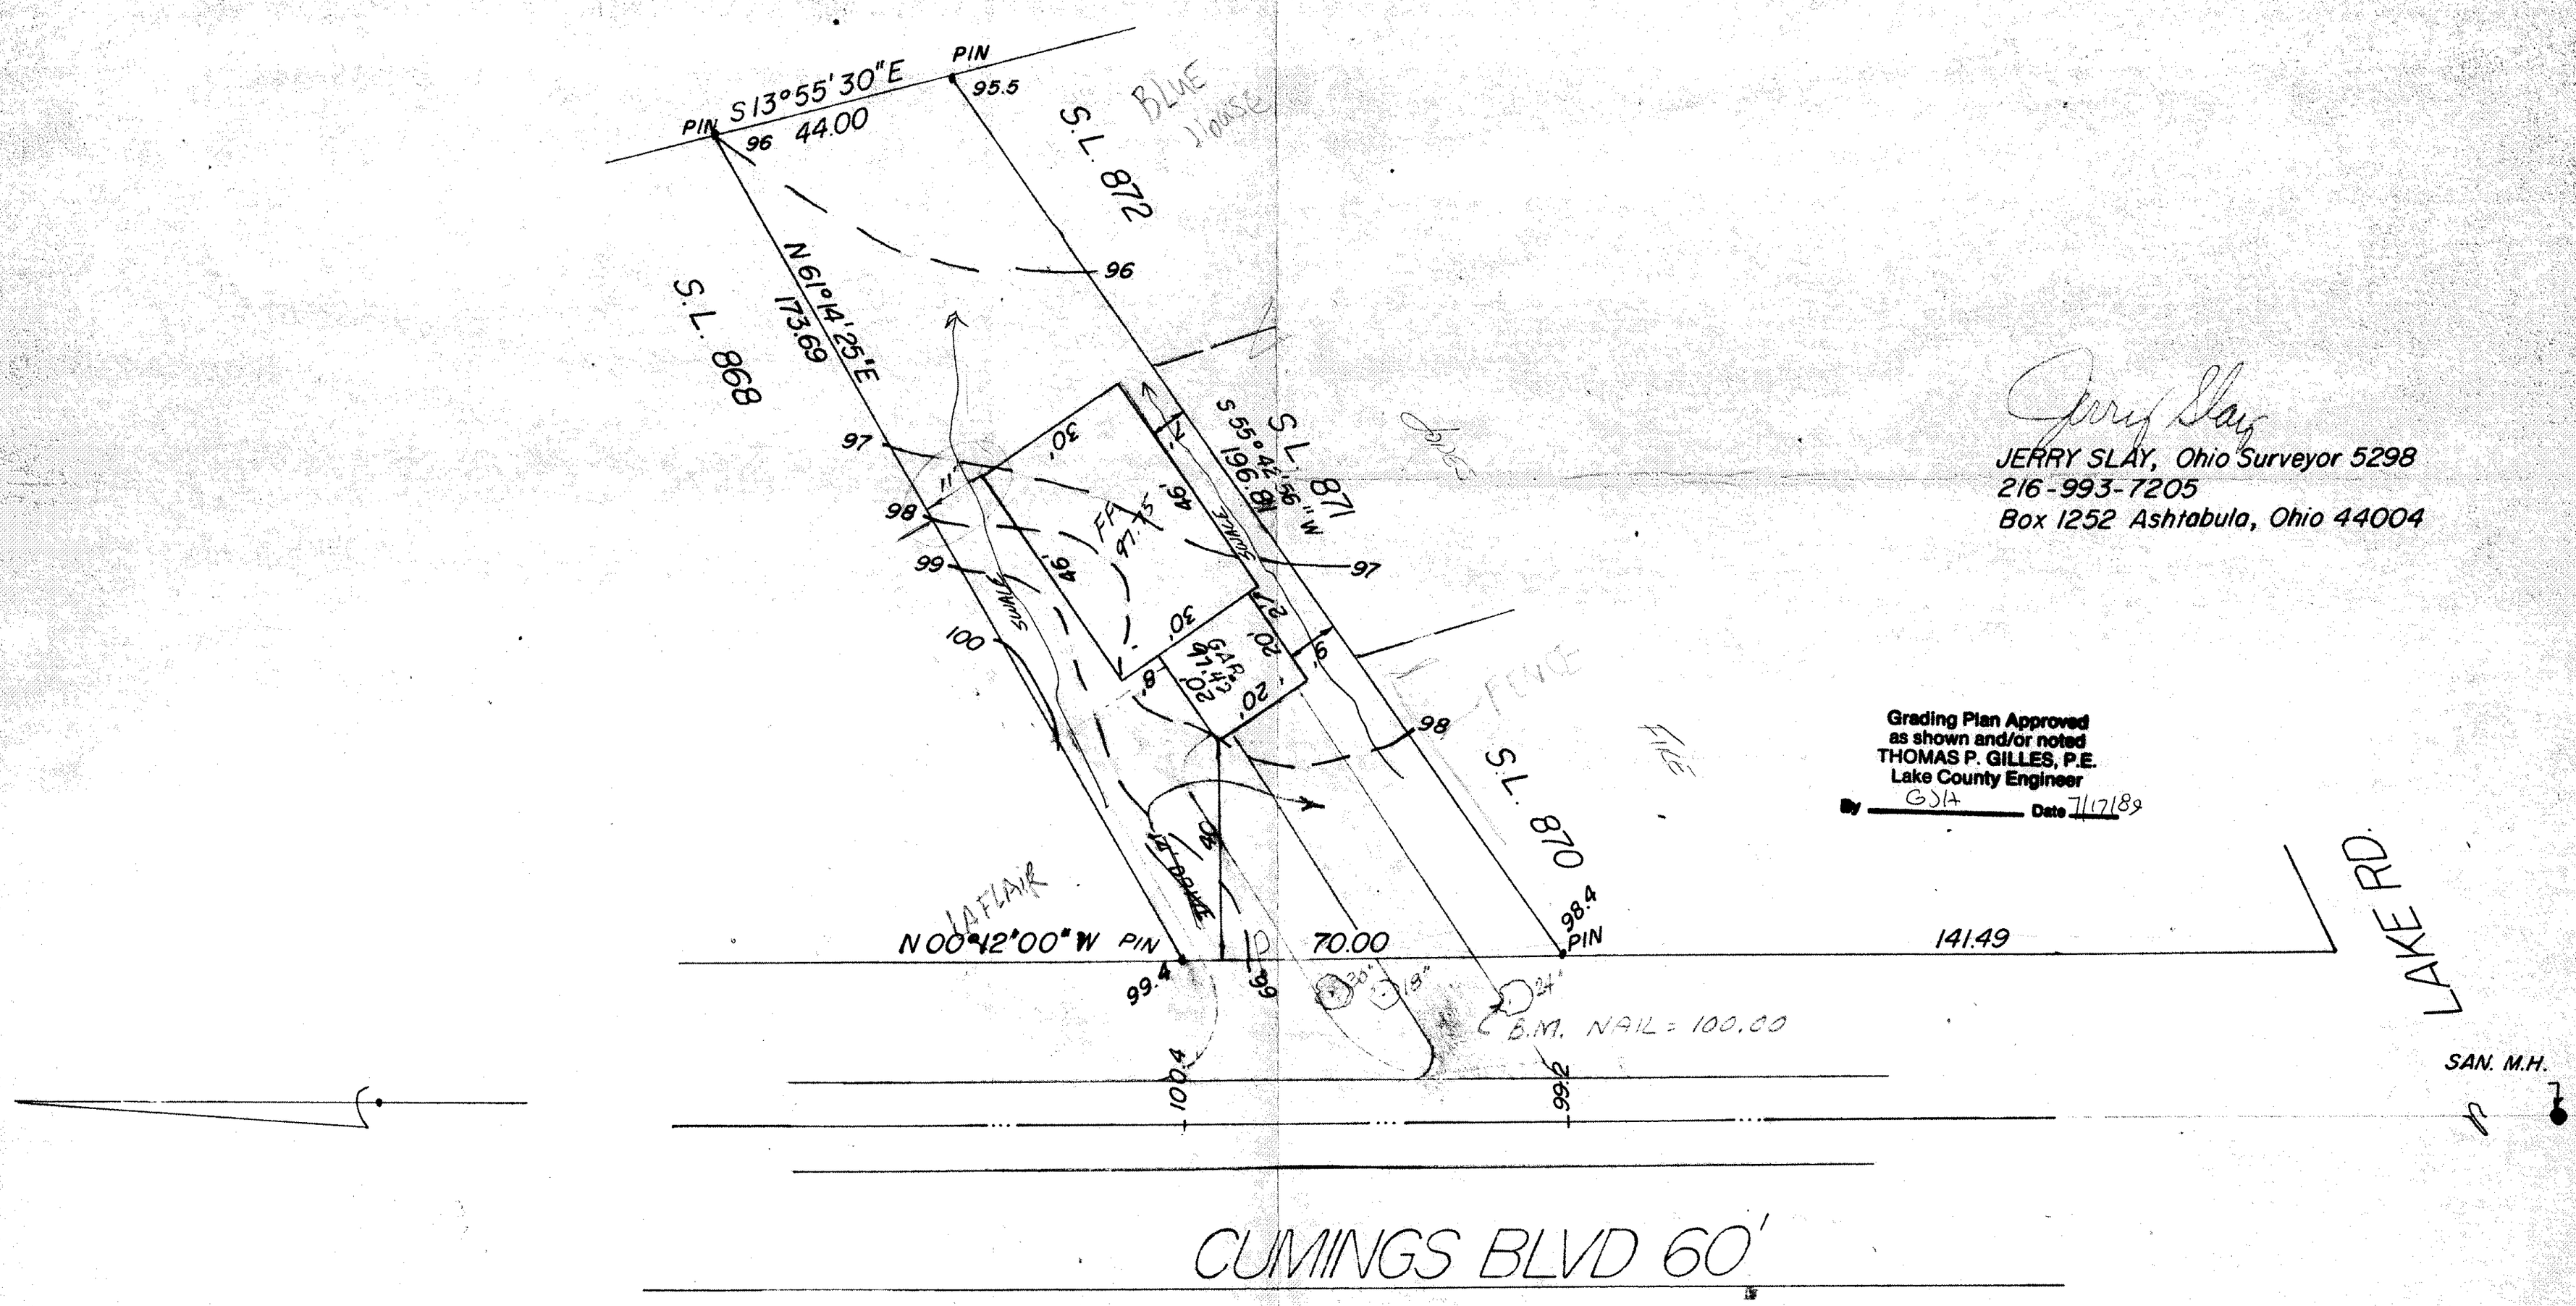

Grading Plan Approved
as shown and/or noted
THOMAS P. GILLES, P.E.
Lake County Engineer
By GJA Date 7/17/89

JERRY SLAY, Ohio Surveyor 5298
216-993-7205
Box 1252 Ashtabula, Ohio 44004