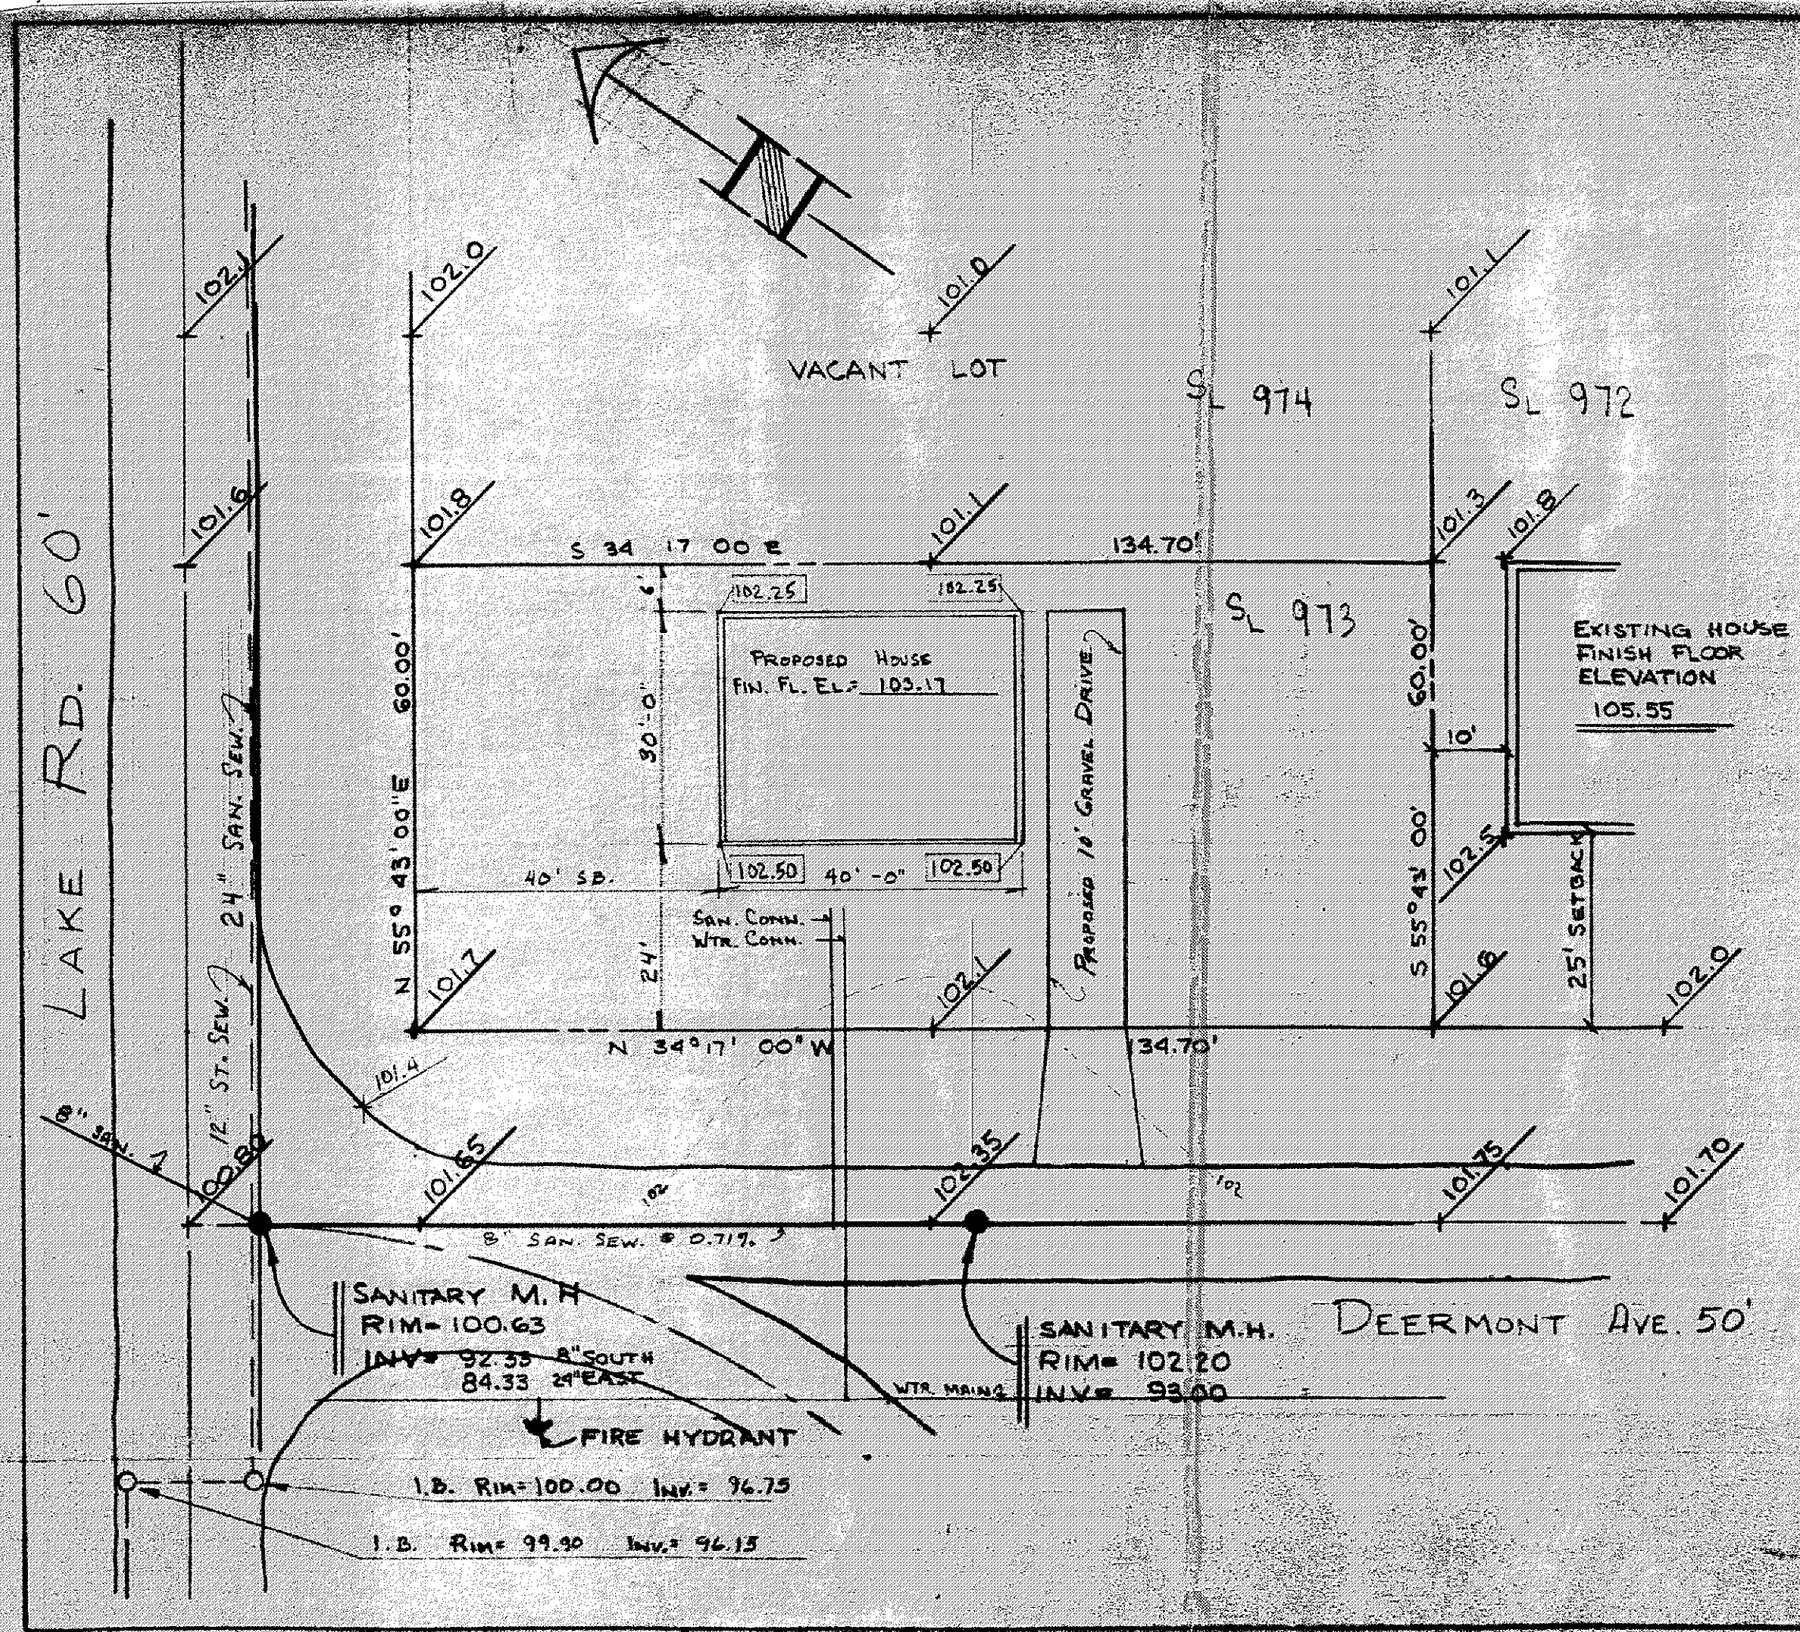

SITE PLAN FOR:

GIL JOHNSTON
2736 N. RIDGE RD.
PAINESVILLE, OHIO

BEING SUBLOT NO. 973 IN THE CUMINGS BEACH PARK ALLOTMENT IN MADISON, OHIO.

PREPARED BY:

WM. R. GRAY ASSOC. INC.
7547 MENTOR AVE.
MENTOR, OHIO

DATE: MAY 12, 1976 SCALE: 1" = 20'
REV'D. MAY 13, 1976 ADDITIONAL LOCATIONS & TOPO.

CERTIFICATION:

I HEREBY CERTIFY THAT THIS PLAT IS CORRECT TO THE BEST OF MY KNOWLEDGE.

By: Wm R Gray
WM. R. GRAY R.S. # 2752

STATE OF OHIO
WM. R. GRAY
2752
REGISTERED
PROFESSIONAL SURVEYOR

ZP #9556
Grading Plan Approved as shown and/or noted
THOMAS P. GILLES, P.E.
Lake County Engineer
By: JWK Date 5-14-76