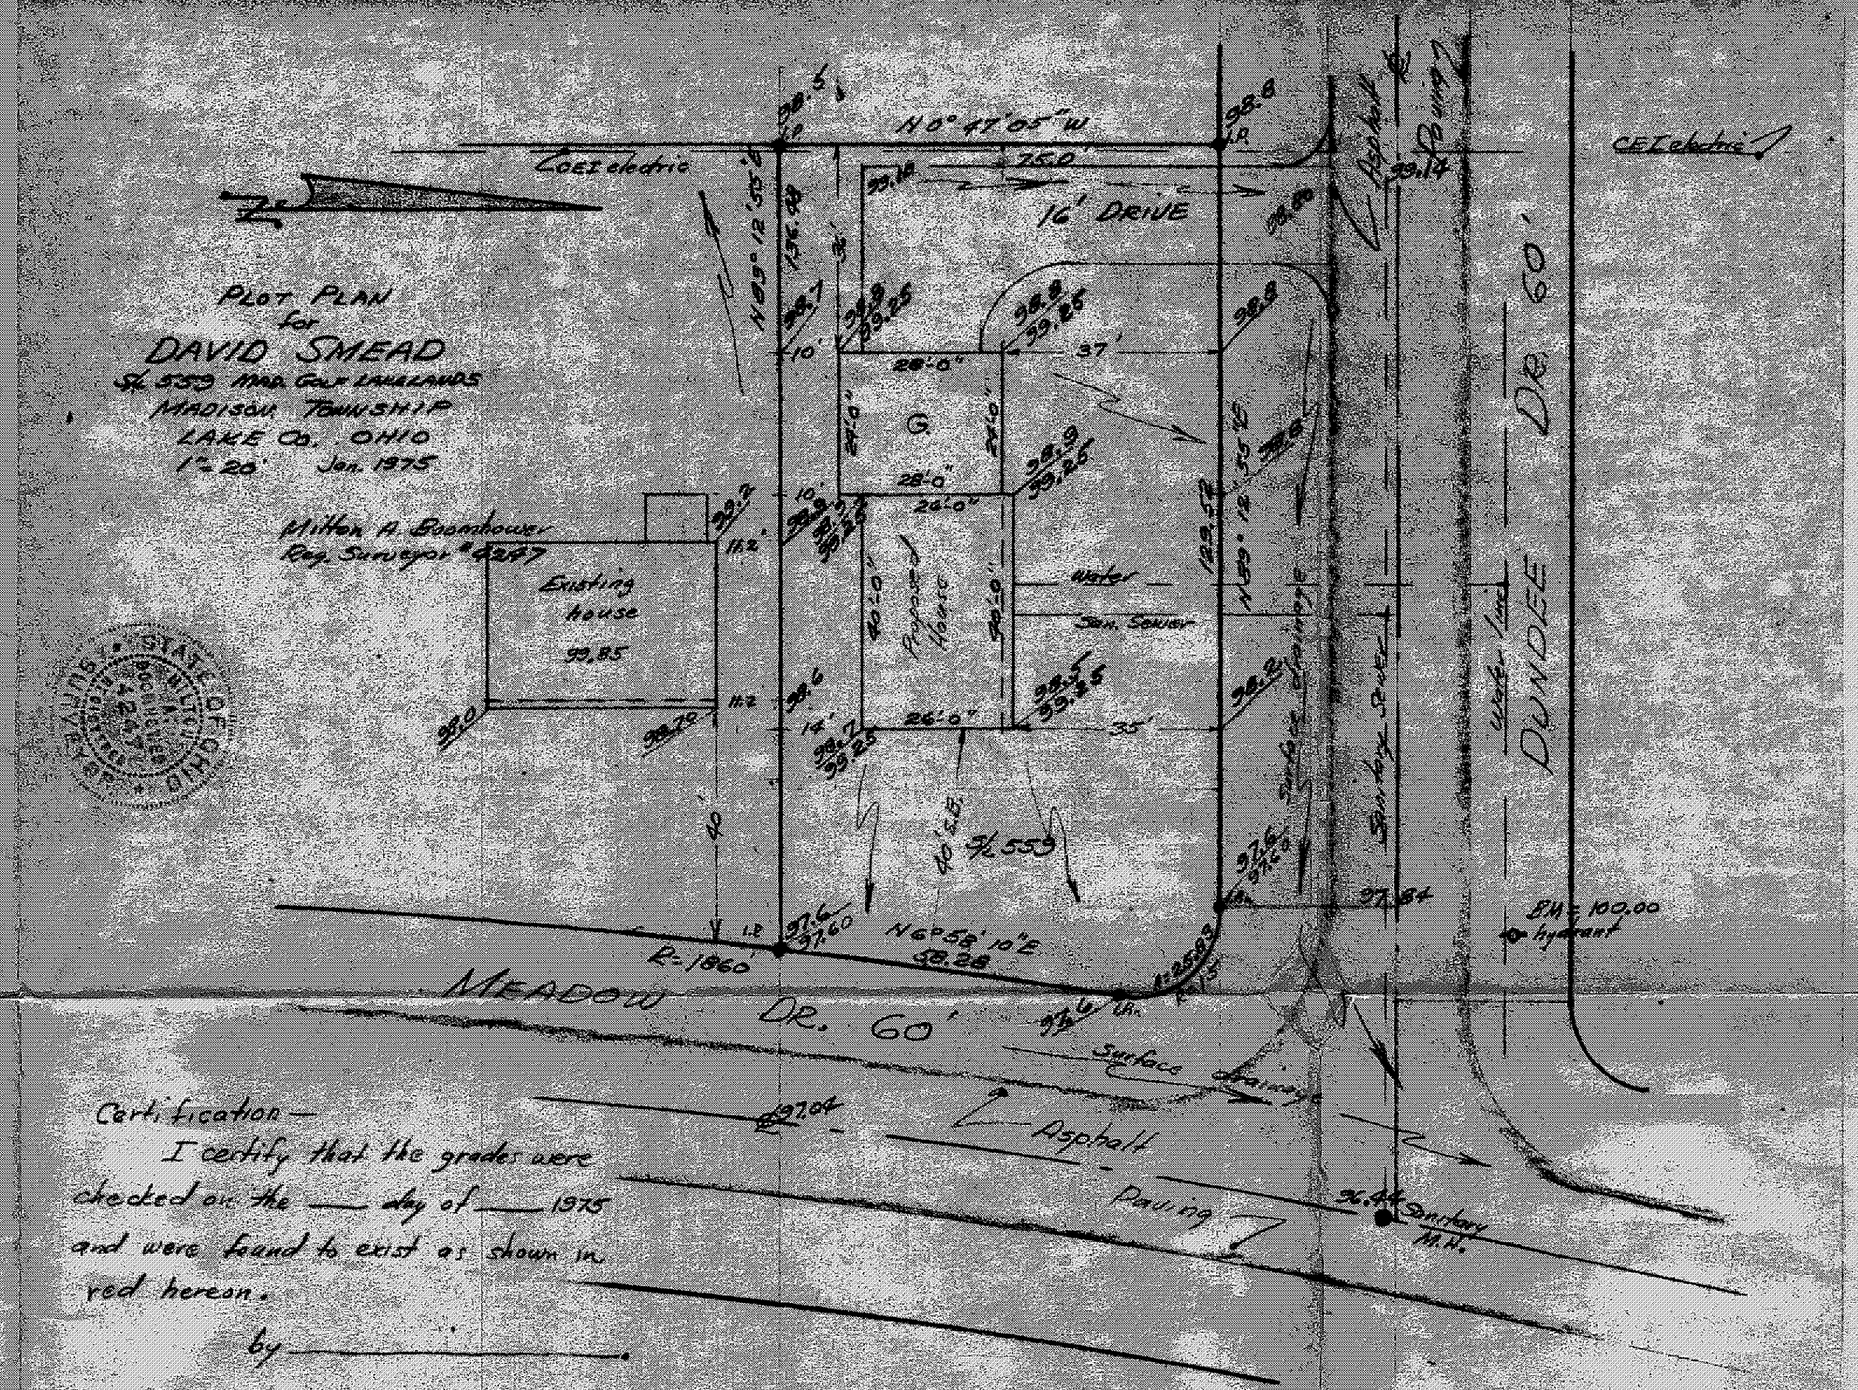


Certification —

I certify that the grades were checked on the ___ day of ___ 1975 and were found to exist as shown in red hereon.

by _____.

APPROVED
MADISON TWP. ZONING
Permit: 9235
Zoning Inspector: R. Dodge

Grading Plan Approved
as shown and/or noted
THOMAS P. GILLES, P.E.
Lake County Engineer
By: JWK Date: 1-30-75