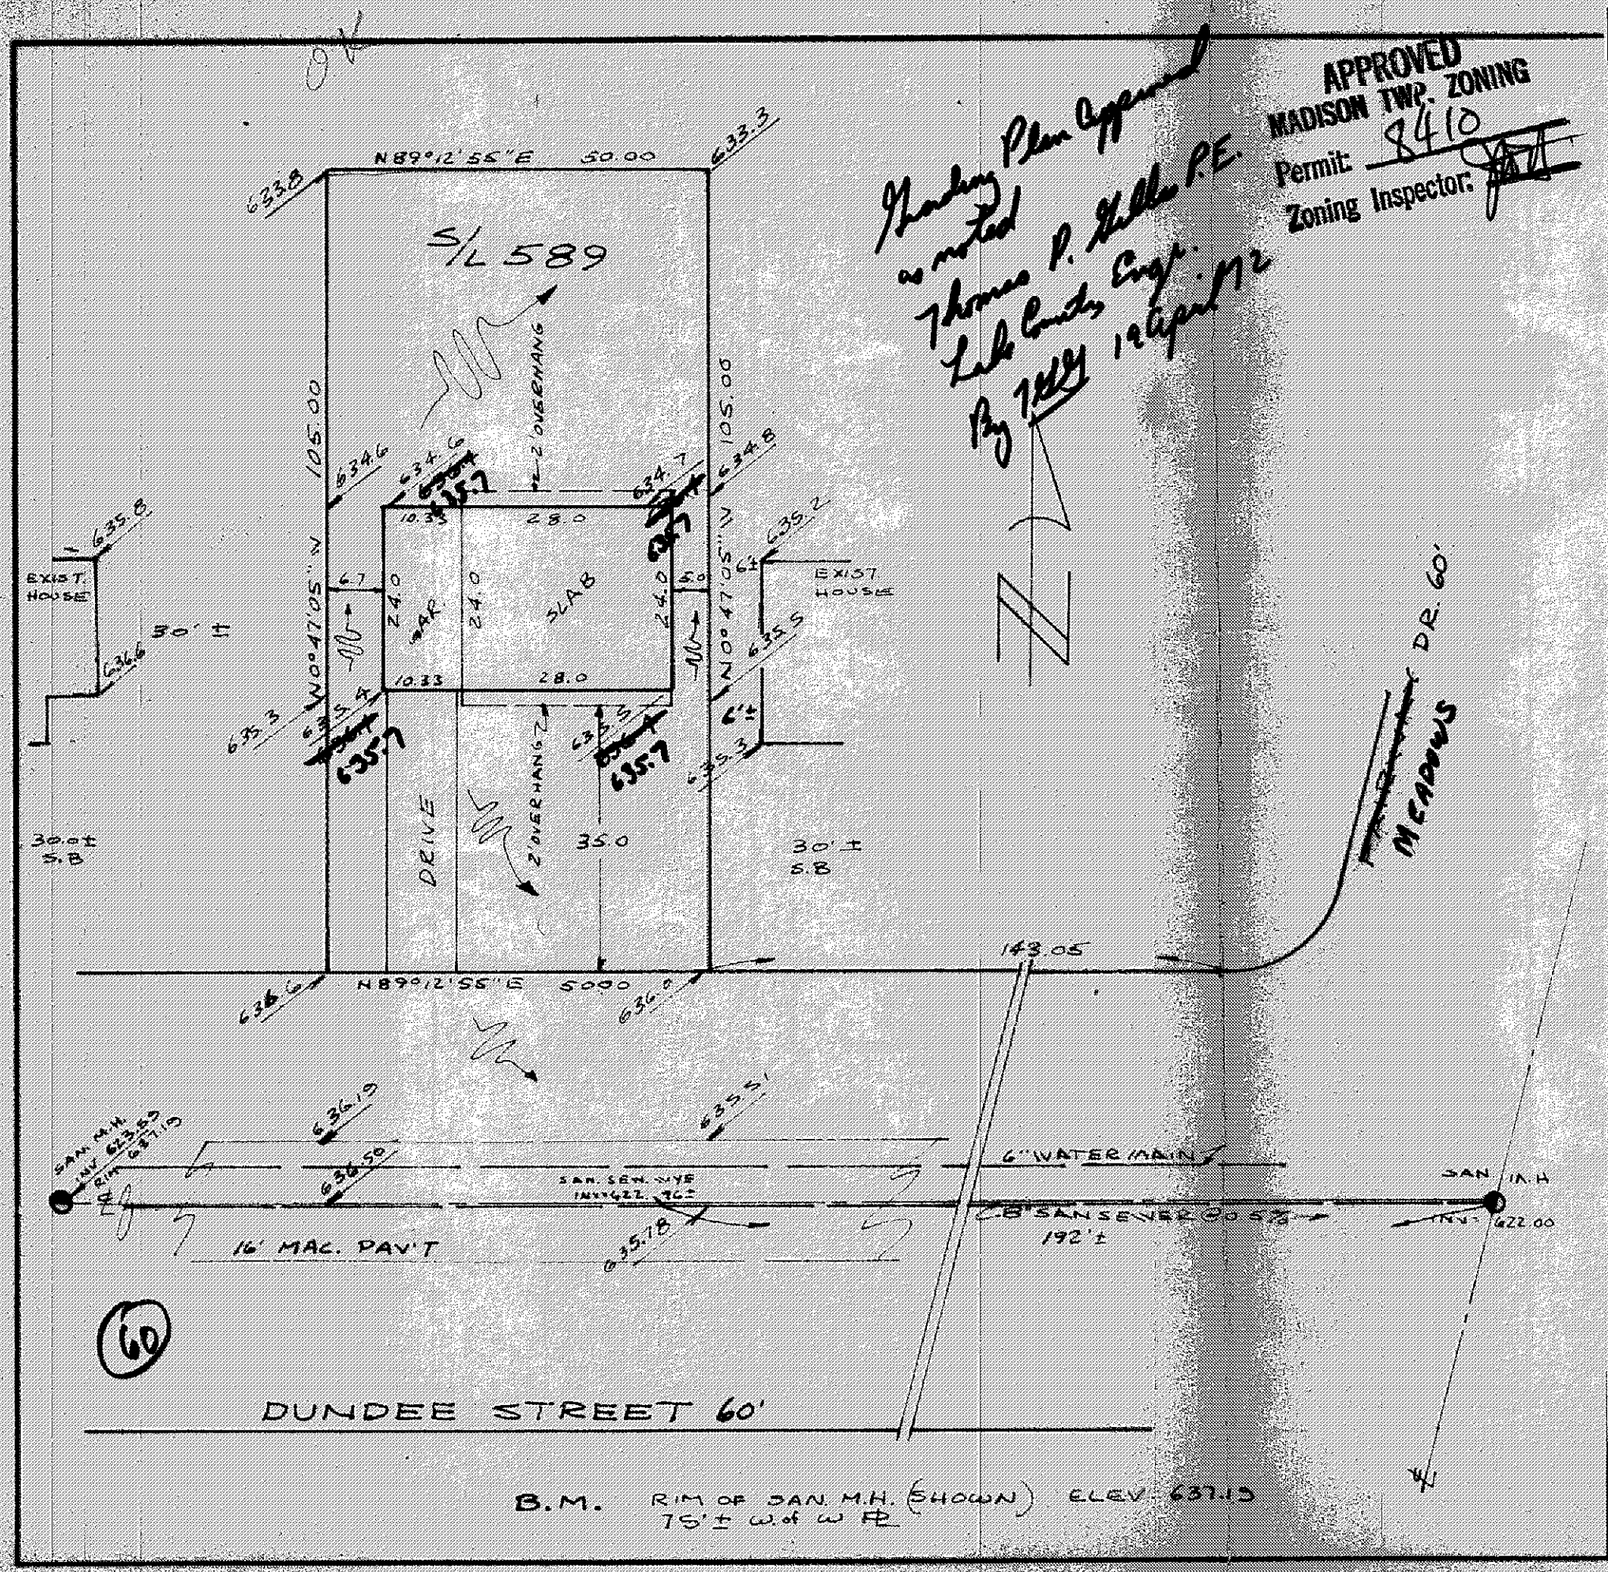

Grading Plan Approved as noted
Thomas P. Gillis P.E.
Lake County Engr.
By TGG 19 April 72

APPROVED
MADISON TWP. ZONING
Permit: 8410
Zoning Inspector:

SITE PLAN

MADISON — LAKE COUNTY, OHIO
TOWNSHIP

for WINSLOW HOMES INC
CLIENT OWNER

ADDRESS STREET CITY ZIP

MADISON GOLF LAKELANDS	
RECORD SUBDIVISION	
E	68
VOLUME	PAGE
589	DUNDEE ST.
SUBLOT NO	STREET

LOT	TRACT
VOLUME	PAGE
PERM. PARCEL #	STREET

LEGEND

SANITARY MANHOLE
STORM MANHOLE
INLET OR CATCH BASIN
HYDRANT
EXISTING CONTOURS
PROPOSED CONTOURS
EXIST. ELEV. 100.0 / 100.0 PROP. ELEV.

WATER VALVE (GAS)
WATER METER (GAS)
AS BUILT ELEVATION
DIRECTION OF SURFACE DRAINAGE

REMARKS

ALL BOUNDARY DATA SHOWN WAS OBTAINED FROM (DEEDS, RECORDED SUBDIVISION PLAT, OR OTHER PUBLIC RECORDS)

DESIGN CERTIFICATION

THIS PLAT WAS PREPARED BY ME, AND IS CORRECT TO THE BEST OF MY KNOWLEDGE AND BELIEF.

Richard J. Bilski PS # 5244
NAME SURVEYOR REGISTRATION NO.

CHECK LIST

DIMENSIONS
BEARINGS
TIE TO NEAREST STREET
SUBLOT NO PARCEL NO
SURROUNDING OWNERS
BLDG DIMENSIONS FIN GR
BLDG TIES FLR GRADES
APRON TYPE WIDTH THICKNESS
SIDEWALK TYPE WIDTH THICKNESS
CULVERT TYPE DIA LENGTH

WATER MAIN SIZE LOCATION
SAN SEWER SIZE % GR. LOC.
SAN M.H. CAST ELEV. INV ELEV.
SAN CONN SIZE LOC DEPTH
STORM SEWER SIZE % GR. LOC.
STORM MH. CAST ELEV. INV. ELEV.
PAVT TYPE GRADE CURBS
GAS LINE LOC SIZE PRESSURE
SEPTIC TANK SIZE LOC.
WELL LOCATION

RIVISIONS		
NO	DATE	BY
1	4/14/72	RJB
2		
3		
4		
5		

PLAN PREPARED BY:

DEBEVEC-SALO & ASSOC, INC.
CIVIL ENGINEERS - SURVEYORS NAME
130 E. JACKSON ST PAINESVILLE, O.
ADDRESS

DRAWN BY RJB	SCALE 1" = 20'	PHONE NO.
CHK'D	DATE 3/72	DRAWING NO. 3574-589
CREW	APP'D	

11X17 PRINTED ON NO. 1000H CLEARPRINT