SITE PLAN
FOR
FRANK PERONI

BEING KNOWN AS PART OF LOT No. 8, TRACT No. 8
IN MADISON TOWNSHIP, LAKE COUNTY, OHIO.

SCALE: 1" = 20'

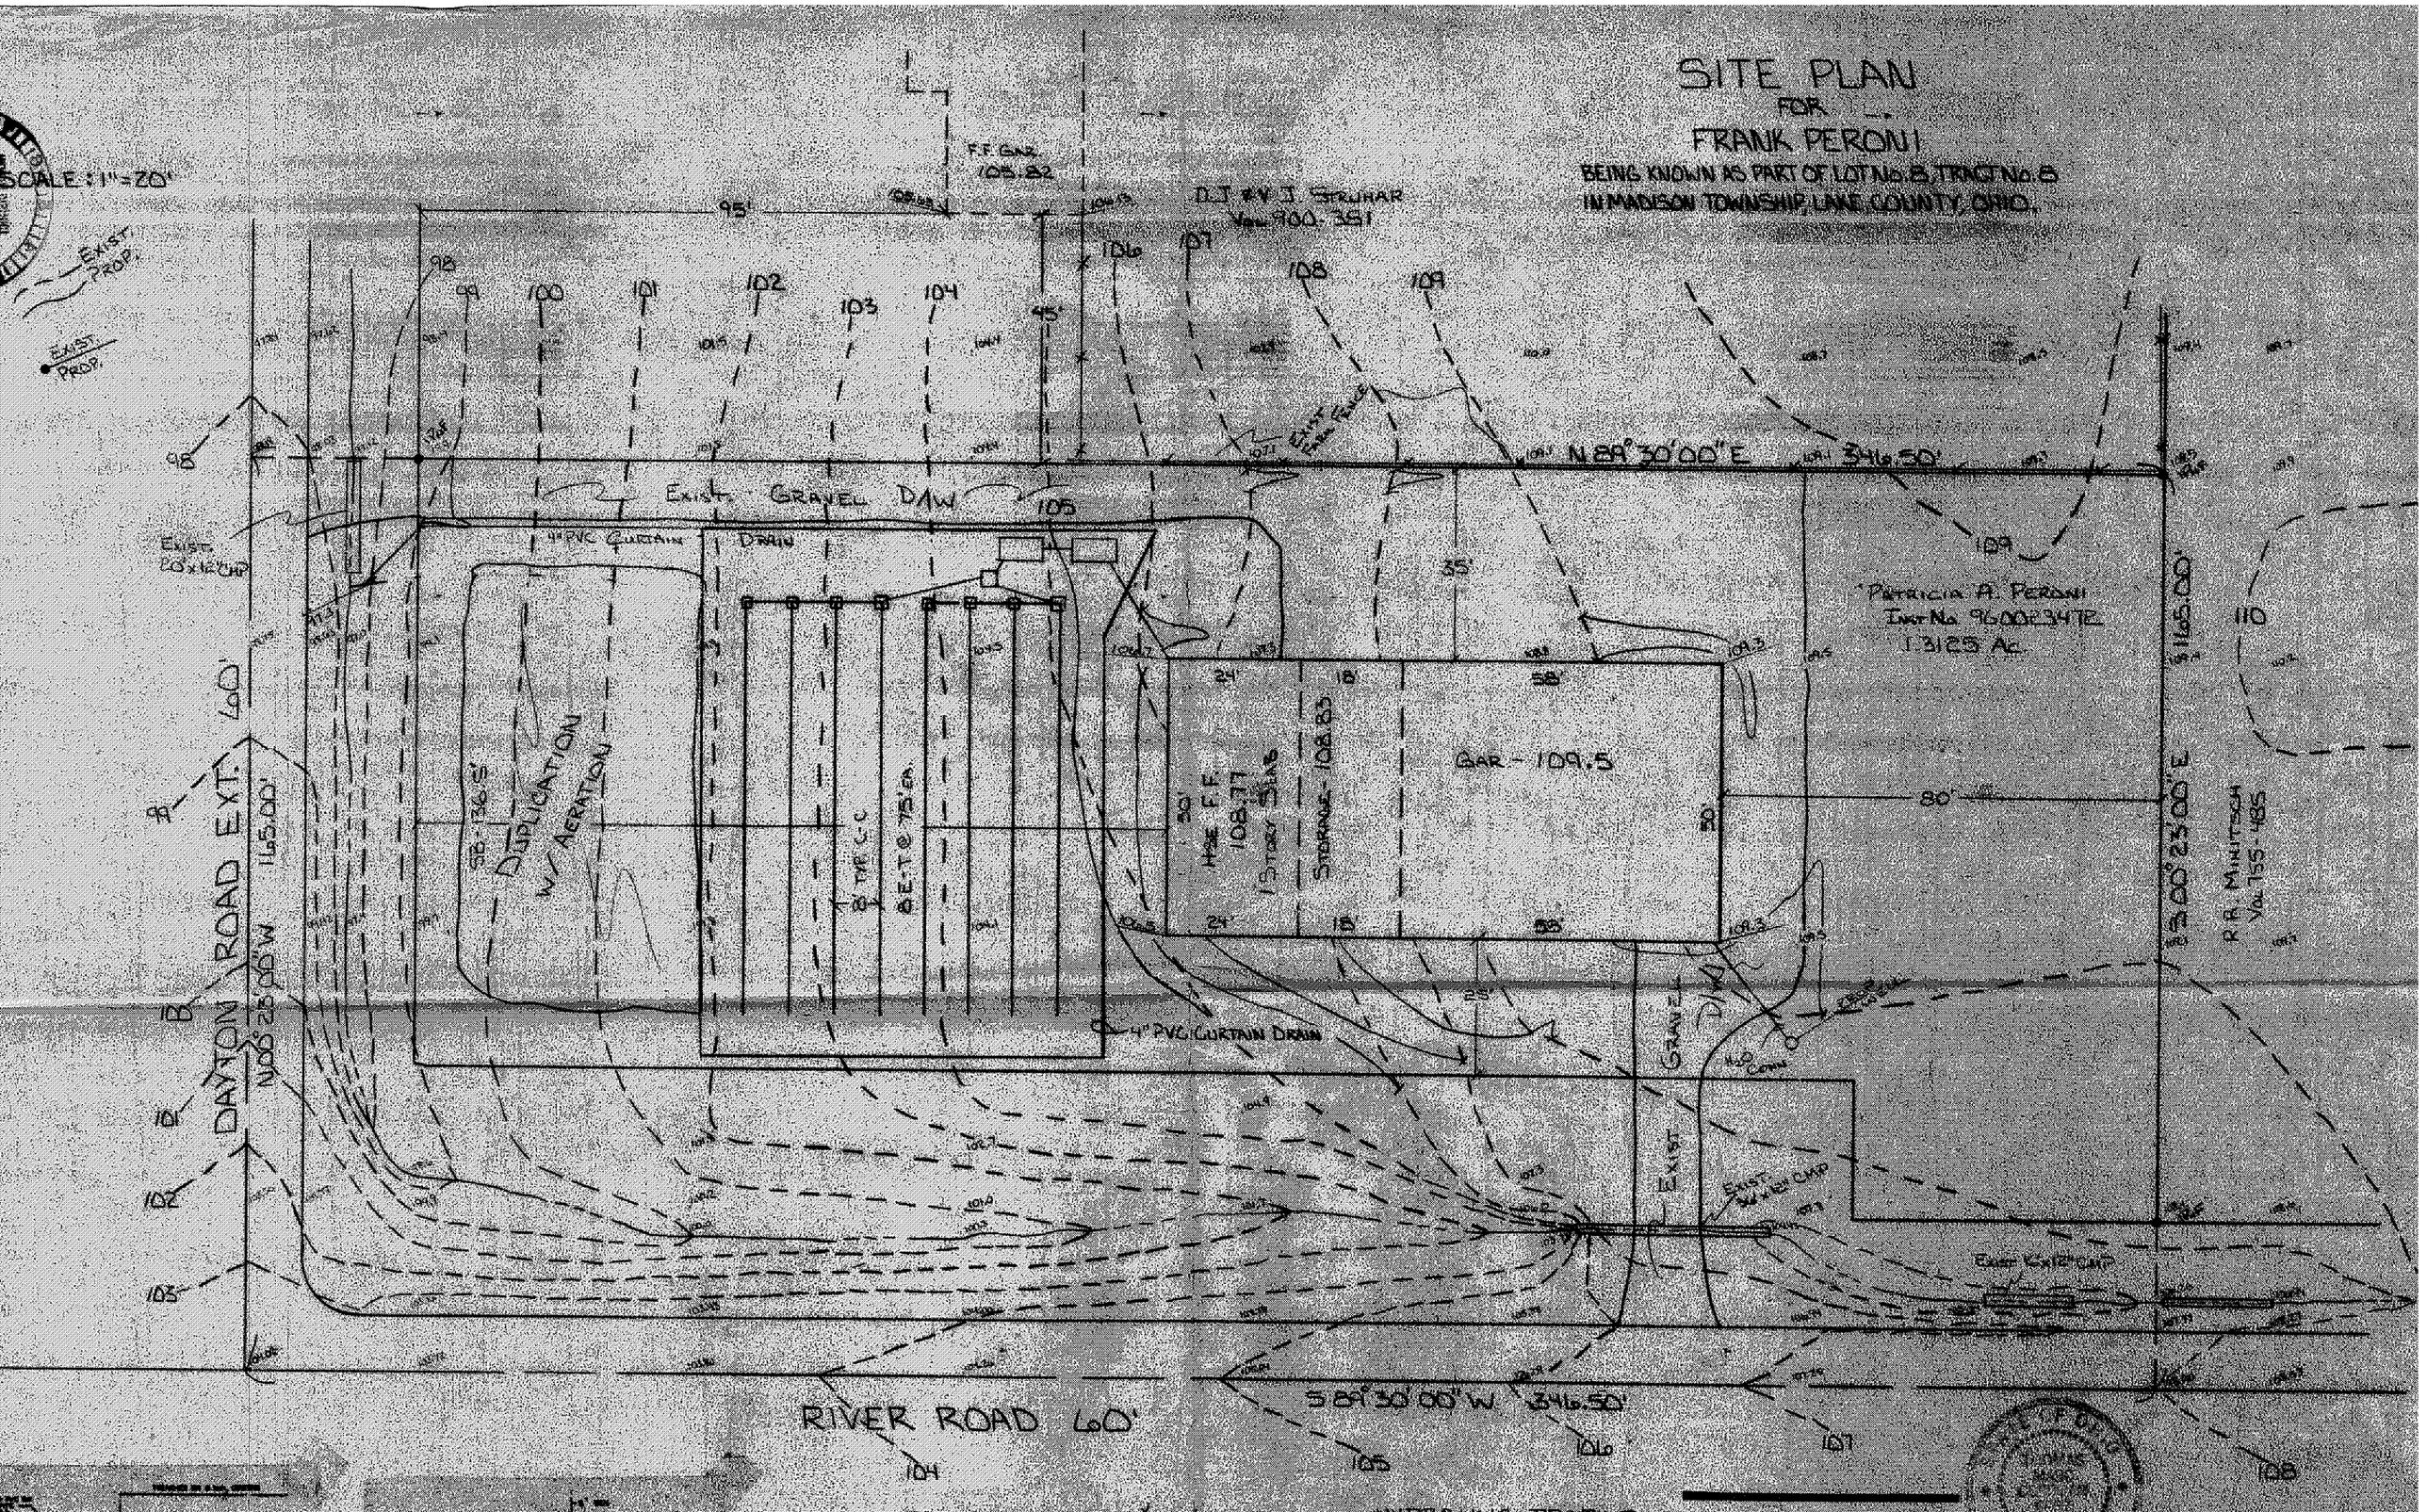

 

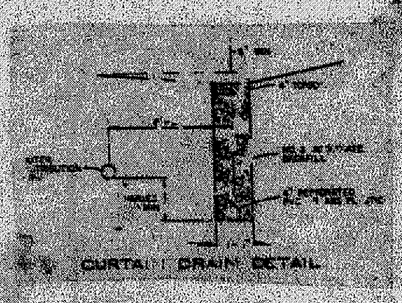

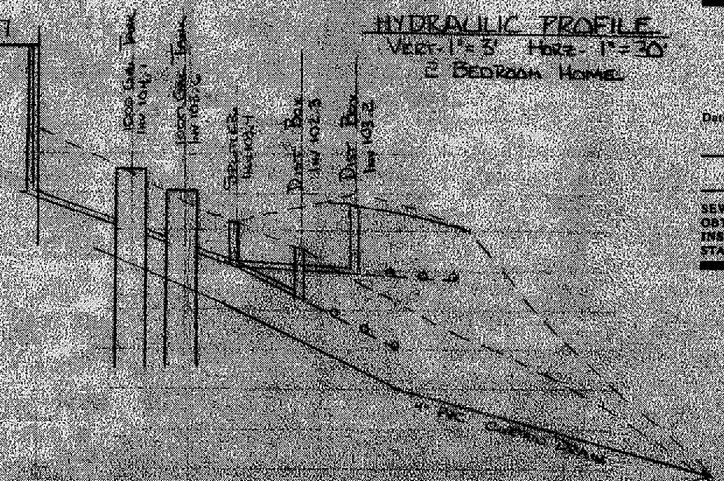

REVIEWED AND ACCEPTED
LAKE COUNTY GENERAL
HEALTH DISTRICT

Date 1-31-97 By J. Lichey

SEWAGE DISPOSAL PERMIT MUST BE OBTAINED BY A LAKE COUNTY LICENSED INSTALLER BEFORE INSTALLATION IS STARTED.

Jan. 29, 1997

I hereby certify that this topography, prepared by I. Corporation, and shown on this drawing, represents the actual ground elevations taken on the site, on the date shown, and that the water table was not encountered within the excavated holes.

Jan. 8, 1997

Grading Plan Approved as shown and/or noted
THOMAS P. GILLES, P.E.
Lake County Engineer

By _____ Date 1-1-97

REVIEWED
MADISON TOWNSHIP ZONING
MAR 25 1997
Date
Zoning Inspector

VILLAGE SURVEYING CO.
P.O. BOX 1096, FAIRPORT HARBOR, OHIO 44077
(216) 357-1359