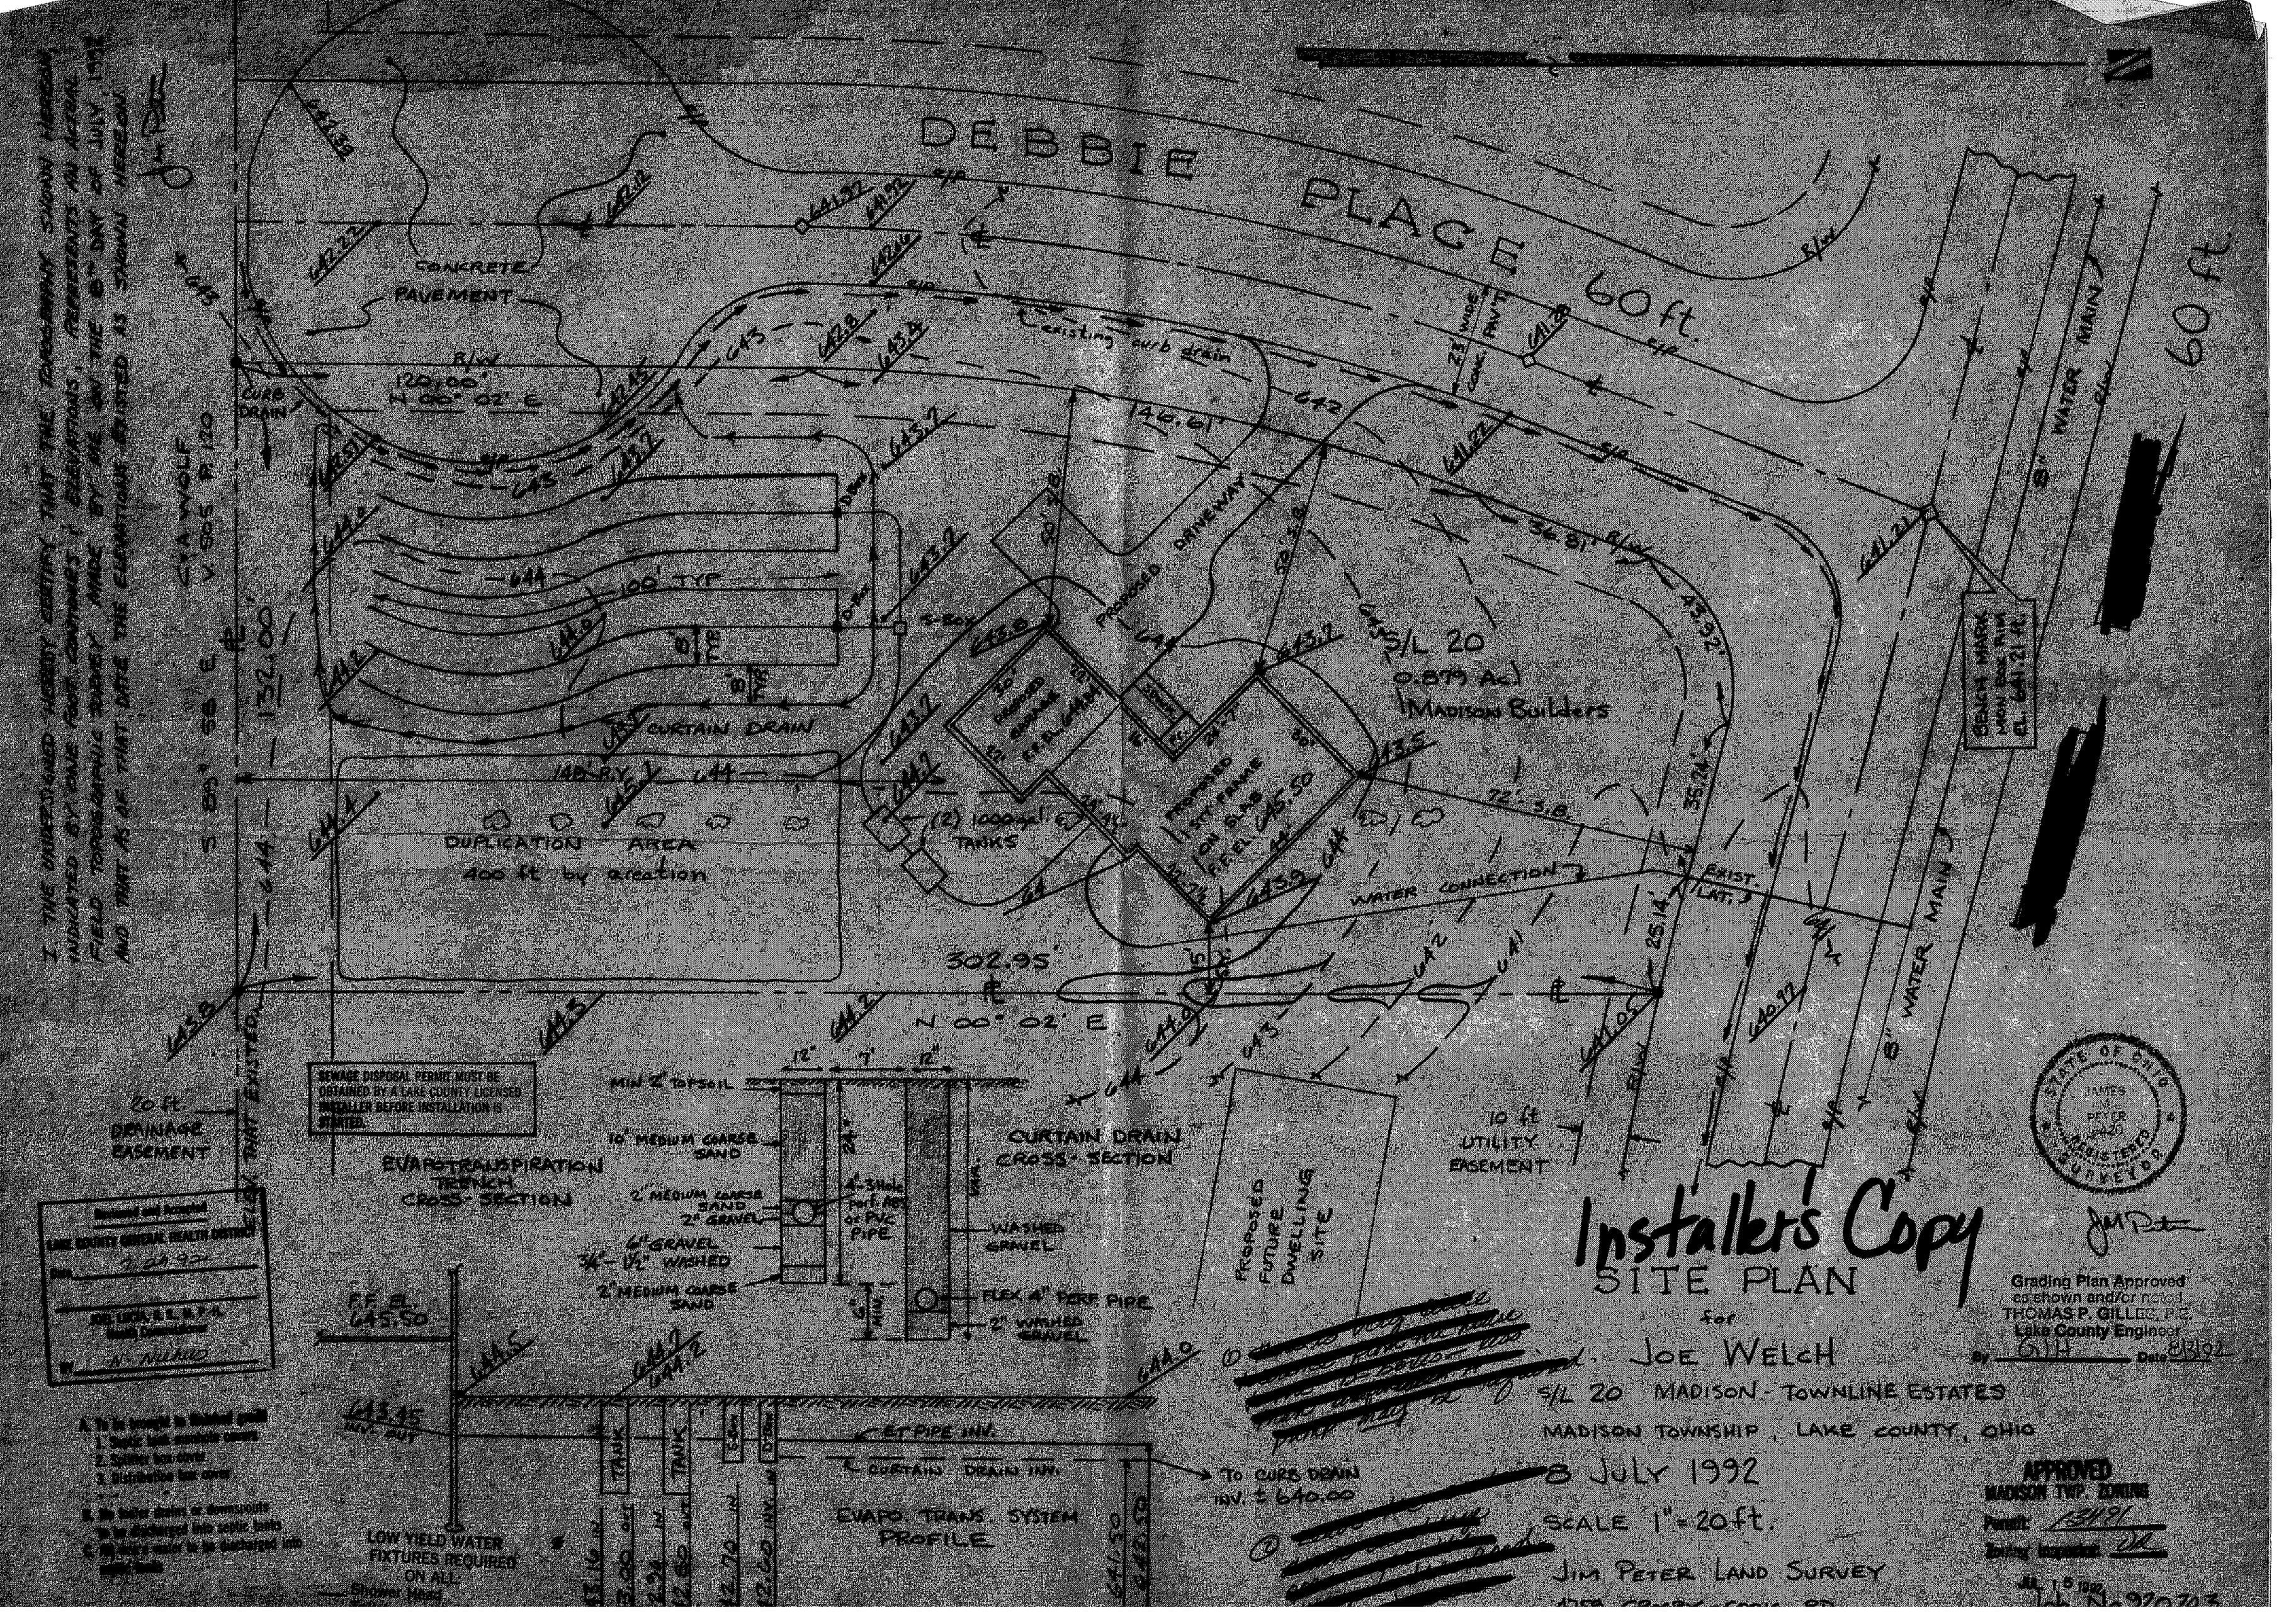I, THE UNDERSIGNED HEREBY CERTIFY THAT THE TOPOGRAPHY SHOWN HEREON INDICATED BY ONE FOOT CONTOURS, ELEVATIONS, PERTAINS AN ACTUAL FIELD TOPOGRAPHIC SURVEY MADE BY ME ON THE 6TH DAY OF JULY, 1992 AND THAT AS AN THAT DATE THE ELEVATION POINTED AS SHOWN HEREON.