LOCATION & GRADE PLAN
FOR S.L. 35

ARCOLE ESTATES
SUBDIVISION NO. 2
MADISON TOWNSHIP
LAKE COUNTY, OHIO
JUNE 1974

P 7124

...g Plan Approved
...own and/or noted
...AS P. GILLES, P.E.
...County Engineer
JK Date 6-25-74

Revised 7-1-74
To 100.10 JWK

EXISTING GRADE
00.0

PROPOSED GRADE
(00.0)

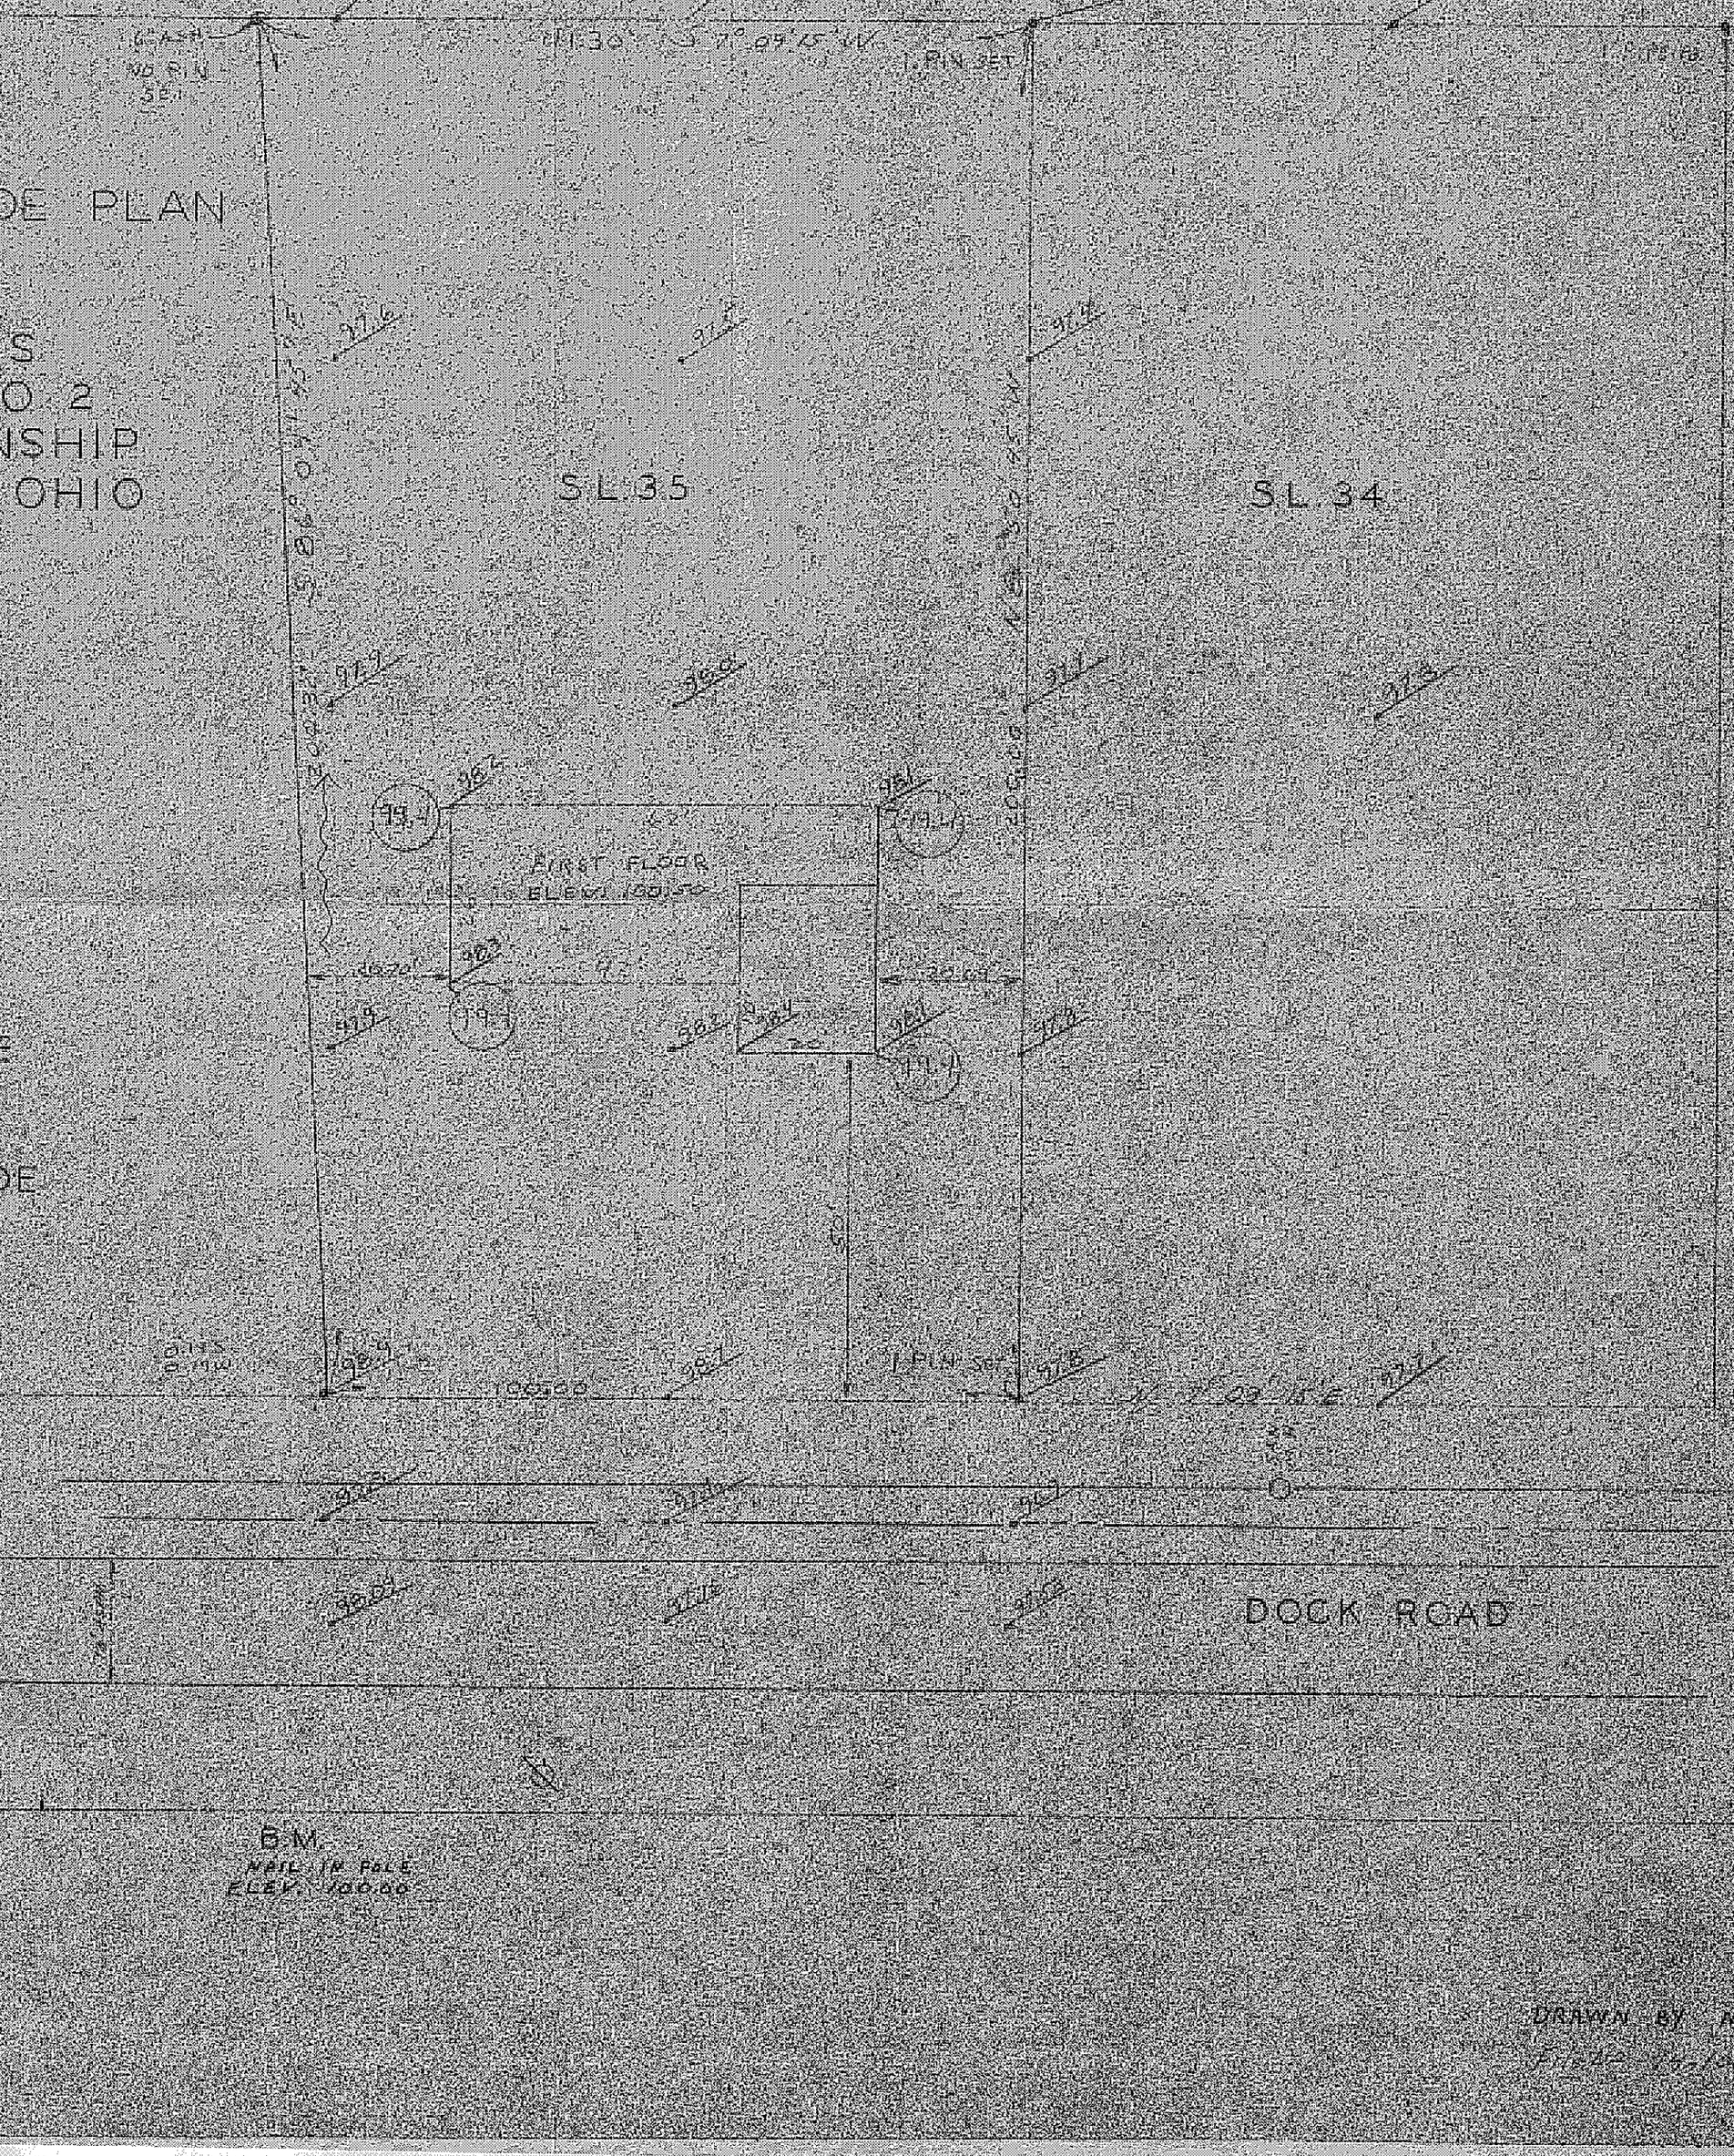

B.M.
NAIL IN POLE
ELEV. 100.00

DRAWN BY M.G.J.
Page 1 of 1