RECEIVED MAY 23 1988

SITE PLAN

— FOR —

TOM & SUE FOBELL

KNOWN AS BEING A PART OF LOT NO. 3, TRACT NO. 1, TOWN 12 AND SITUATED IN THE TOWNSHIP OF MADISON, COUNTY OF LAKE, AND STATE OF OHIO.

Grading Plan Approved as shown and/or noted
THOMAS P. GILLES, P.E.
Lake County Engineer
By _____ Date 5/23/88

See letter 8/4/88 to Fobell
Sample and pipe to be installed as per all Regulations (S.W.C.D.) to work along property line so as not to flow onto property to the south. Verified by phone from Mrs. Fobell on 11/15/88

BENCHMARK - 657.81'
NAIL IN POLE NO. 297623. DEVELOPED FROM LAKE COUNTY TOPO MAP.

SCALE: 1" = 20'

ALL BEARINGS SHOWN ARE TO AN ASSUMED MERIDIAN AND ARE USED TO DENOTE ANGLES ONLY.

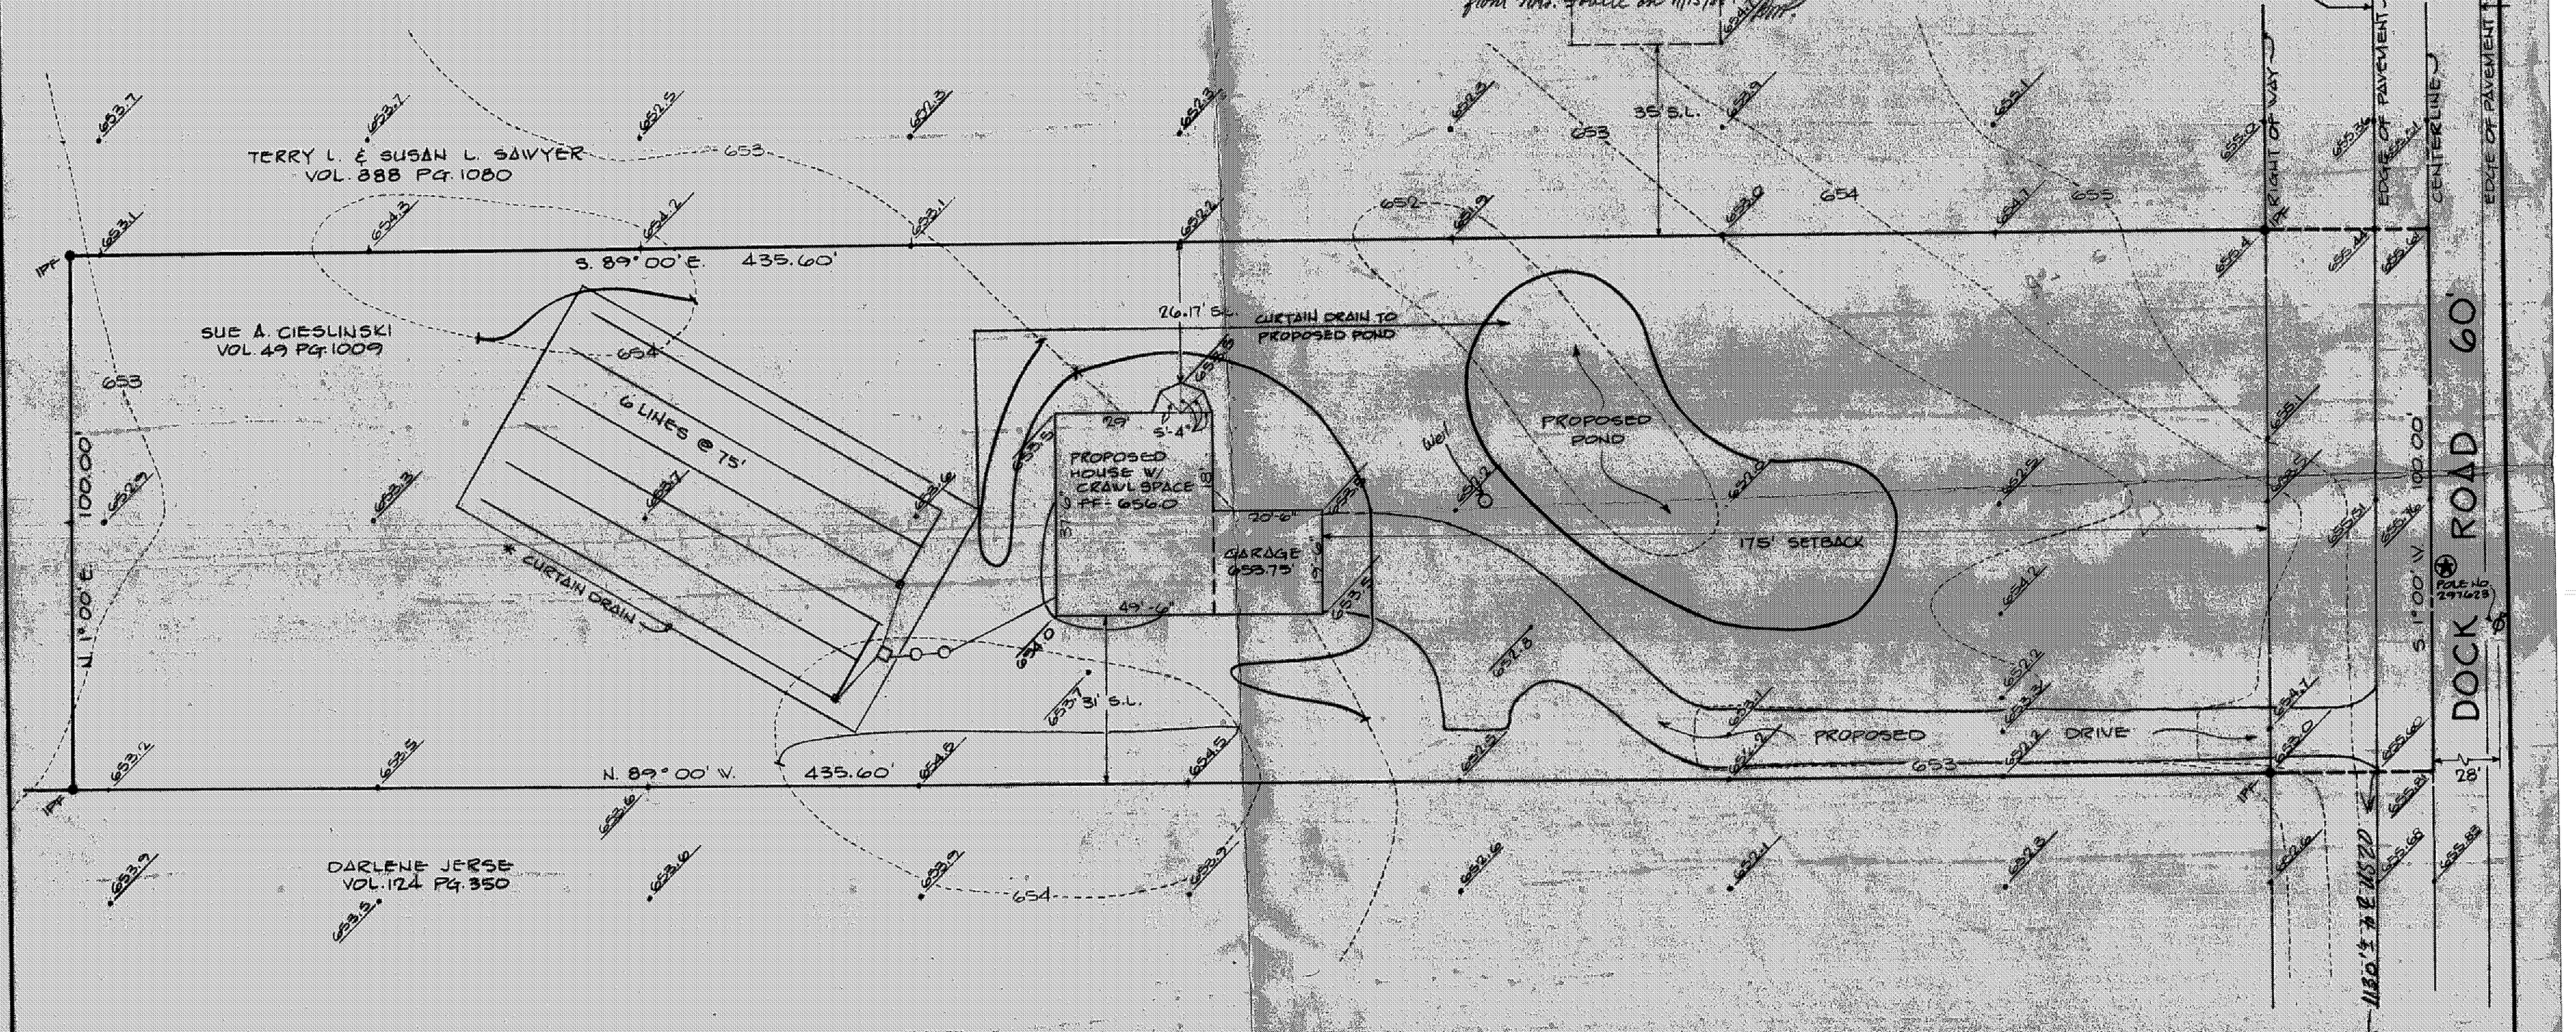

* CURTAIN DRAIN - MINIMUM 6" BELOW LEACH LINES

HYDRAULIC PROFILE

SCALE: HORZ. 1" = 40'
VERT. 1" = 4'

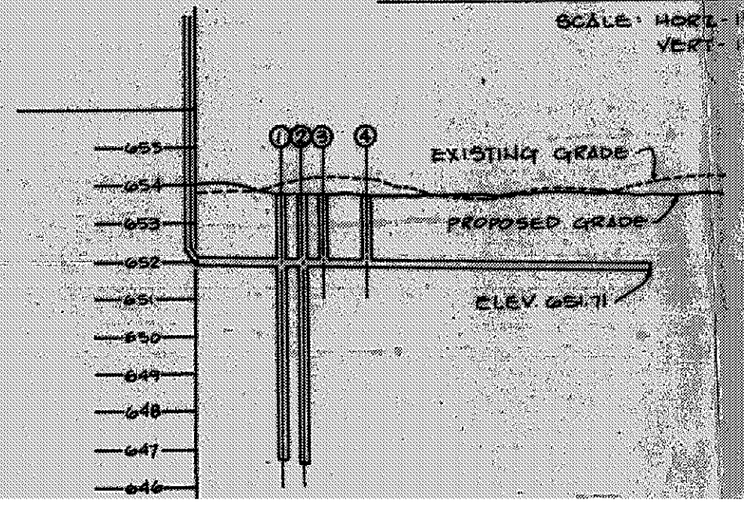

① 1000 GAL. TANK INV. 651.95
② 1000 GAL. TANK INV. 651.94
③ SPLITTER F/L 651.93
④ DIST. BOX F/L 651.90

APPROVED
MADISON TWP. ZONING
Permit: 12295
Zoning Inspector: _____

STATE OF OHIO
THOMAS MARC COFFMAN
6857
REGISTERED
SURVEYOR

THIS PLAT WAS PREPARED BY ME AND IS TRUE AND ACCURATE TO THE BEST OF MY KNOWLEDGE AND BELIEF.

Thomas M. Coffman P.S.
THOMAS M. COFFMAN No. 6857

VILLAGE SURVEYING CO.
THOMAS M. COFFMAN, P.S.
202 THIRD STREET, FAIRPORT HARBOR, OH. 44077
(216) 357-1359