SITE PLAN
CLETUS TURNER

KNOWN AS BEING PART OF LOT No. 14,
TRACT No. 1 NOW IN THE:
TOWNSHIP OF MADISON
COUNTY OF LAKE - STATE OF OHIO

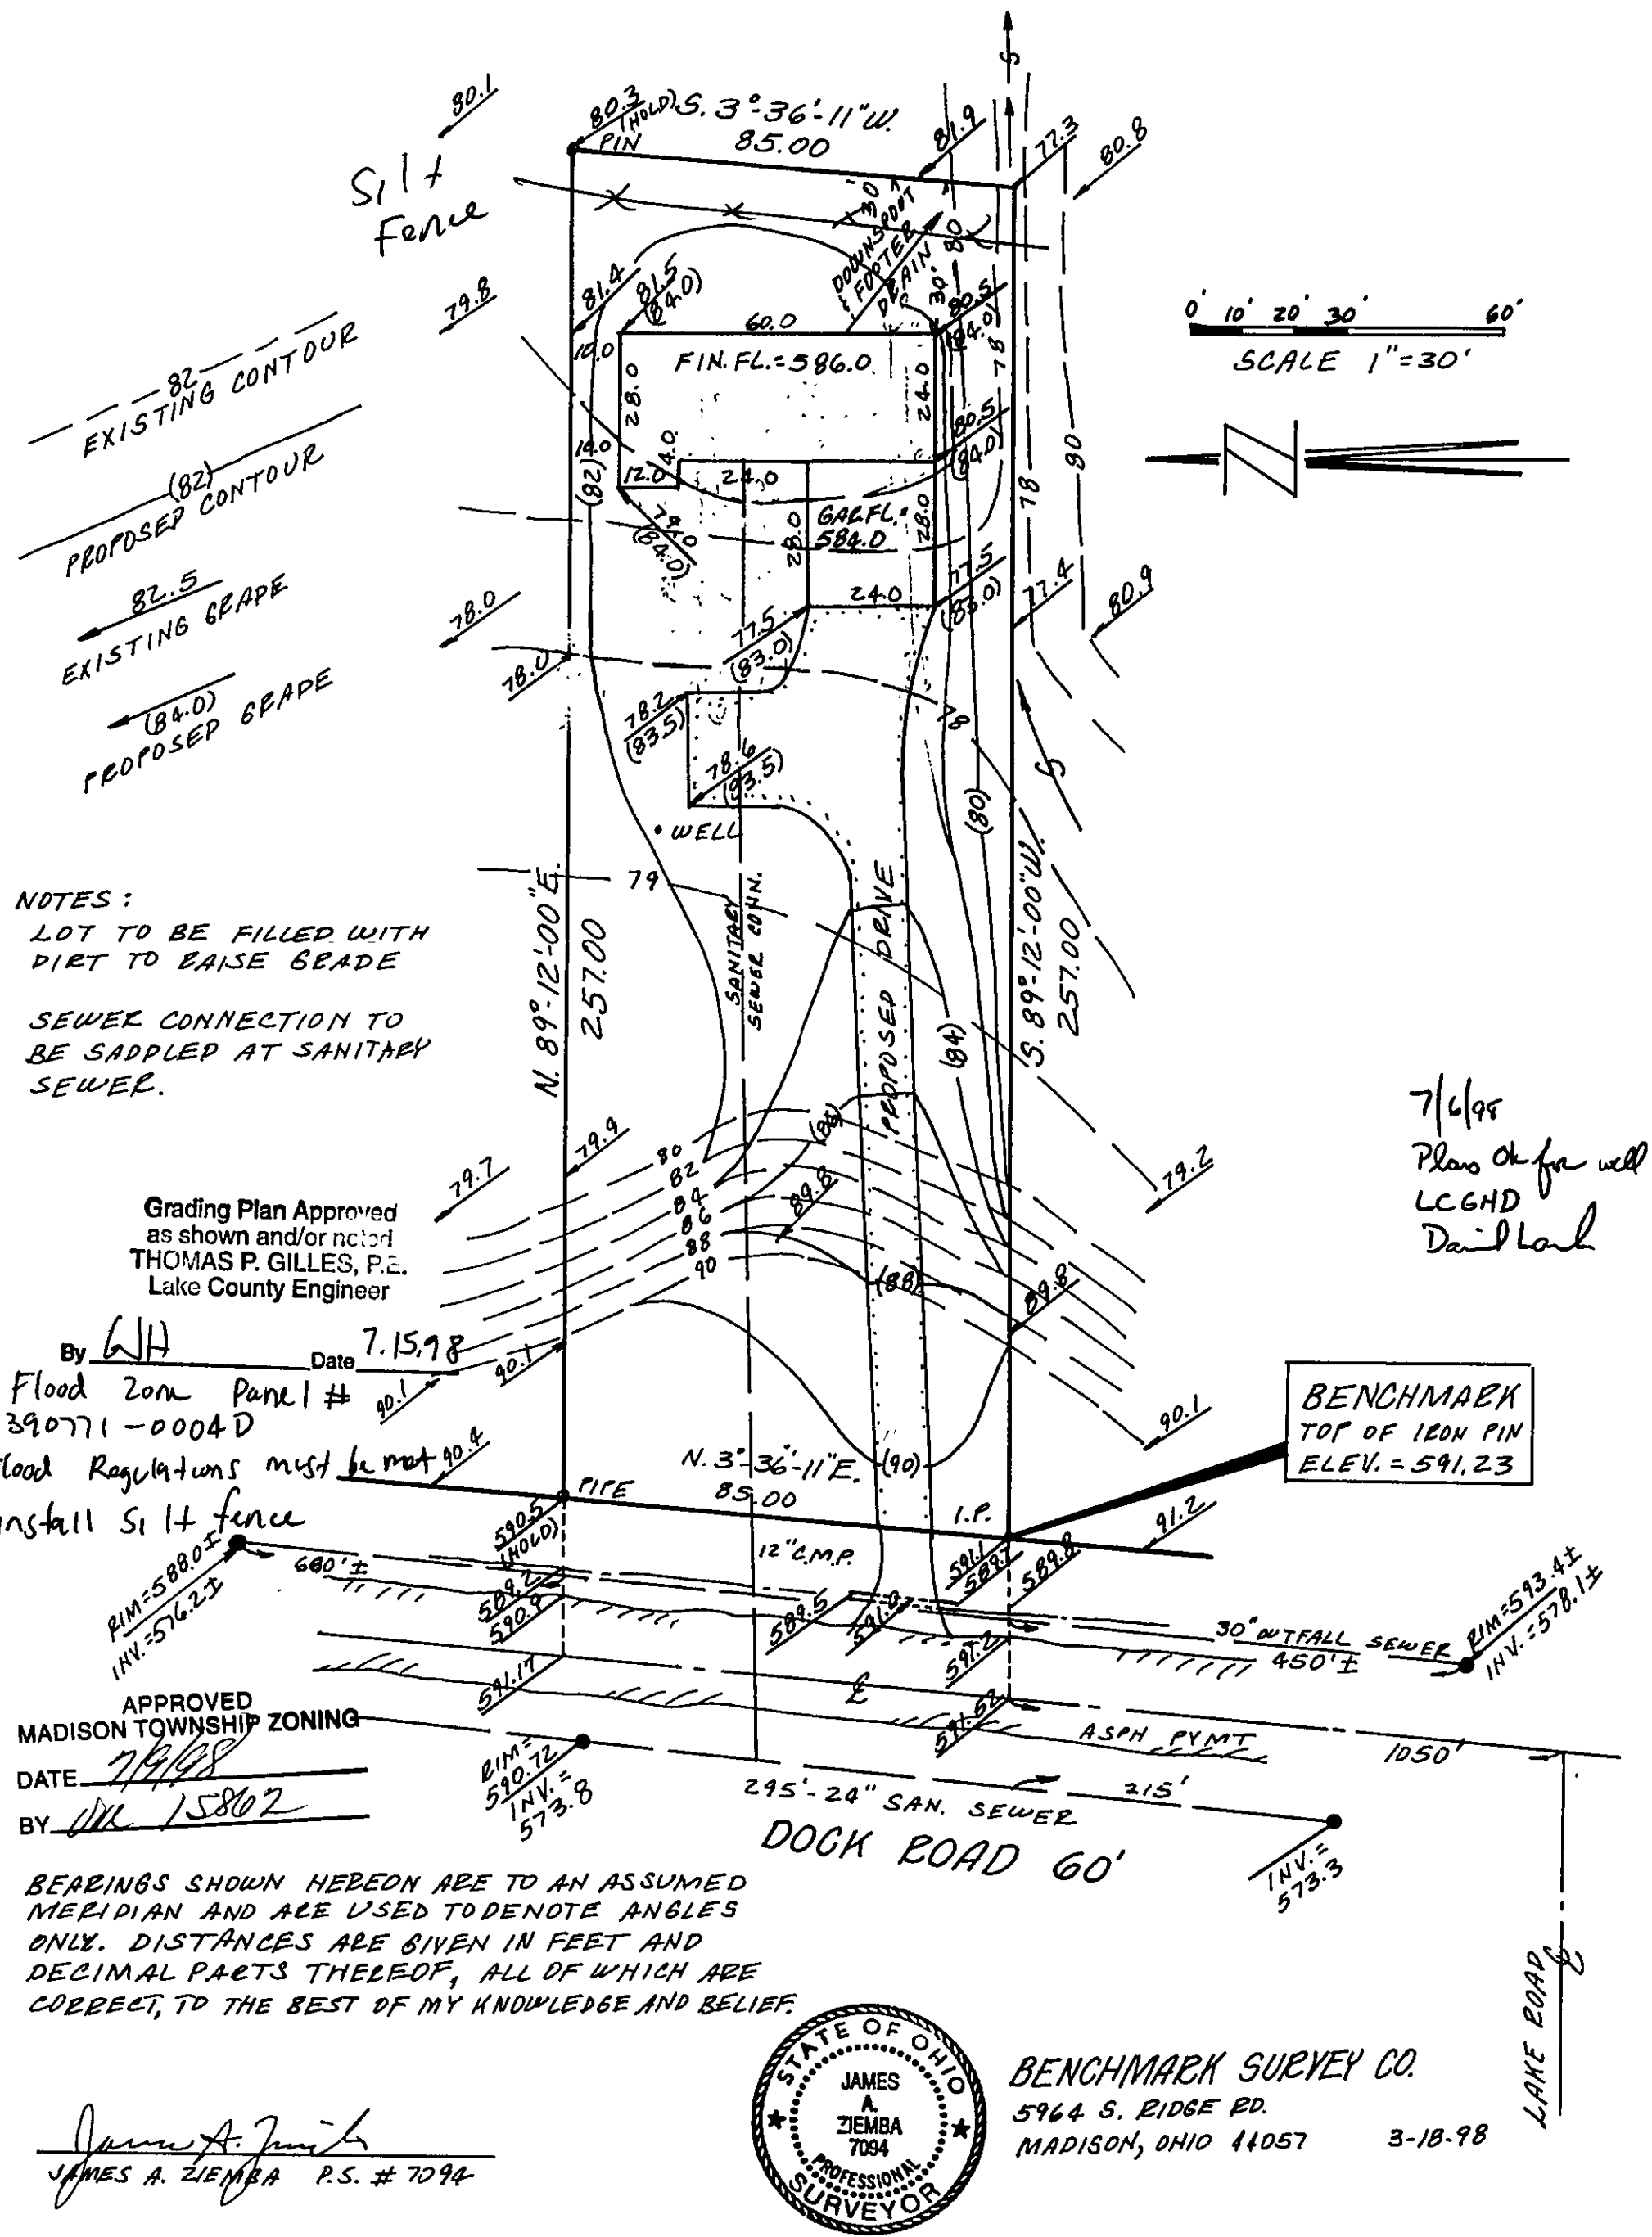

NOTES:
LOT TO BE FILLED WITH DIRT TO RAISE GRADE

SEWER CONNECTION TO BE TAPPED AT SANITARY SEWER.

Grading Plan Approved
as shown and/or noted
THOMAS P. GILLES, P.E.
Lake County Engineer
By GH Date 7.15.98

- Flood Zone Panel # 390771-0004D
- Flood Regulations must be met
- install Silt fence

7/6/98
Plans ok for well
LCGHD
David Lark

APPROVED
MADISON TOWNSHIP ZONING
DATE 7/9/98
BY JM 15802

BEARINGS SHOWN HEREON ARE TO AN ASSUMED MERIDIAN AND ARE USED TO DENOTE ANGLES ONLY. DISTANCES ARE GIVEN IN FEET AND DECIMAL PARTS THEREOF, ALL OF WHICH ARE CORRECT, TO THE BEST OF MY KNOWLEDGE AND BELIEF.

STATE OF OHIO
JAMES A. ZIEMBA 7094
PROFESSIONAL SURVEYOR

BENCHMARK SURVEY CO.
5964 S. RIDGE RD.
MADISON, OHIO 44057

3-18-98

JAMES A. ZIEMBA P.S. # 7094