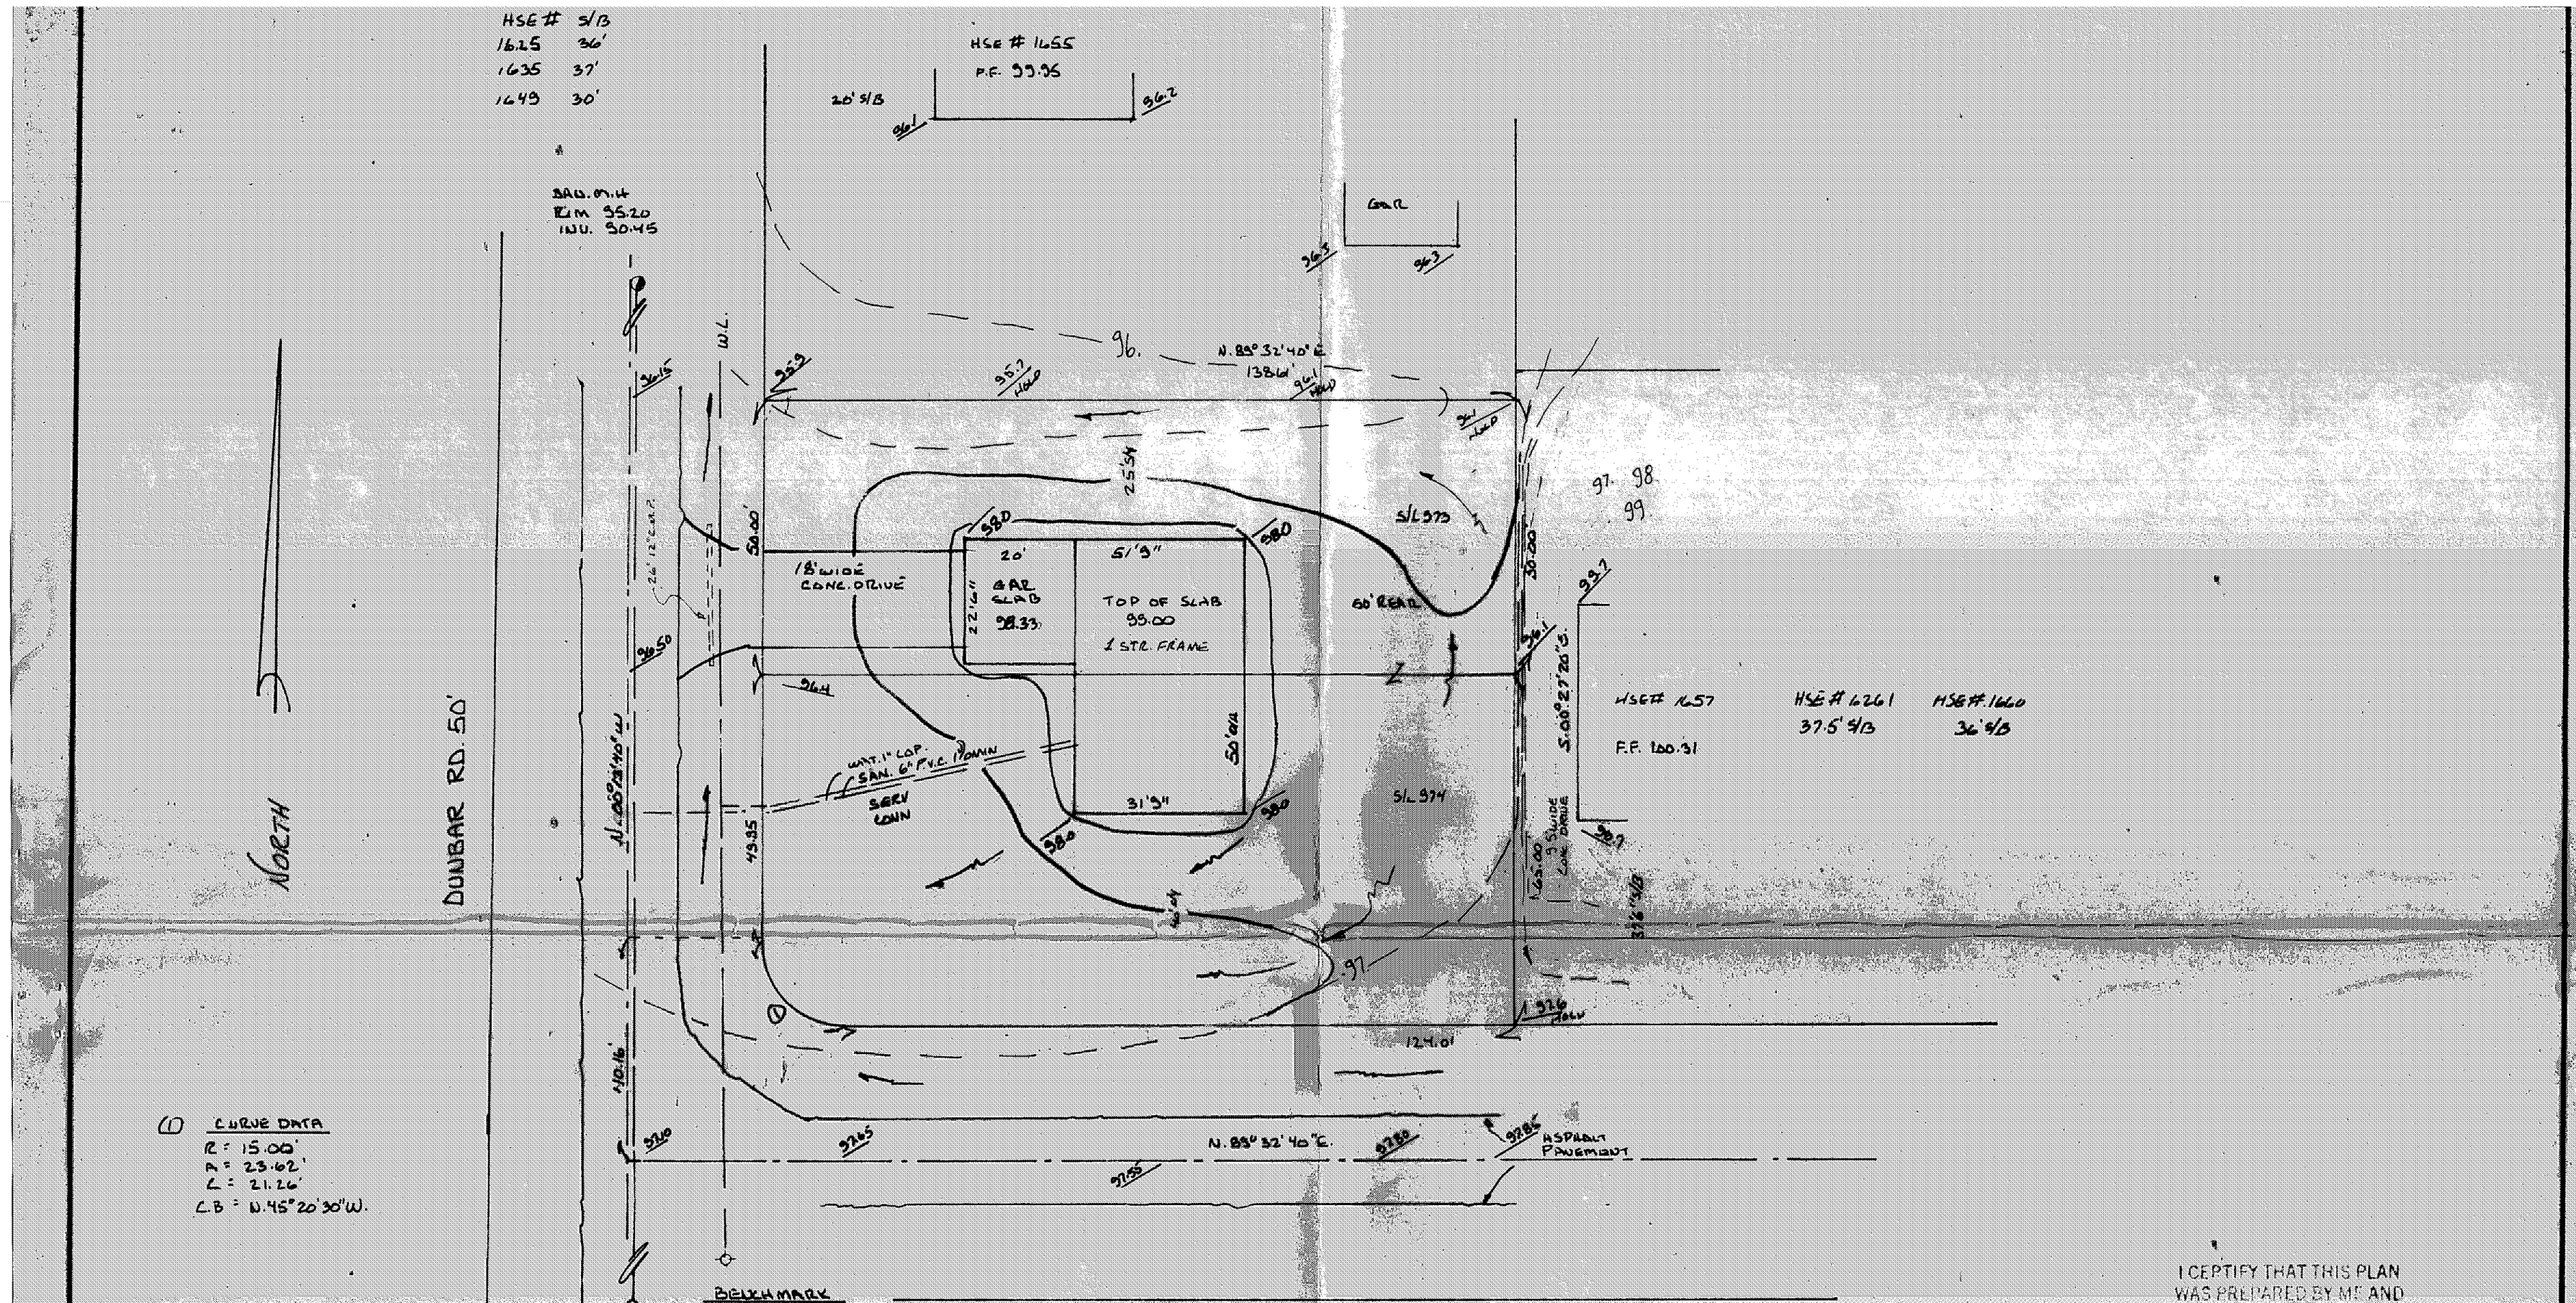

(1) CURVE DATA
R = 15.00'
A = 23.62'
L = 21.26'
C.B = N. 45° 20' 30" W.

I CERTIFY THAT THIS PLAN WAS PREPARED BY ME AND IS CORRECT TO THE BEST OF MY KNOWLEDGE AND BELIEF

REG. SURVEYOR 6356

JOHN C. SKONIECZNY
7739 VIEWMOUNT DR.
PAINESVILLE, OHIO 44077
PH. 352-7742

STATE OF OHIO
JOHN CLOUD SKONIECZNY
6356
REGISTERED SURVEYOR

EXISTING / PROPOSED GRADES

SWALE

Grading Plan Approved
as shown and/or noted
THOMAS P. GILLES, P.E.
Lake County Engineer
By GJH Date 7/3/95
& P# 14628 (6-30-95)

2 WORKING DAYS BEFORE YOU DIG
CALL TOLL FREE 800-362-2764
OHIO UTILITIES PROTECTION SERVICE

REVISIONS:
1 JULY 12, 1995 - ADD CONTOURS.

SITE PLAN FOR:
JERRY GRABNAR CONST.

SCALE: 1" = 20'	APPROVED BY	DRAWN BY JCS
DATE: JULY 93		

BEING SUBLOTS 973 & 974 IN THE MADISON GOLF LAKELANDS SUBDIVISION

JOB # 93-1677 — DRAWING NUMBER 93-1180