APPROVED
MADISON TWP. ZONING
Permit: 8713
Zoning Inspector: OKB

Grading Plan Approved
as shown and/or noted
THOMAS P. GILLES, P.E
Lake County Engineer
By TGG Date 22 Jan 73

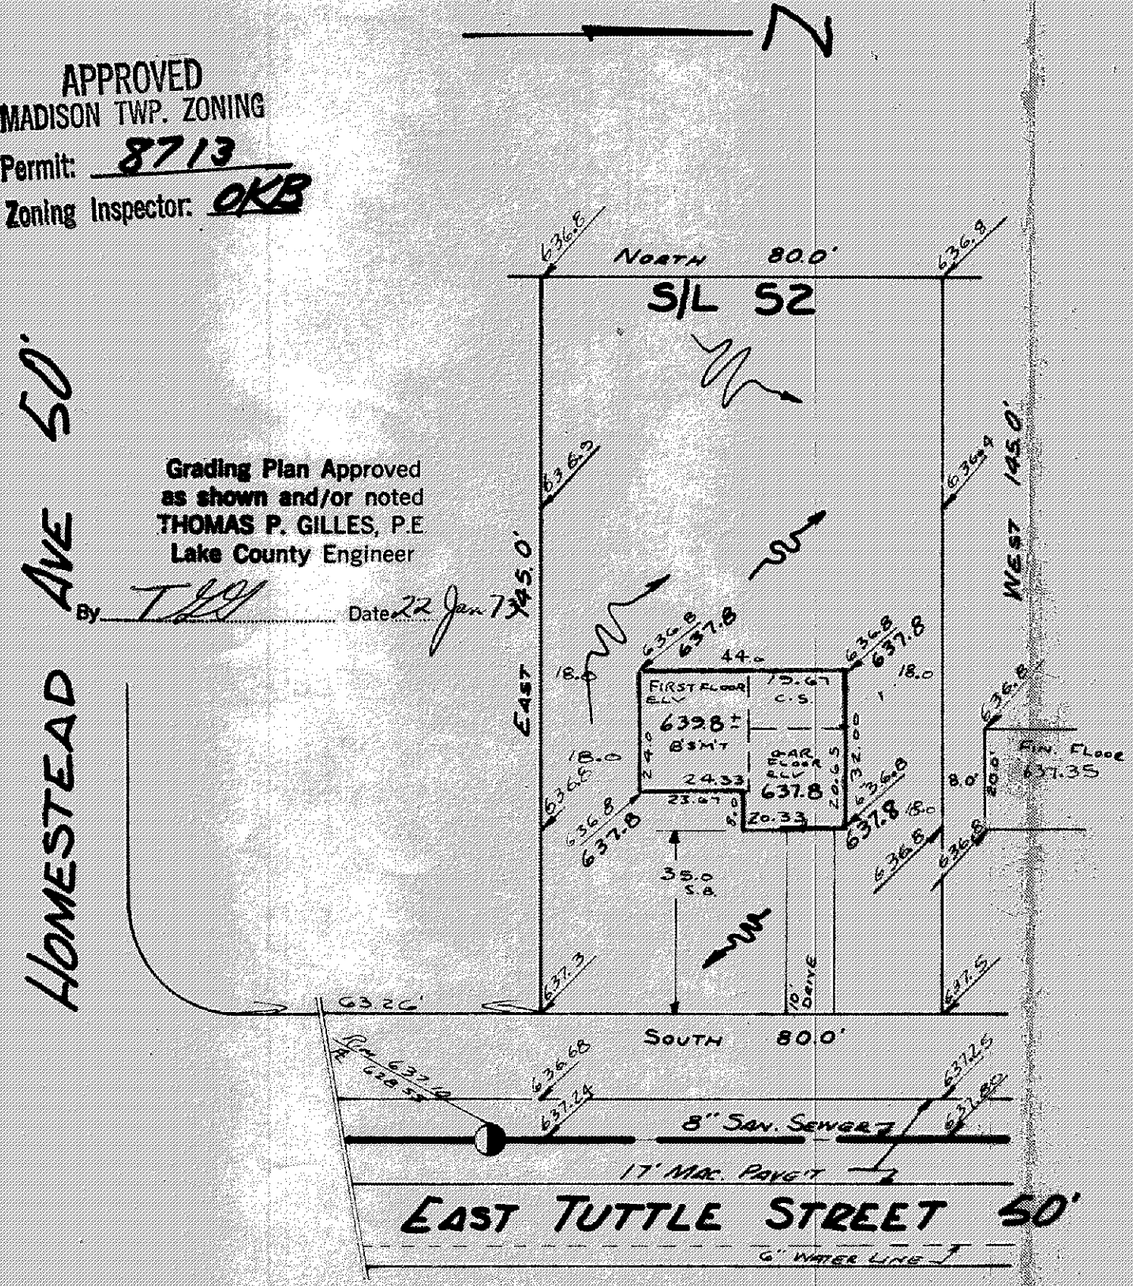

"AS BUILT" CERTIFICATION

I, HEREBY CERTIFY THAT THE CIRCLED GRADES ARE EXISTING FINISH GRADES CHECKED IN FIELD ON _____ 19__ BY _____ SURVEYING AND ARE CORRECT TO THE BEST OF MY KNOWLEDGE AND BELIEF.

REGISTERED SURVEYOR NO.

SITE PLAN

MADISON (TOWNSHIP) LAKE COUNTY, OHIO

for RYAN HOMES (CLIENT OWNER)

1940 East ~~Mad~~ Tuttle Park Madison
ADDRESS STREET CITY ZIP

NORTHERN LIGHTS
RECORD SUBDIVISION
G VOLUME 80 PAGE
52 SUBLOT NO. E. TUTTLE STREET

~~LOT~~ ~~TRACT~~
~~VOLUME~~ ~~PAGE~~
~~PERM. PARCEL #~~ ~~STREET~~

LEGEND

SANITARY MANHOLE
STORM MANHOLE
INLET OR CATCH BASIN
HYDRANT
EXISTING CONTOURS
PROPOSED CONTOURS
EXIST. ELEV. 100.0 / 100.0 PROP. ELEV.

WATER VALVE (GAS)
WATER METER (GAS)
AS BUILT ELEVATION
DIRECTION OF SURFACE DRAINAGE

REMARKS

ALL BOUNDARY DATA SHOWN WAS OBTAINED FROM (DEEDS, RECORDED SUBDIVISION PLAT, OR OTHER PUBLIC RECORDS)

DESIGN CERTIFICATION

THIS PLAT WAS PREPARED BY ME, AND IS CORRECT TO THE BEST OF MY KNOWLEDGE AND BELIEF.

Richard J. Bilski PS# 5244
NAME SURVEYOR REGISTRATION NO.

CHECK LIST

DIMENSIONS
BEARINGS
TIE TO NEAREST STREET
SUBLOT NO. PARCEL NO.
SURROUNDING OWNERS
BLDG DIMENSIONS FIN. GR.
BLDG TIES FLR GRADES
APRON: TYPE WIDTH THICKNESS
SIDEWALK TYPE WIDTH THICKNESS
CULVERT TYPE DIA LENGTH

WATER MAIN: SIZE LOCATION
SAN SEWER: SIZE % GR. LOC.
SAN. M.H.: CAST ELEV. INV. ELEV.
SAN. CONN: SIZE LOC. DEPTH
STORM SEWER: SIZE % GR. LOC.
STORM MH. CAST ELEV. INV. ELEV.
PAVT. TYPE GRADE CURBS
GAS LINE: LOC. SIZE PRESSURE
SEPTIC TANK: SIZE LOC.
WELL: LOCATION

REVISIONS		
NO	DATE	BY
1	Jan 1973	RJB
2		
3		
4		
5		

PLAN PREPARED BY:

DEBEVEC-SALO & ASSOC, INC.
CIVIL ENGINEERS - SURVEYORS NAME
130 E. JACKSON ST PAINESVILLE, O.
ADDRESS

DRAWN BY SWARTZ	SCALE 1" = 30'	PHONE NO.
CHK'D RJB	DATE JULY 72	DRAWING NO. 3528-52
CREW CHIEF	APP'D	