SITE PLAN

Madison TOWNSHIP LAKE COUNTY, OHIO

for: Ryan Homes CLIENT OWNER

1940 East Tuttle Park St. Madison 44057
ADDRESS STREET CITY ZIP

Northern Lights RECORD SUBDIVISION	LOT / TRACT
G / 80 VOLUME / PAGE	VOLUME / PAGE
52 SUBLOT NO. / E. Tuttle STREET	PERM. PARCEL # / STREET

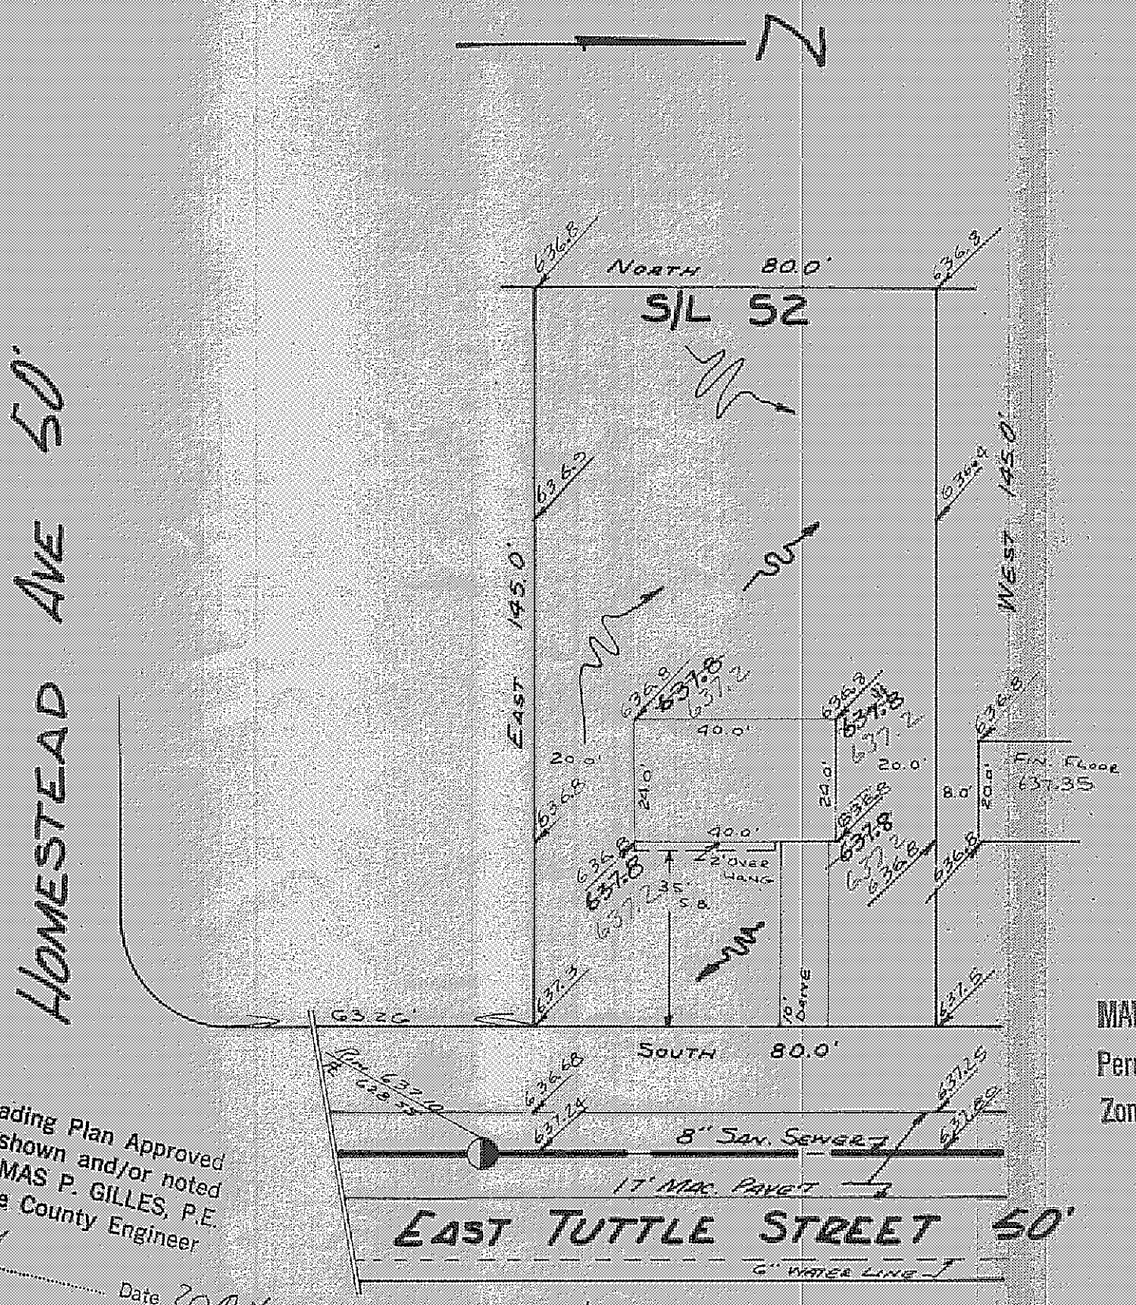

Grading Plan Approved
as shown and/or noted
THOMAS P. GILLES, P.E.
Lake County Engineer
By ____
Date 20 Oct 72

APPROVED
MADISON TWP. ZONING
Permit: 8561
Zoning Inspector: OKB

LEGEND

SANITARY MANHOLE	WATER VALVE (GAS)
STORM MANHOLE	WATER METER (GAS)
INLET OR CATCH BASIN	AS BUILT ELEVATION (100.0)
HYDRANT	DIRECTION OF SURFACE DRAINAGE
EXISTING CONTOURS	
PROPOSED CONTOURS	
EXIST. ELEV. 100.0 / 100.0 PROP. ELEV.	

REMARKS

ALL BOUNDARY DATA SHOWN WAS OBTAINED FROM (DEEDS, RECORDED SUBDIVISION PLAT, OR OTHER PUBLIC RECORDS)

DESIGN CERTIFICATION

THIS PLAT WAS PREPARED BY ME, AND IS CORRECT TO THE BEST OF MY KNOWLEDGE AND BELIEF.

Richard L. Bleile PS #5244
NAME SURVEYOR REGISTRATION NO.

CHECK LIST

- DIMENSIONS
- BEARINGS
- TIE TO NEAREST STREET
- SUBLOT NO. PARCEL NO.
- SURROUNDING OWNERS
- BLDG DIMENSIONS FIN. GR.
- BLDG TIES FLR. GRADES
- APRON: TYPE WIDTH THICKNESS
- SIDEWALK: TYPE WIDTH THICKNESS
- CULVERT TYPE DIA. LENGTH
- WATER MAIN: SIZE LOCATION
- SAN. SEWER: SIZE % GR. LOC.
- SAN. M.H.: CAST ELEV. INV. ELEV.
- SAN. CONN: SIZE LOC. DEPTH
- STORM SEWER: SIZE % GR. LOC.
- STORM MH.: CAST ELEV. INV. ELEV.
- PAVT. TYPE GRADE CURBS
- GAS LINE: LOC. SIZE: PRESSURE
- SEPTIC TANK: SIZE LOC.
- WELL: LOCATION

"AS BUILT" CERTIFICATION

I, HEREBY CERTIFY THAT THE CIRCLED GRADES ARE EXISTING FINISH GRADES CHECKED IN FIELD ON _____ 19__ BY _____ SURVEYING AND ARE CORRECT TO THE BEST OF MY KNOWLEDGE AND BELIEF

_____ NO.
REGISTERED SURVEYOR

REVISIONS		
NO	DATE	BY
1		
2		
3		
4		
5		

PLAN PREPARED BY:

DEBEVEC-SALO & ASSOC., INC.
CIVIL ENGINEERS — SURVEYORS NAME
130 E. JACKSON ST. PAINESVILLE, O.
ADDRESS

DRAWN BY Swartz	SCALE 1" = 30'	PHONE NO.
CHK'D RJB	DATE July 72	DRAWING NO. 3528
CREW CHIEF	APP'D	