SITE PLAN
FOR
TOM VISEL

BEING S/L 520 OF MADISON LAKELANDS SUB'D II IN MADISON TOWNSHIP, LAKE COUNTY, OHIO.

ADDRESS	SETBACK
1541	35'
1547	39.5'
1561	38'
1567	37'
AVE	37.4'

APPROVED
MADISON TWP. ZONING
Permit: 14295
Zoning Inspector
SEP. 13 1994

I, the undersigned hereby certify that this topography, indicated by 1' contours, and elevations shown hereon represent an actual field survey made by me on June 23, 1994 and that the elevations were taken at appropriate intervals and that as of that date they existed as indicated hereon.

J. M. Coffman P.S. No 6857

STATE OF OHIO
THOMAS MARC COFFMAN
6857
REGISTERED SURVEYOR
July 14, 1994

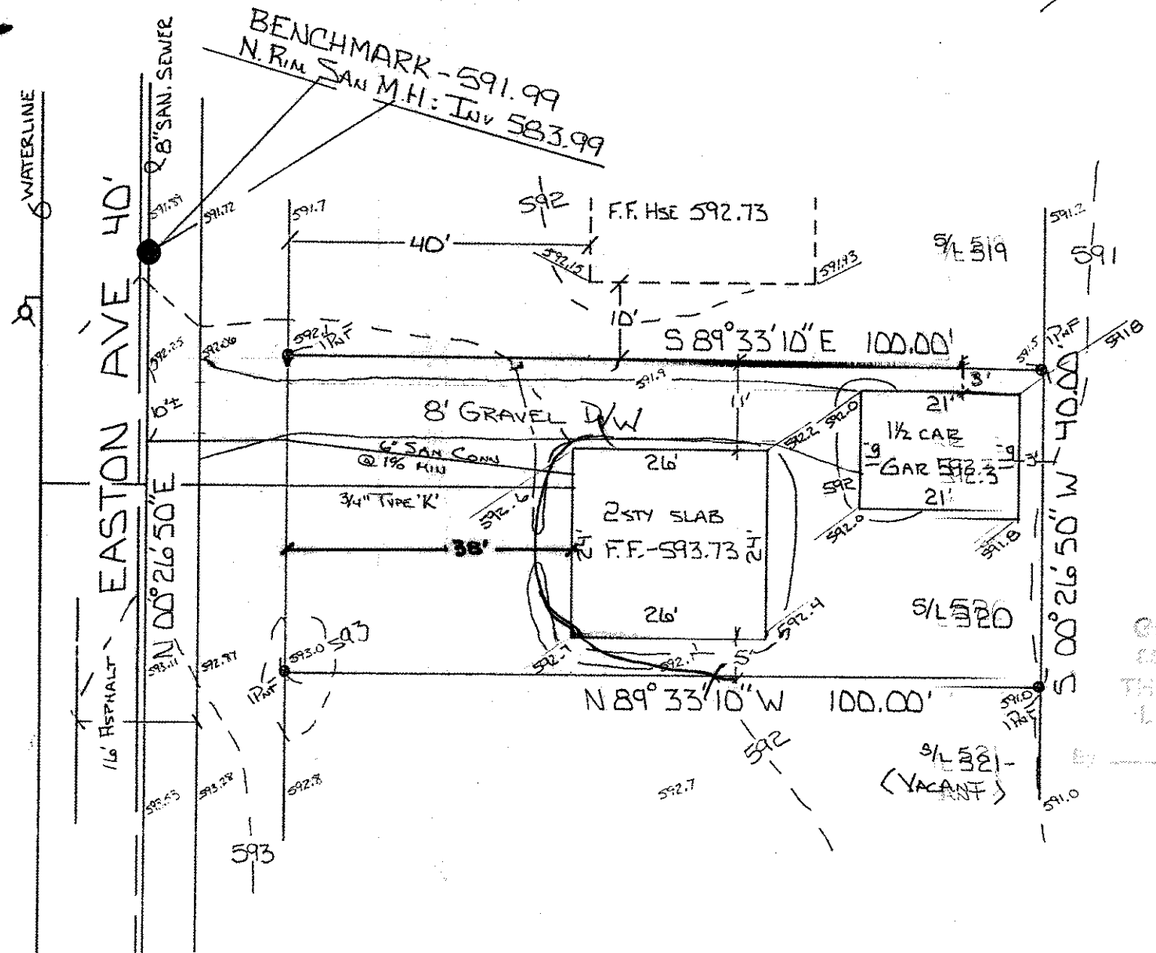

Grading Plan Approved as shown and/or noted
THOMAS P. GILLES, P.E.
Lake County Engineer
By GIH Date 9 20 94

VILLAGE SURVEYING CO.
P.O. BOX 1096 FAIRPORT HARBOR, OHIO. 44077
(216) 357-1359