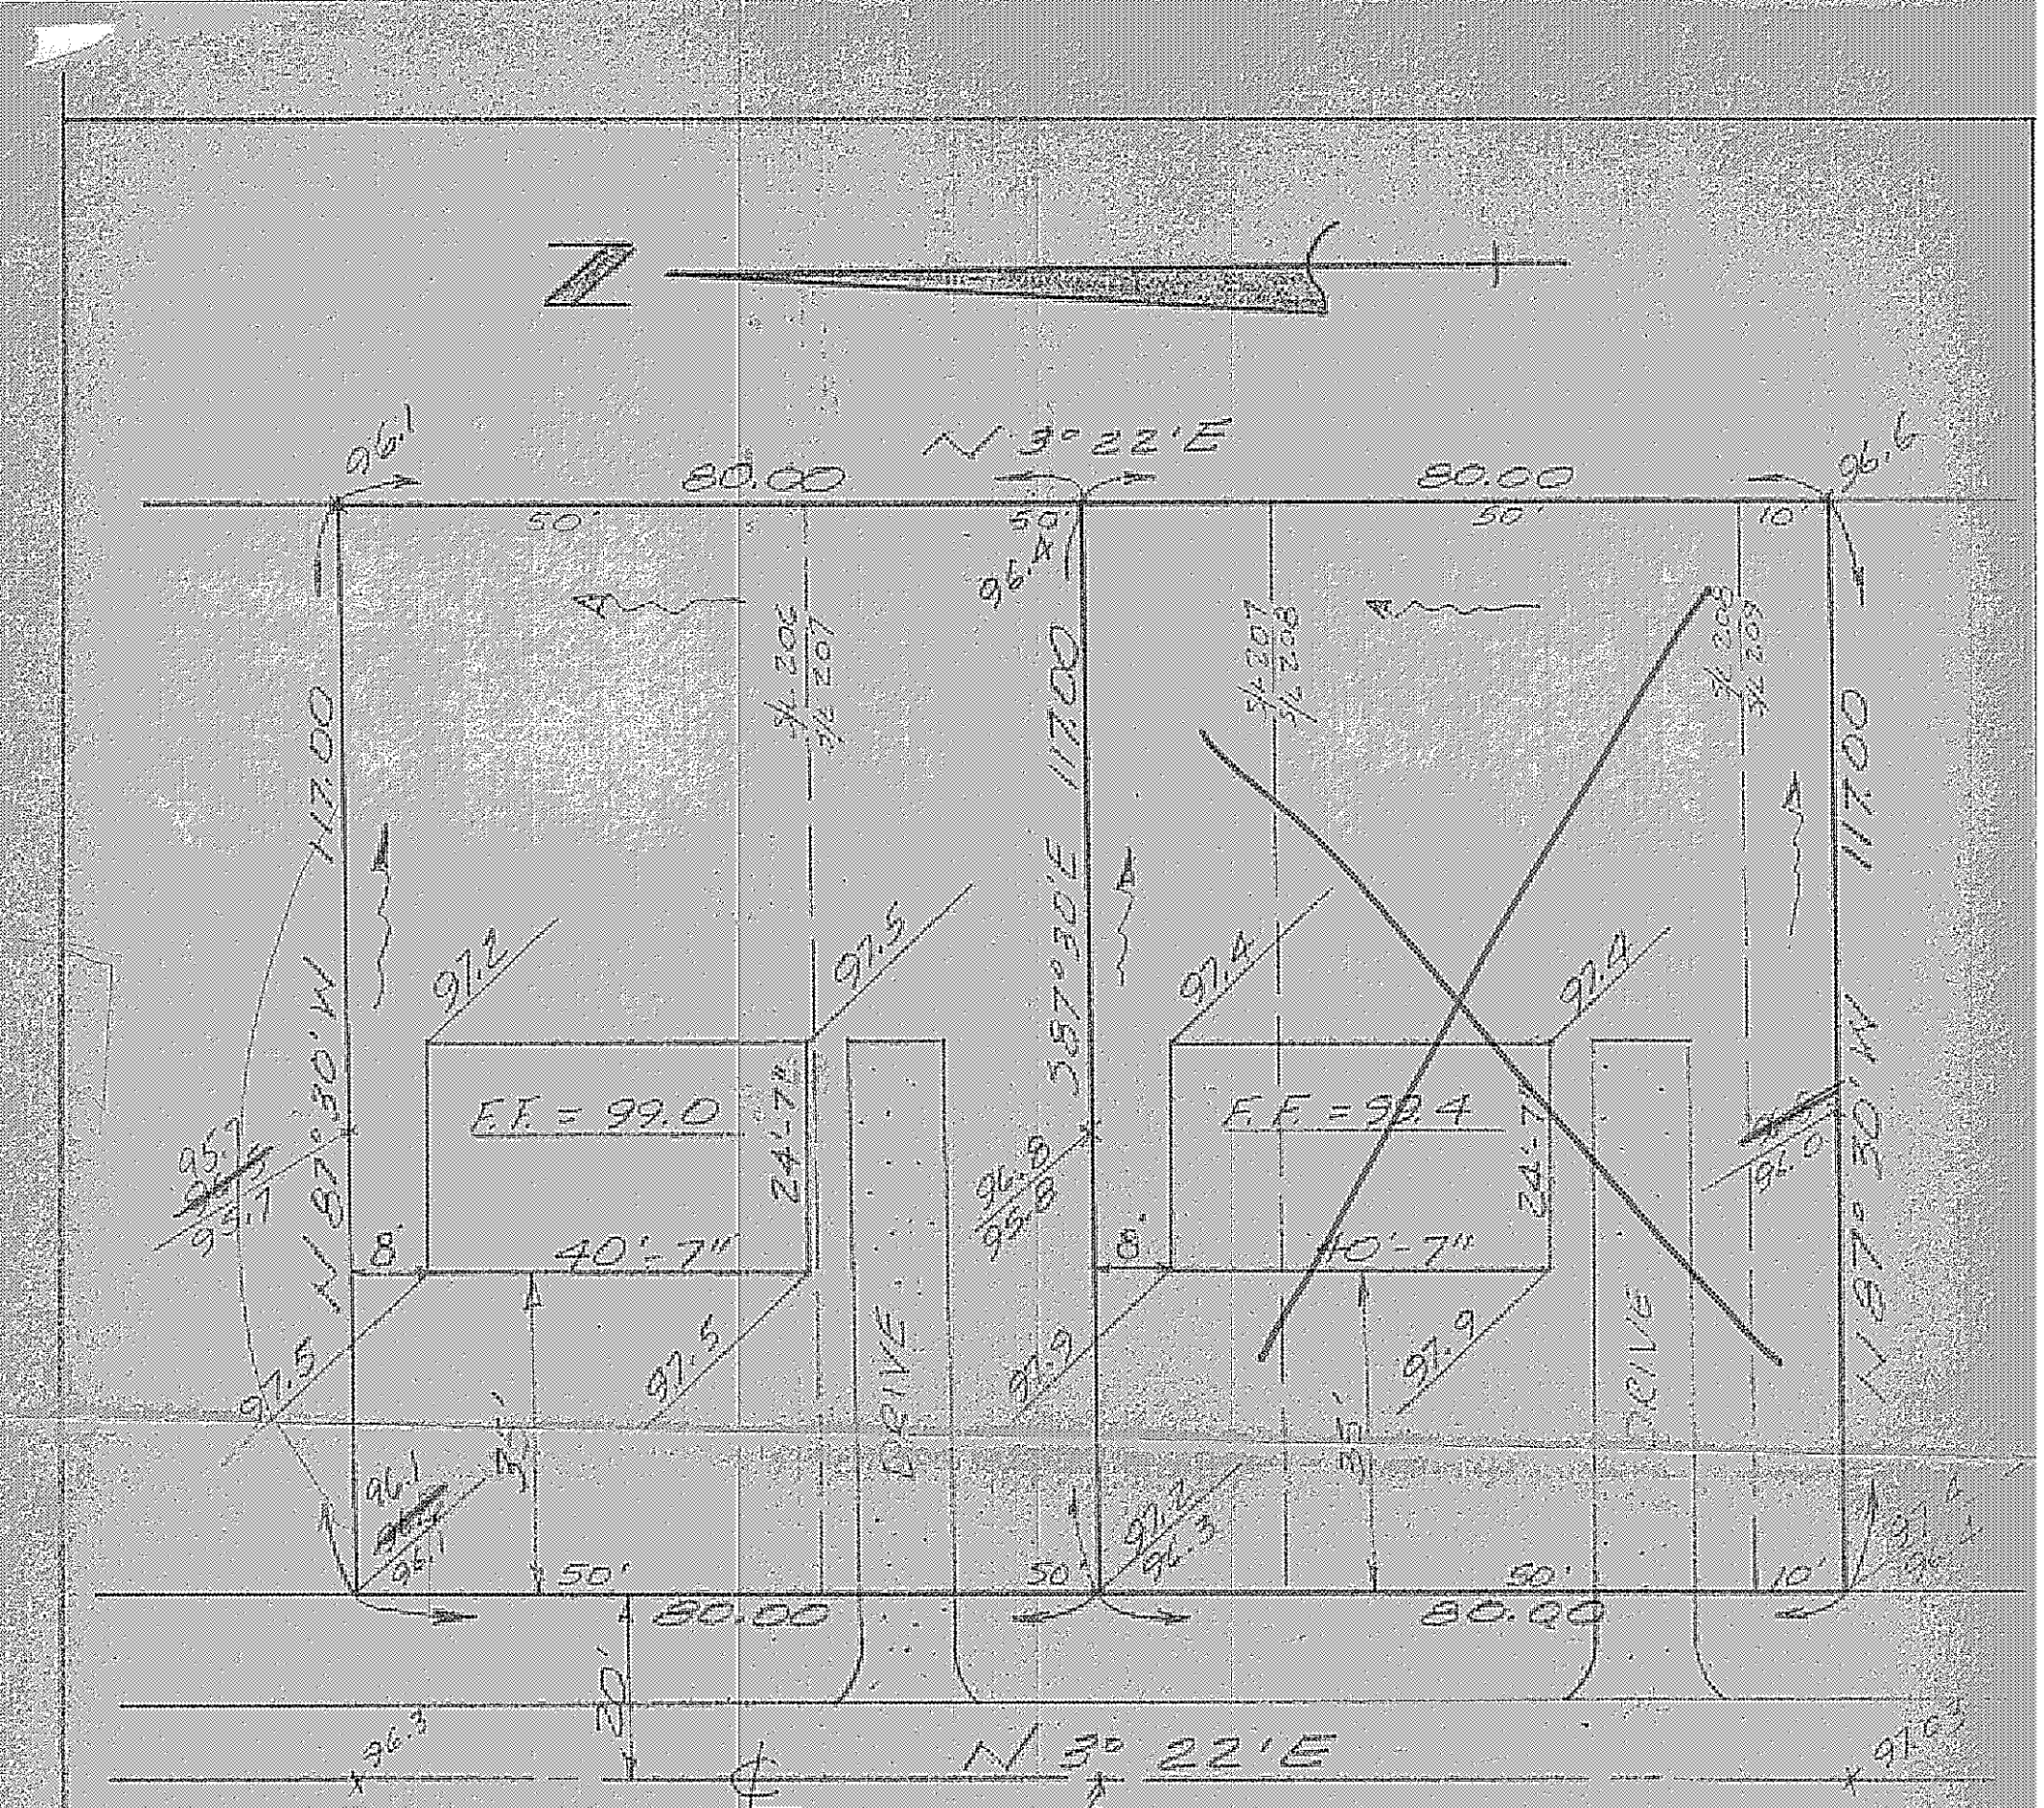

Grading Plan Approved
as shown and/or noted
THOMAS P. GILLES, P.E.
Lake County Engineer
By TPG Date 15 Dec 72

APPROVED
MADISON TWP. ZONING
Permit 8698
Zoning Inspector

GRADING PLAN
FOR
CINOER CONSTRUCTION CO.
PL 206, 207, 208 & PART OF 209 LAKE BREEZE PARK
MADISON TWP. — LAKE COUNTY, OHIO
SCALE: 1" = 20' SEPT. 1972

AS BUILT CERTIFICATION
I HEREBY CERTIFY THAT THE CIRCLED GRADES
ARE EXISTING FINISH
GRADES CHECKED IN THE FIELD ON _____ 197____
SURVEY IS CORRECT TO THE BEST OF MY KNOWLEDGE
AND BELIEF.

FULLERTON-KERR & ASSOC.
BY _____
REG. SURVEYOR No.