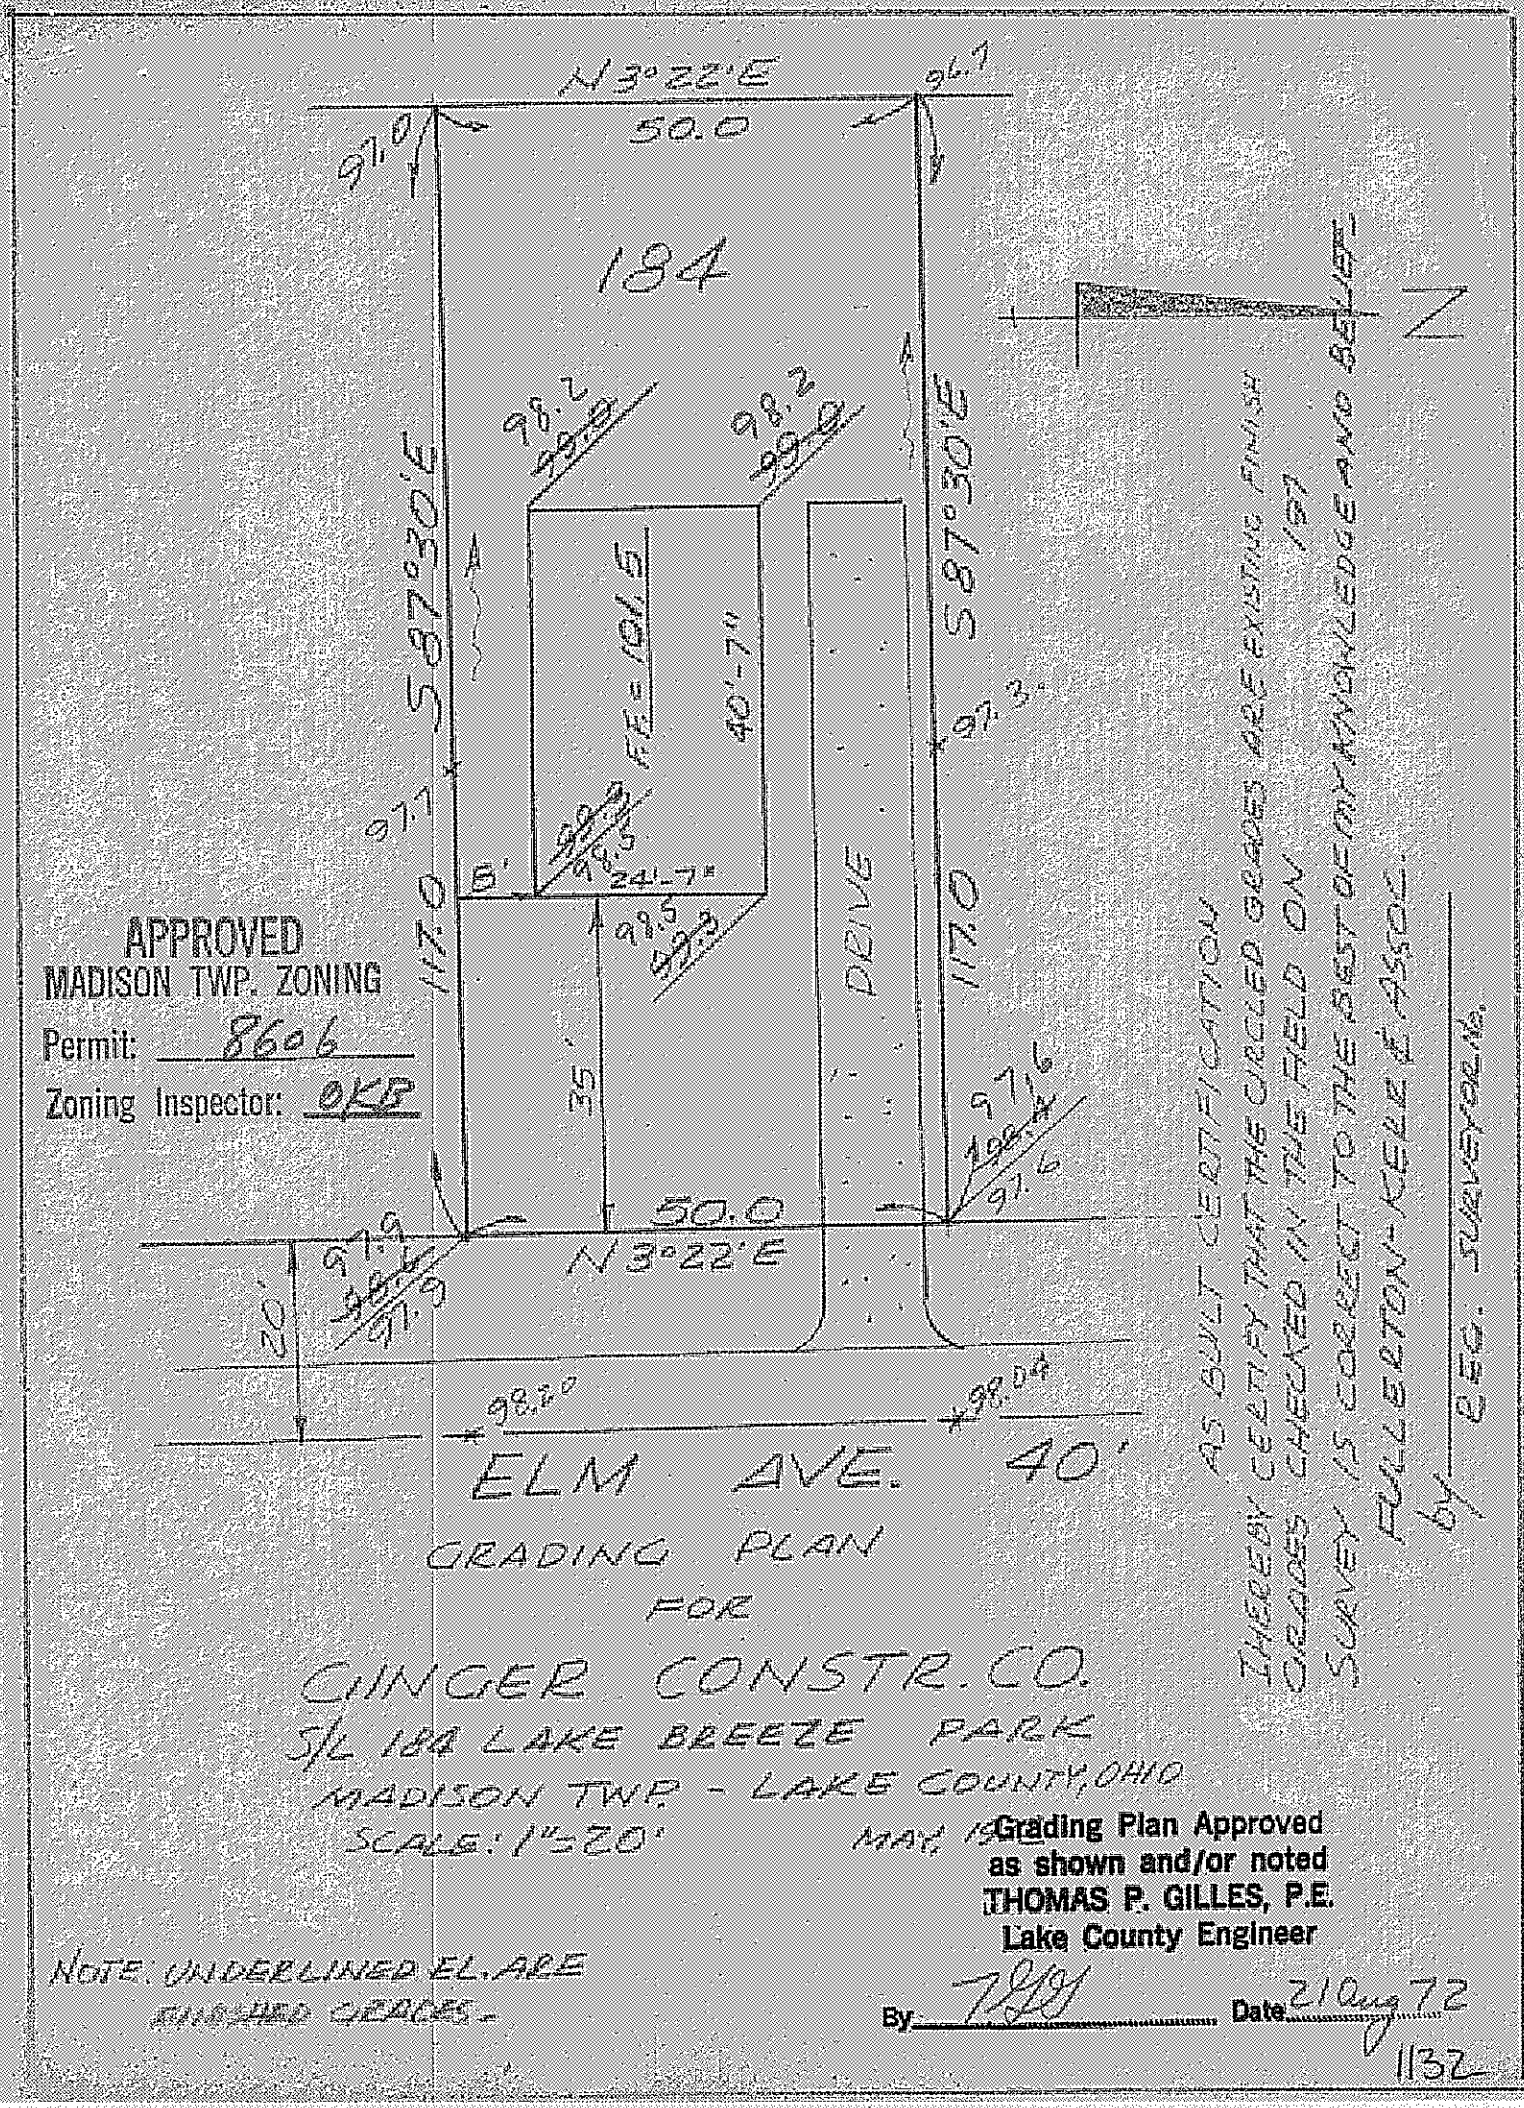
N 3°22'E
50.0
97.0
96.7
184
98.2
98.2
S 87°30'E
S 87°30'E
F.F. = 101.5
40'-7"
97.7
97.3
8'
24'-7"
98.5
98.5
117.0
117.0
DRIVE
35'
97.6
97.6
50.0
N 3°22'E
97.9
97.9
20'
98.20
98.04
ELM AVE. 40'
N
AS BUILT CERTIFICATION
I HEREBY CERTIFY THAT THE CIRCLED GRADES ARE EXISTING FINISH
GRADES CHECKED IN THE FIELD ON 197
SURVEY IS CORRECT TO THE BEST OF MY KNOWLEDGE AND BELIEF
FULLERTON-KERR & ASSOC.
by REG. SURVEYOR No.
APPROVED
MADISON TWP. ZONING
Permit: 8606
Zoning Inspector: OKB
GRADING PLAN
FOR
GINGER CONSTR. CO.
S/L 184 LAKE BREEZE PARK
MADISON TWP. - LAKE COUNTY, OHIO
SCALE: 1"=20'
MAY, 19
Grading Plan Approved
as shown and/or noted
THOMAS P. GILLES, P.E.
Lake County Engineer
By
Date 21 Aug 72
NOTE: UNDERLINED EL. ARE
FINISHED GRADES.
1132