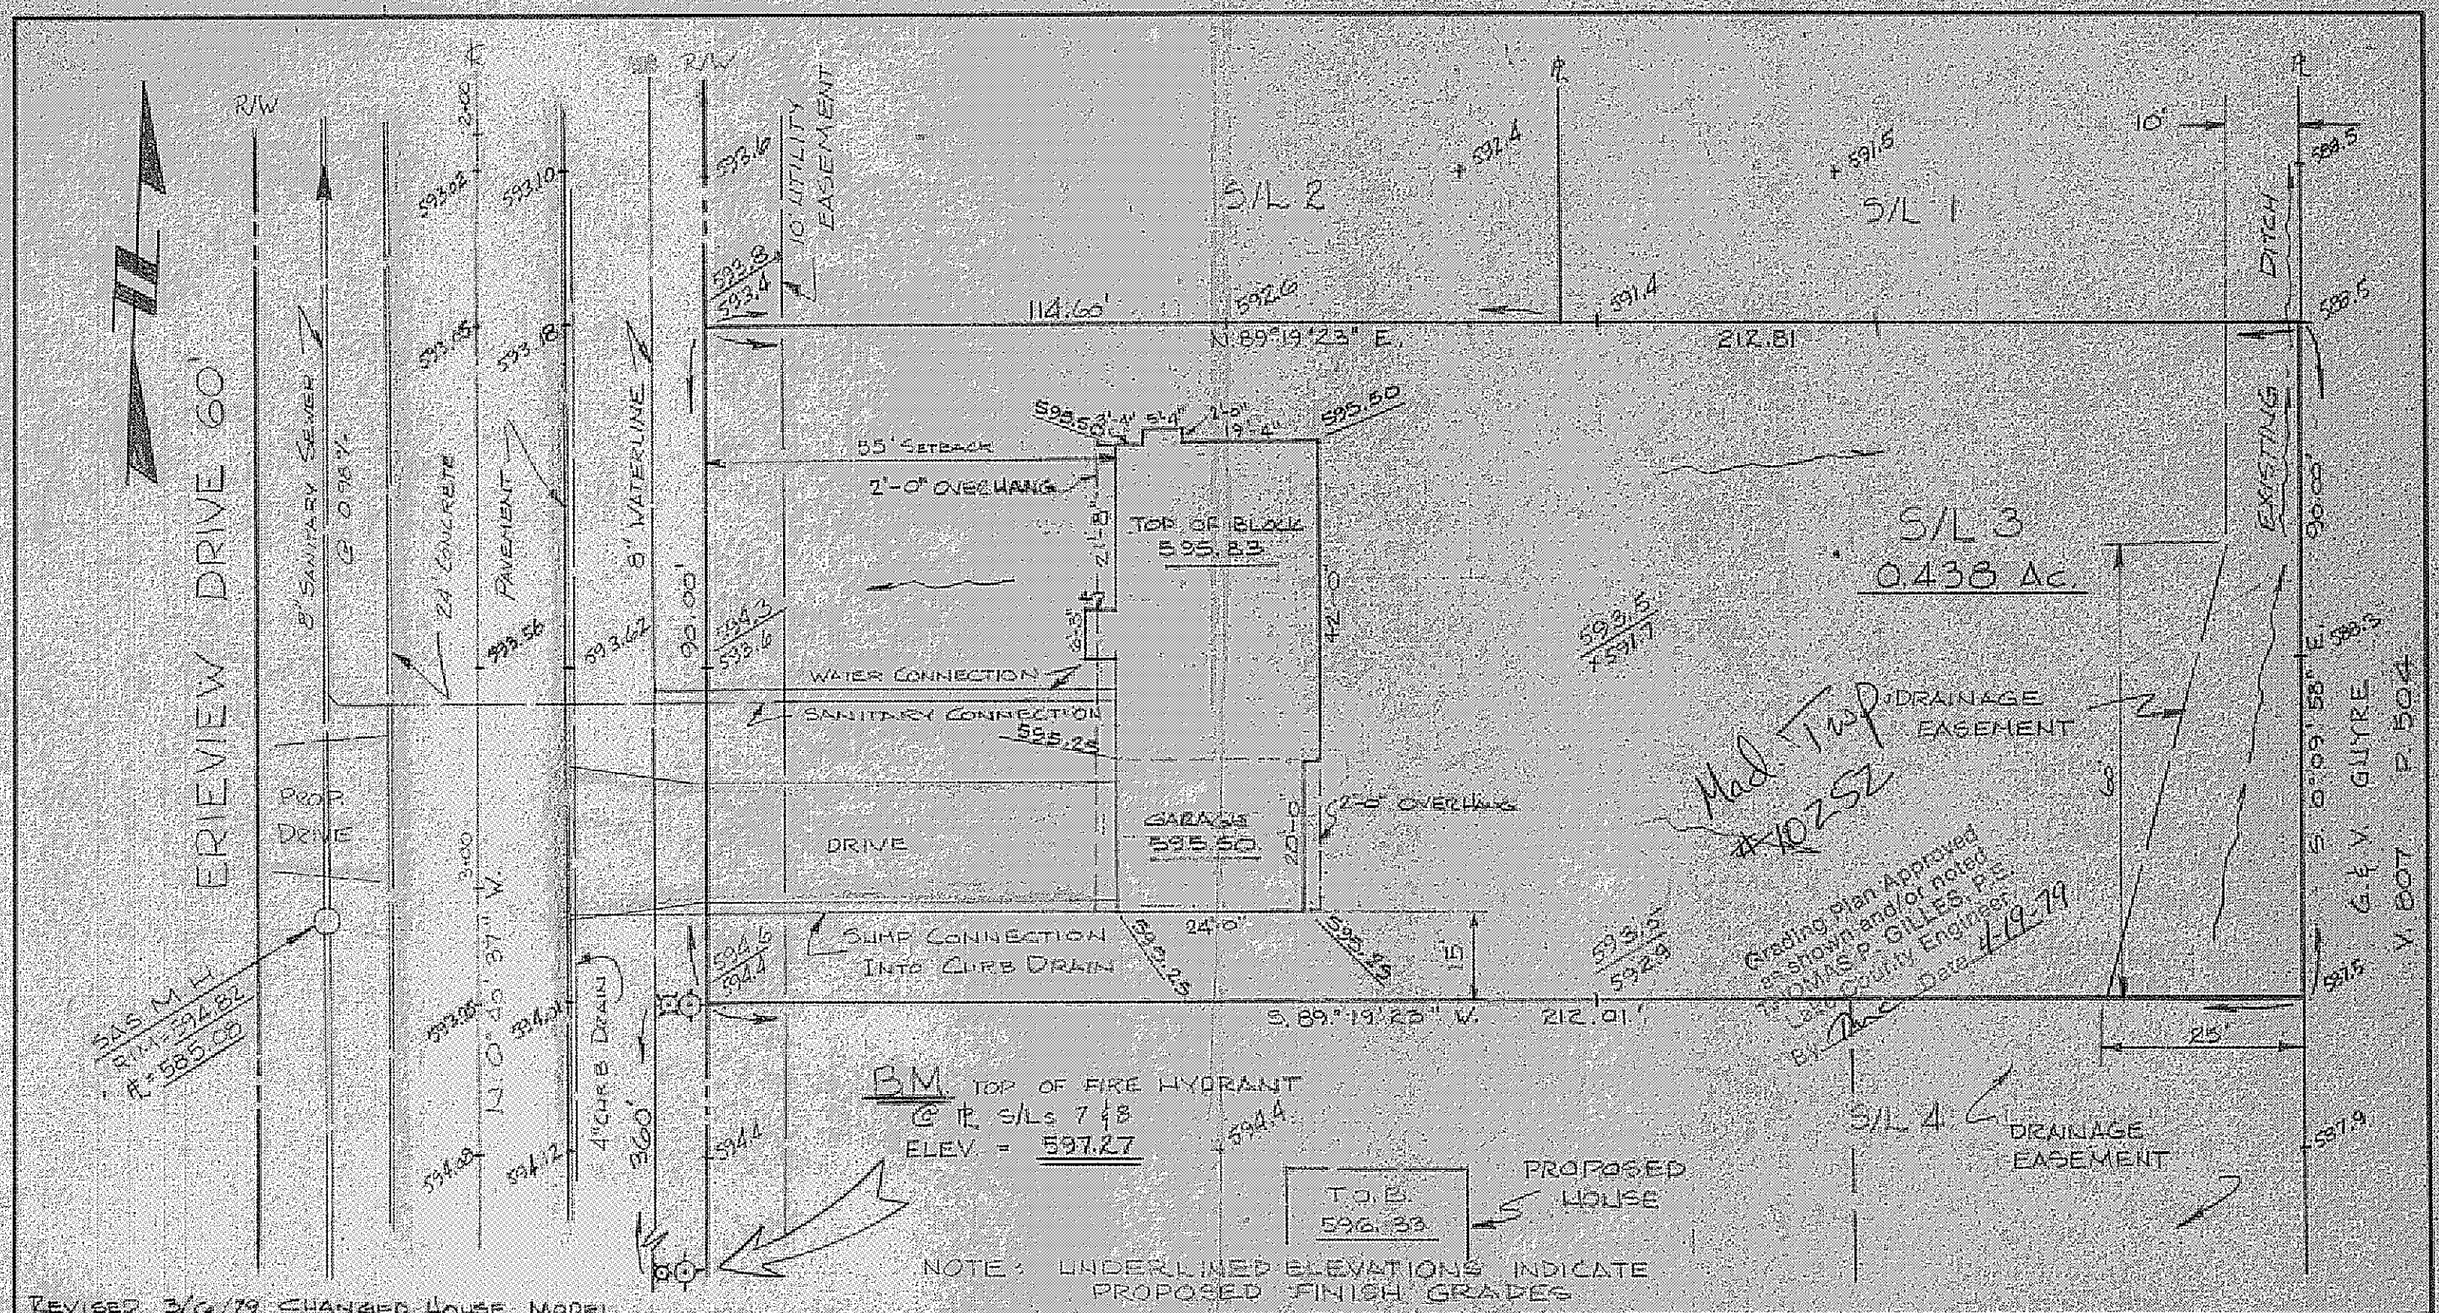

REVISED 3/6/79 CHANGED HOUSE MODEL

DESIGN CERTIFICATION

THIS PLAT WAS PREPARED BY ME, AND IS CORRECT TO THE BEST OF MY KNOWLEDGE AND BELIEF.

REG. SURVEYOR NO. 4042

AS BUILT CERTIFICATION

I HEREBY CERTIFY THAT THE CIRCLED GRADES ARE EXISTING FINISH GRADES CHECKED IN THE FIELD ON _____ AND THAT SURVEY IS CORRECT TO THE BEST OF MY KNOWLEDGE AND BELIEF.

REG. SURVEYOR NO. _____

COLPETZER · WOODS
CONSULTANTS, INC.
180 SOUTH STATE STREET • PAINESVILLE, OHIO 44077 • (216) 357-7569

DATE AUG. 14, 1978
SCALE 1" = 20'
DRWN BY JTG
CHKD BY
JOB NO. 78-107
FB. 347 PG. 8

SITE PLAN FOR
NEFF - FALVER, INC.
BEING SUBLOT No. 3 IN THE ERIEVIEW ESTATES SUBDIVISION IN THE TOWNSHIP OF MADISON, LAKE COUNTY, OHIO