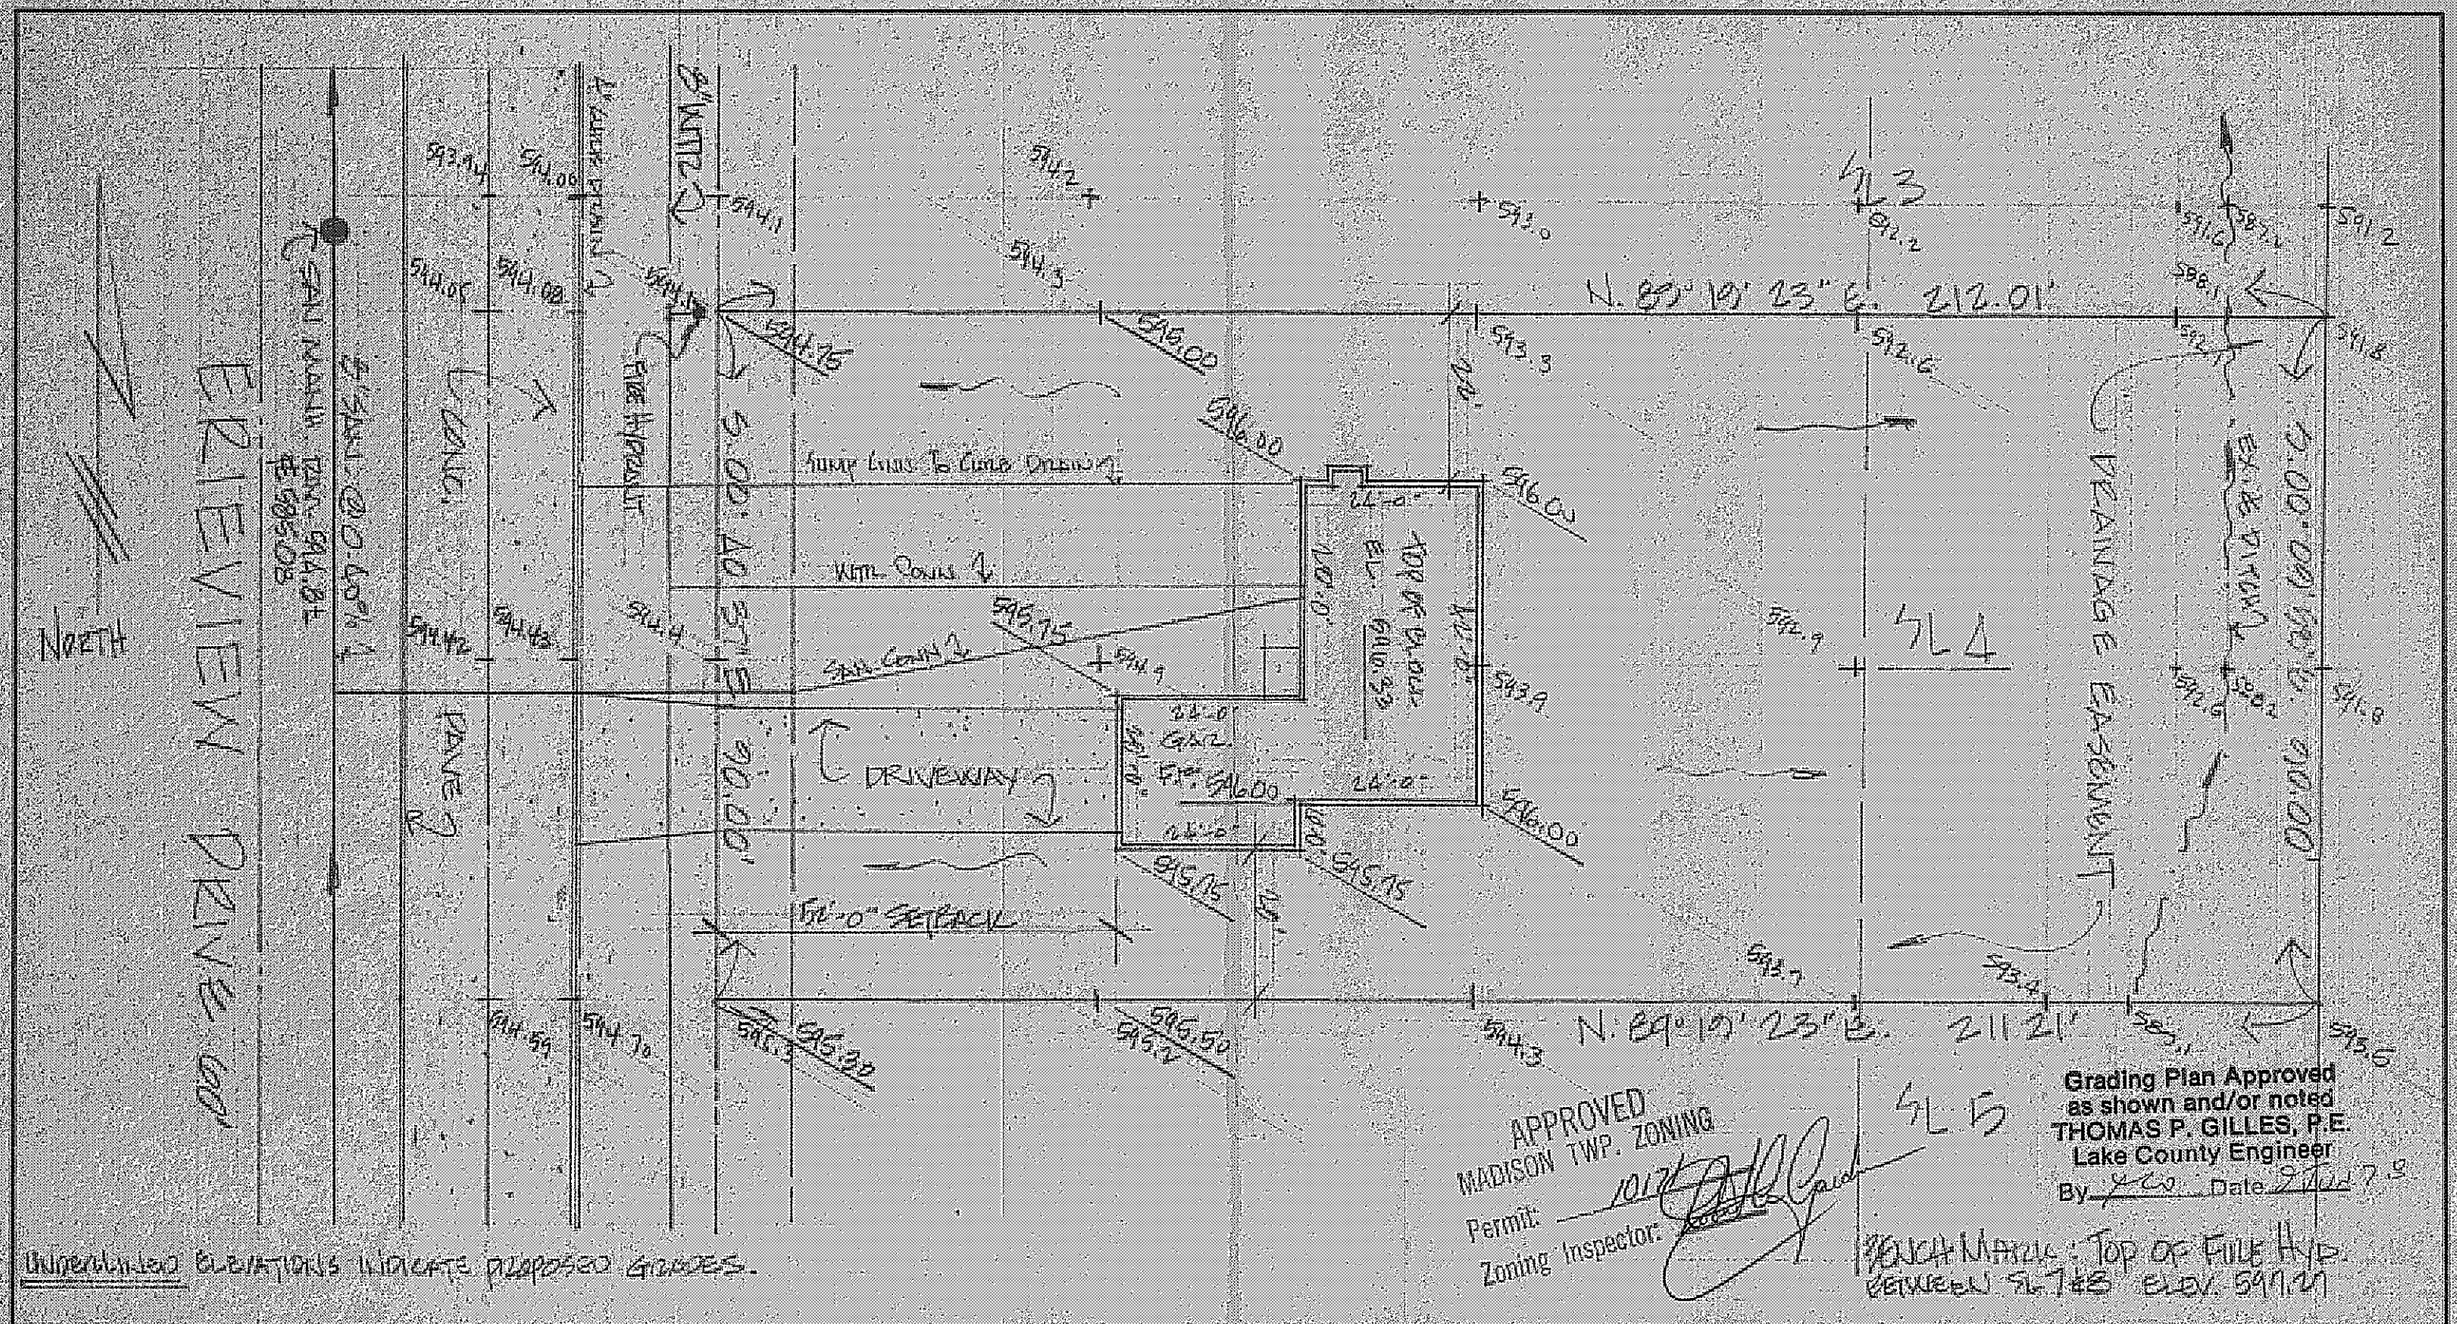


| DESIGN CERTIFICATION | AS BUILT CERTIFICATION | | | |
|---|---|---|---|---|
| THIS PLAT WAS PREPARED BY ME AND IS CORRECT TO THE BEST OF MY KNOWLEDGE AND BELIEF. | I HEREBY CERTIFY THAT THE CIRCLED GRADES ARE EXISTING FINISH GRADES CHECKED IN THE FIELD ON _____ AND THAT SURVEY IS CORRECT TO THE BEST OF MY KNOWLEDGE AND BELIEF. | COLPETZER · WOODS CONSULTANTS, INC. 180 SOUTH STATE STREET • PAINESVILLE, OHIO 44077 • (216) 357-7569 | DATE MAY 30, 1978 SCALE 1"=20' DRWN BY CDB CHKD BY JOB NO. 78-107 FB 528 PG | SITE PLAN FOR: NEFF-FAUVER, INC. BEING SUBLOT NO. 4 IN THE ERIEVIEW ESTATES SUBDIVISION IN THE TOWNSHIP OF MADISON, OH. |
| REG. SURVEYOR NO. 14785 | REG. SURVEYOR NO. | | | |