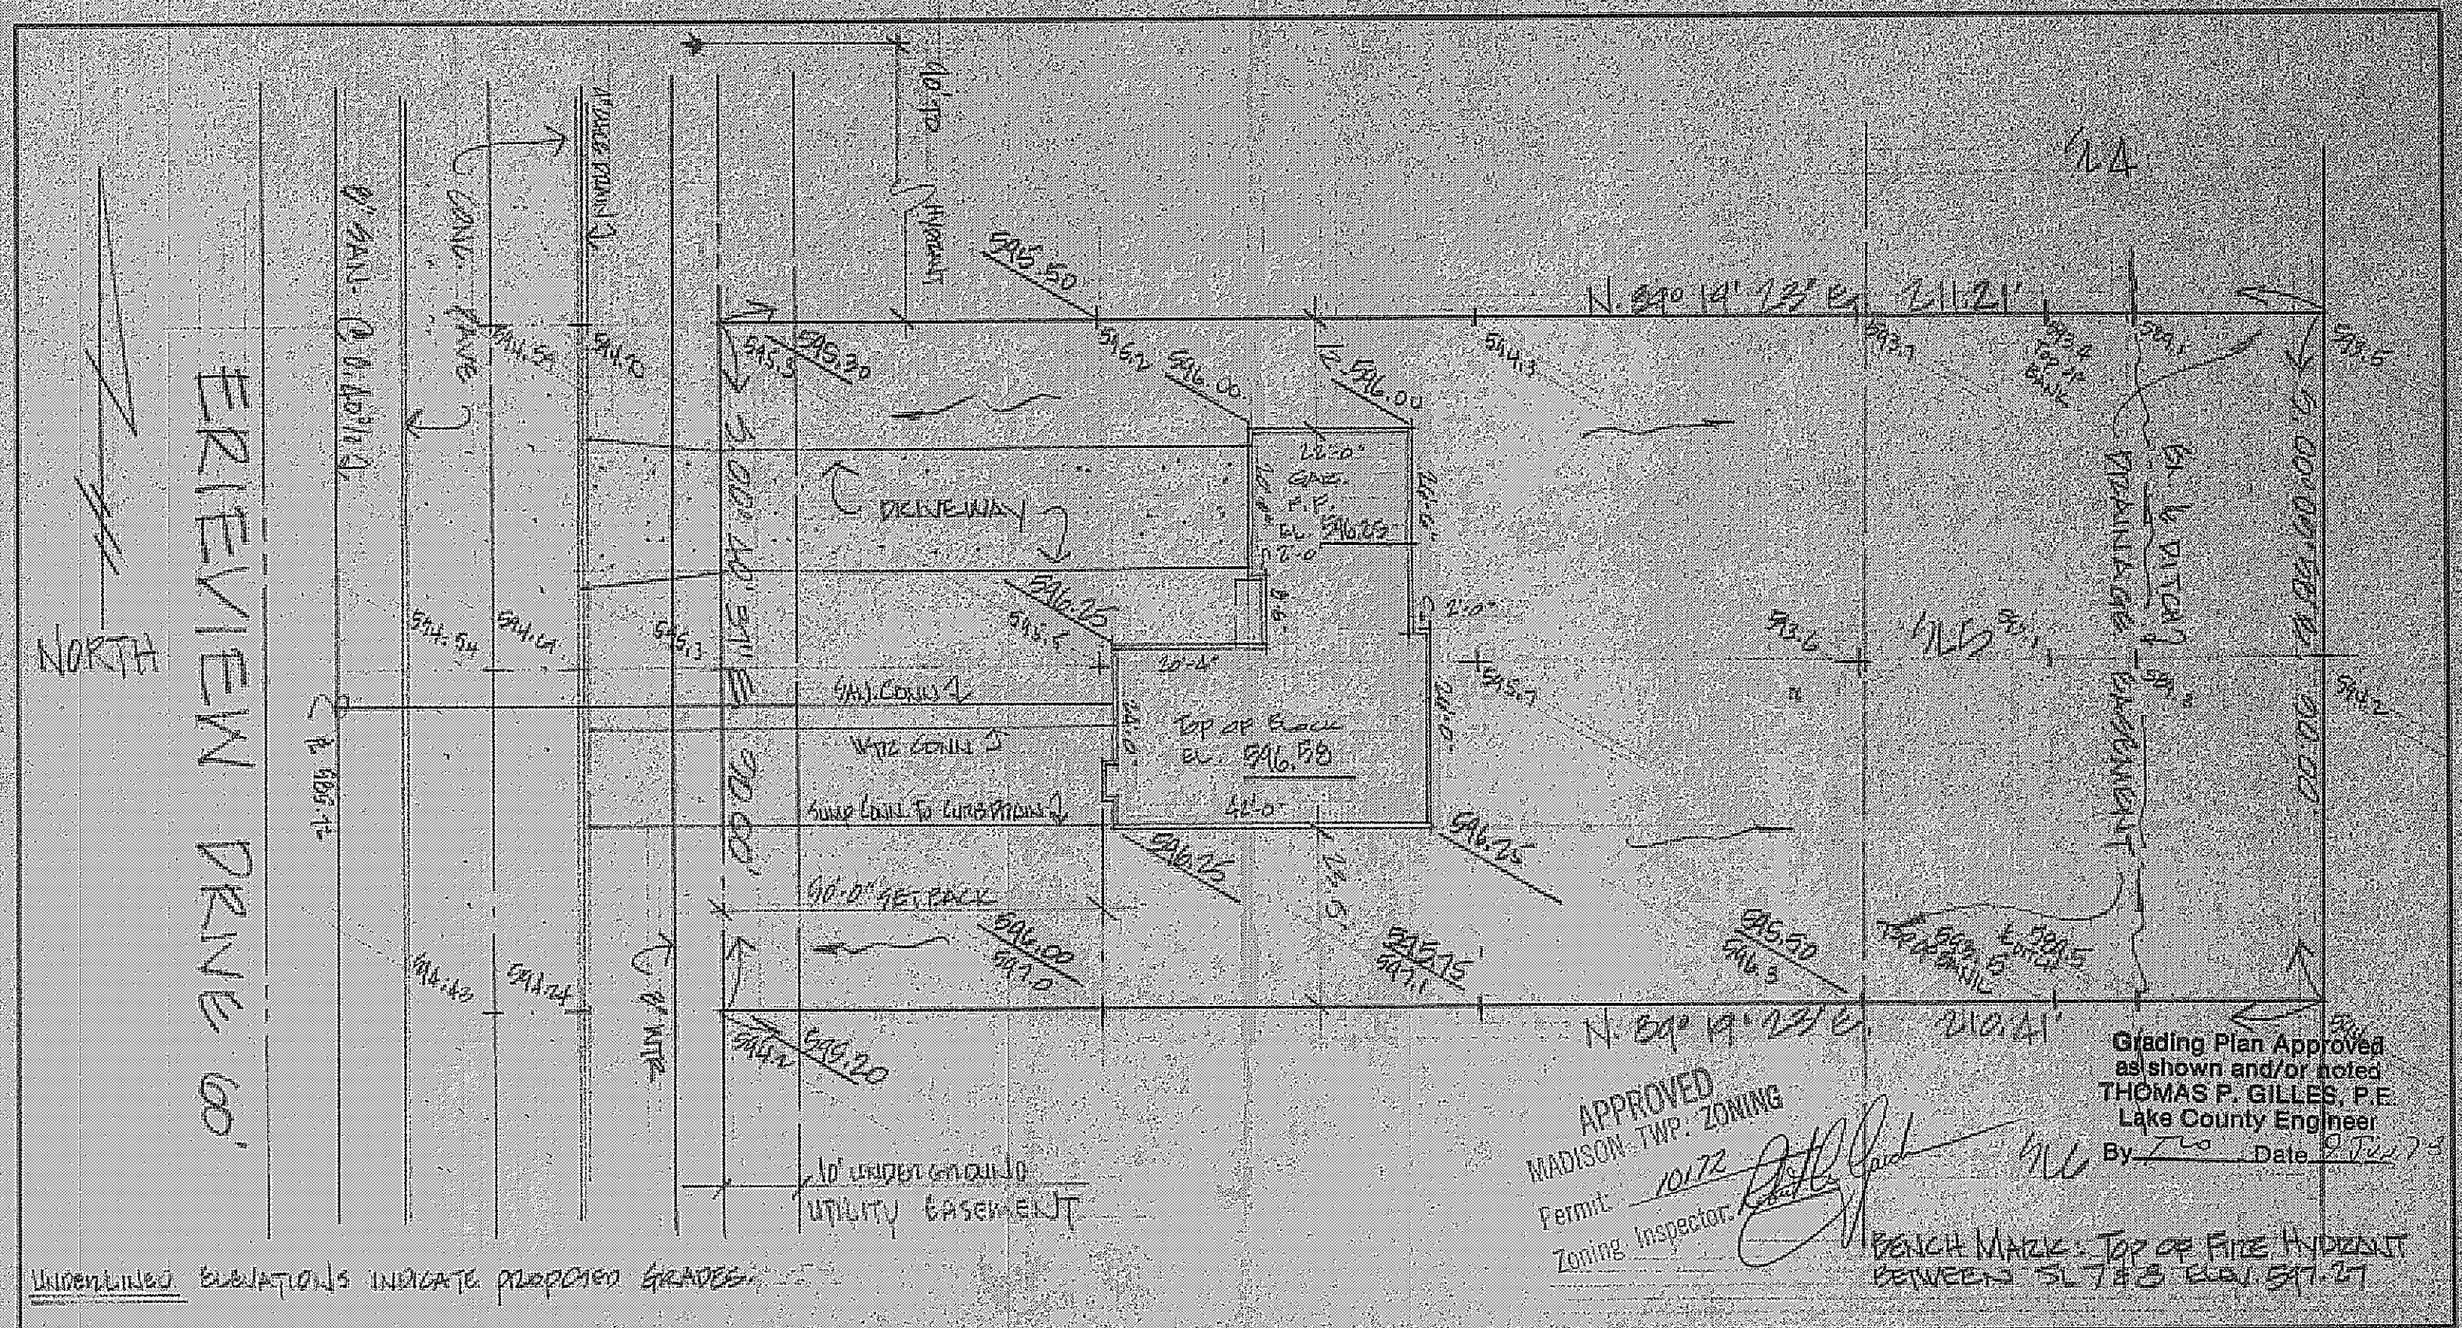

Underlined elevations indicate proposed grades.

DESIGN CERTIFICATION

THIS PLAT WAS PREPARED BY ME, AND IS CORRECT TO THE BEST OF MY KNOWLEDGE AND BELIEF.

REG. SURVEYOR NO. 4785

AS BUILT CERTIFICATION

I HEREBY CERTIFY THAT THE CIRCLED GRADES ARE EXISTING FINISH GRADES CHECKED IN THE FIELD ON _____ AND THAT SURVEY IS CORRECT TO THE BEST OF MY KNOWLEDGE AND BELIEF.

REG. SURVEYOR NO. _____

COLPETZER · WOODS
CONSULTANTS, INC.
190 SOUTH STATE STREET • PAINESVILLE, OHIO 44077 • (216) 357-7669

DATE: MAY 30, 1970
SCALE: 1" = 20'
DRWN BY: [illegible]
CHKD BY: _____
JOB NO. 70-107
FB 329 PG _____

SITE PLAN FOR:
NEFF - FAUVER, INC.
BEING SUB LOT 10.5 IN THE ERIEVIEW ESTATES SUBDIVISION IN THE TOWNSHIP OF MADISON, OHIO.