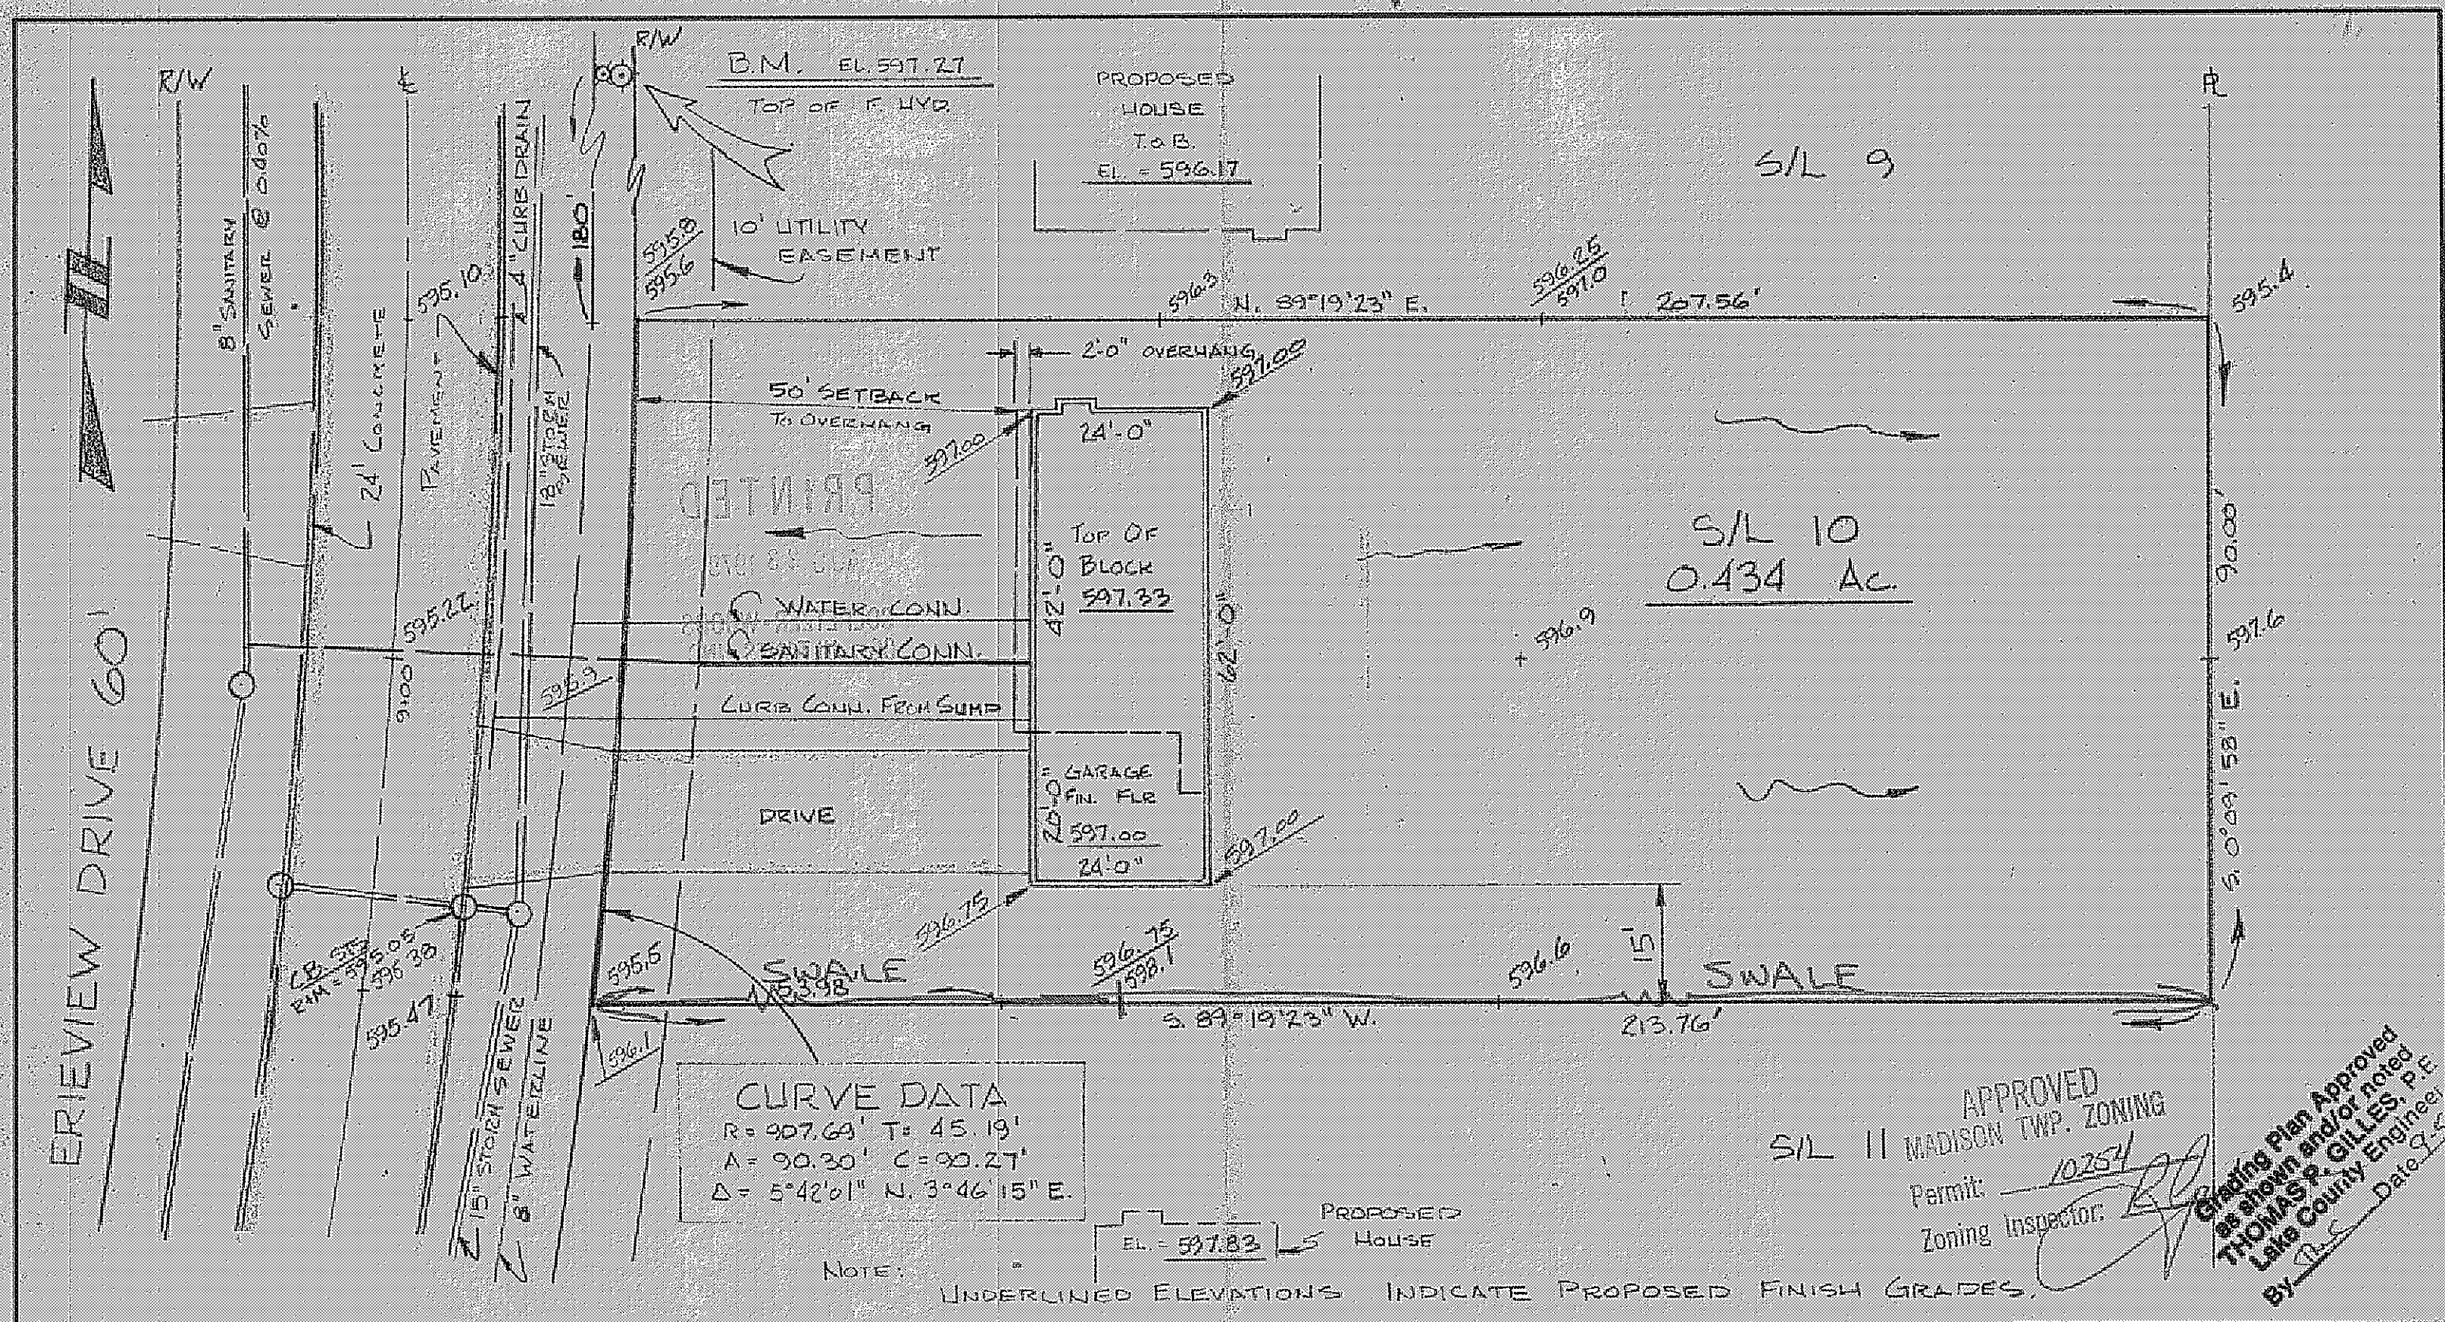

DESIGN CERTIFICATION

THIS PLAT WAS PREPARED BY ME, AND IS CORRECT TO THE BEST OF MY KNOWLEDGE AND BELIEF.

William G. Purdon

REG. SURVEYOR NO. 4642

AS BUILT CERTIFICATION

I HEREBY CERTIFY THAT THE CIRCLED GRADES ARE EXISTING FINISH GRADES CHECKED IN THE FIELD ON _____ AND THAT SURVEY IS CORRECT TO THE BEST OF MY KNOWLEDGE AND BELIEF.

REG. SURVEYOR NO. _____

COLPETZER · WOODS
CONSULTANTS, INC.
~~180 SOUTH STATE STREET • PAINESVILLE, OHIO 44077~~ • (216) 357-7569
9470 MENTOR AVE. MENTOR 44060

DATE AUG. 15, 1978
SCALE 1" = 20'
GRADED & DRWN BY JTG
CHKD BY GB
JOB NO. 78-107
FB 347 PG 8

SITE PLAN FOR
NEFF ~ FAUVER, INC.
BEING SUBLOT NO. 10. OF THE
ERIEVIEW ESTATES SUBDIVISION
MADISON TOWNSHIP, LAKE COUNTY, OHIO