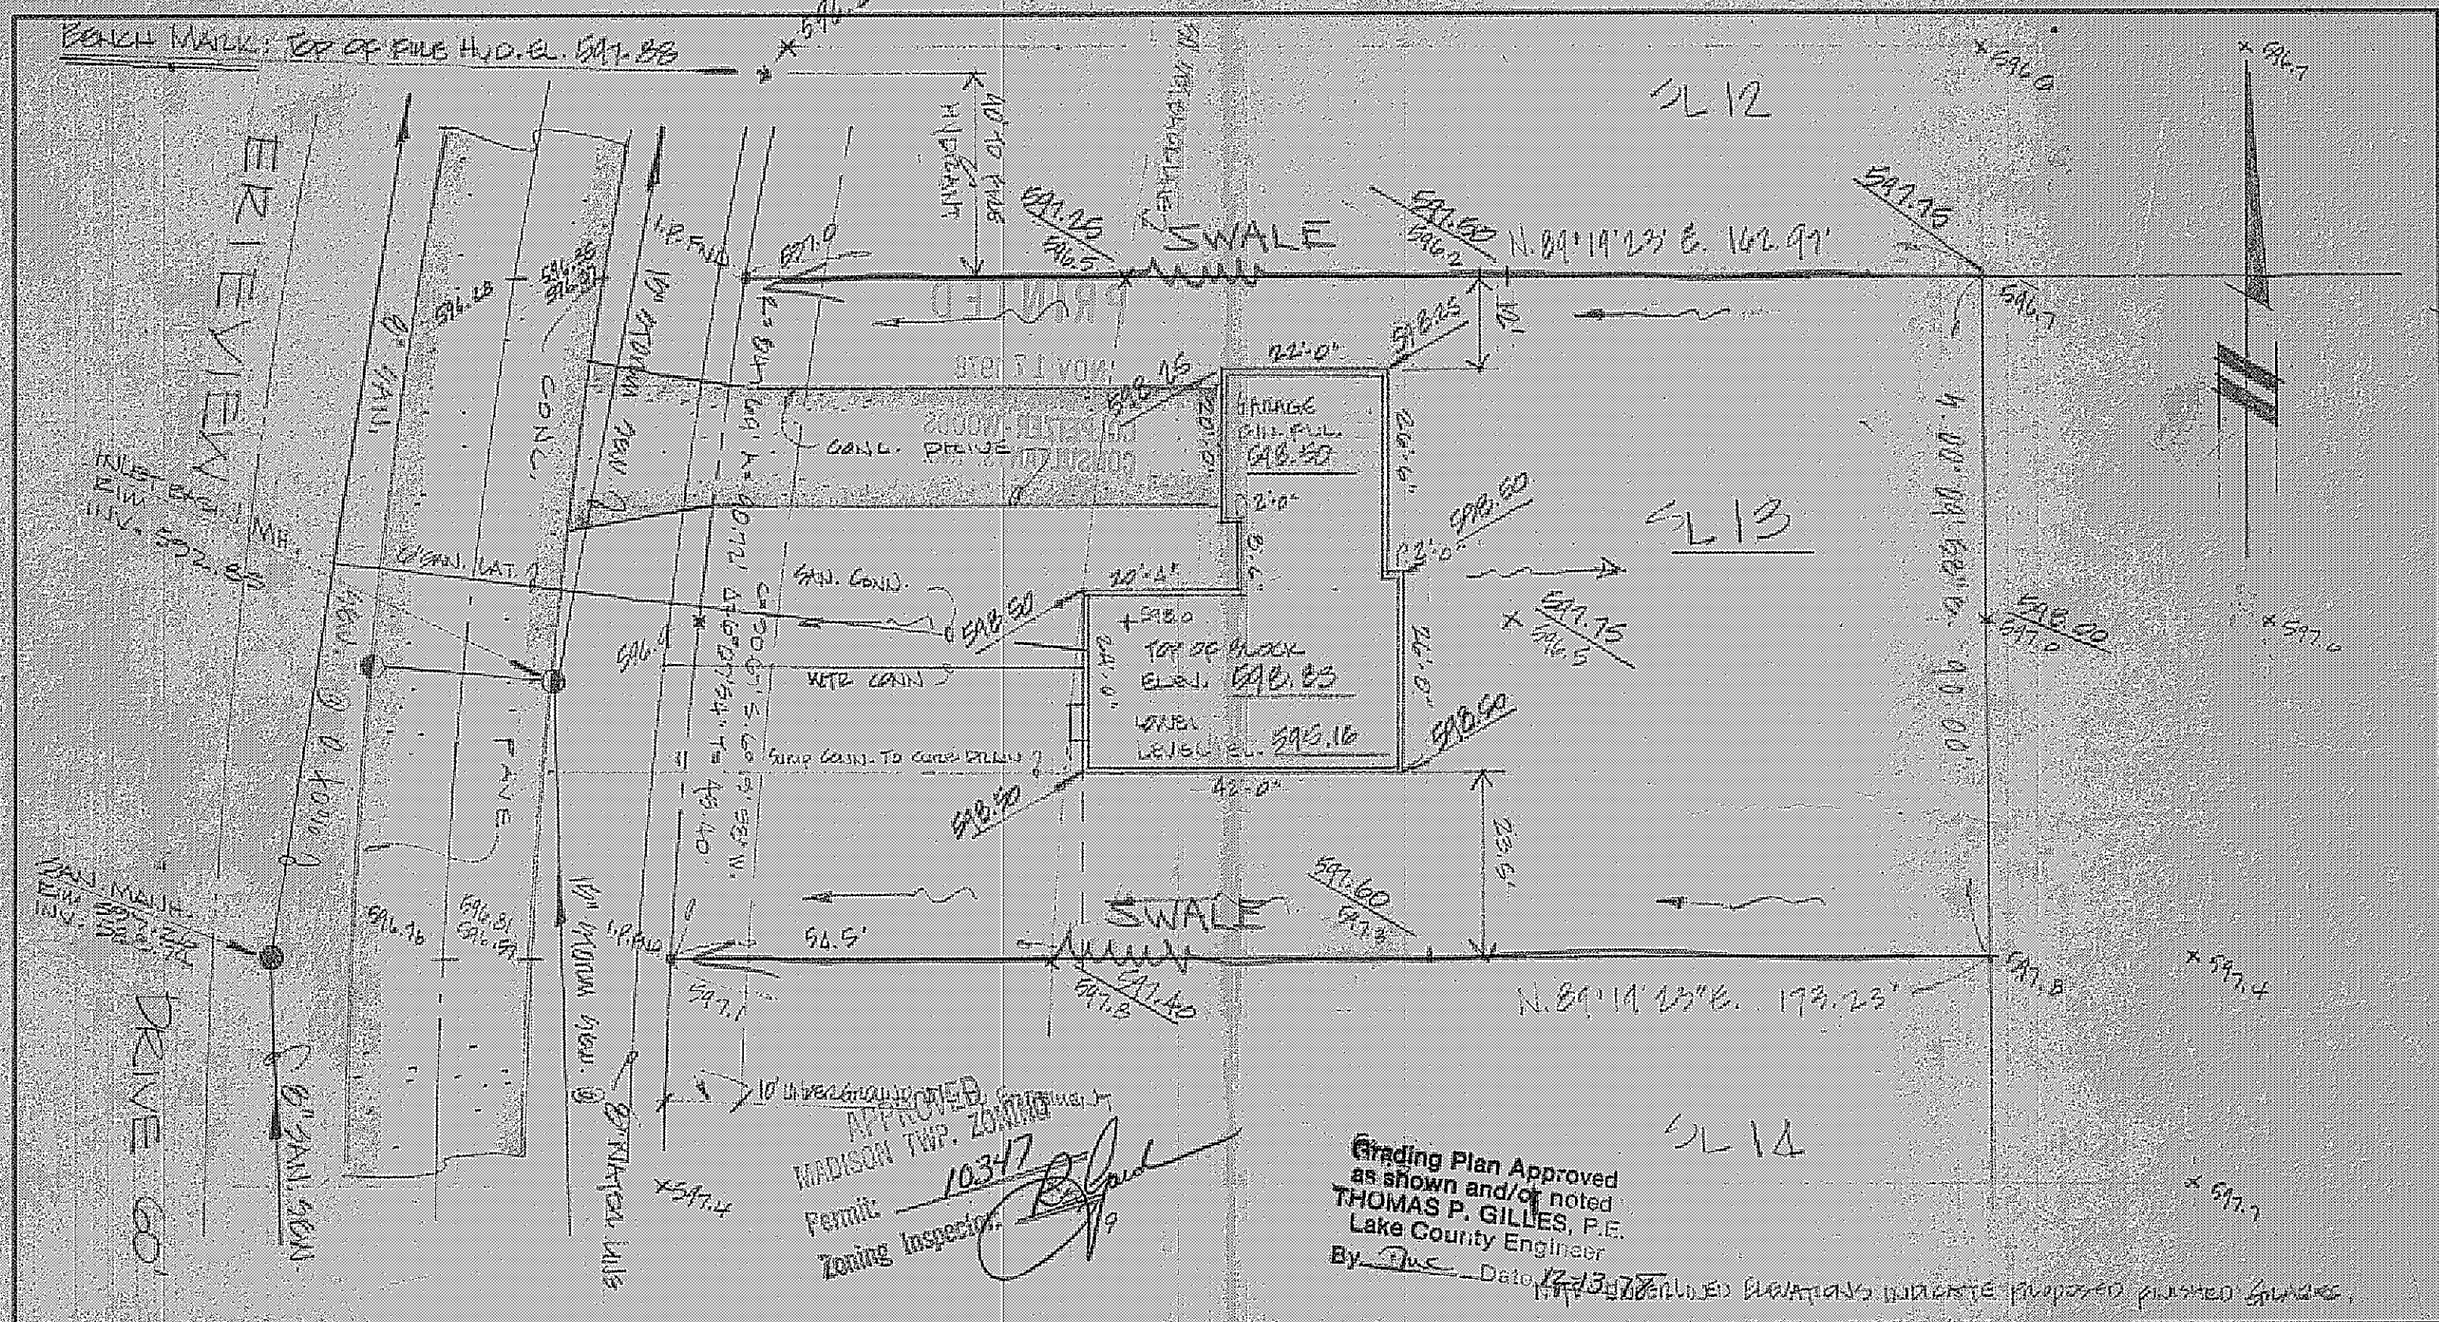


1307 EV.

**DESIGN CERTIFICATION**

THIS PLAT WAS PREPARED BY ME, AND IS CORRECT TO THE BEST OF MY KNOWLEDGE AND BELIEF.

REG. SURVEYOR NO. 4785

**AS BUILT CERTIFICATION**

I HEREBY CERTIFY THAT THE CIRCLED GRADES ARE EXISTING FINISH GRADES CHECKED IN THE FIELD ON _____ AND THAT SURVEY IS CORRECT TO THE BEST OF MY KNOWLEDGE AND BELIEF.

REG. SURVEYOR NO. _____

**COLPETZER · WOODS**
CONSULTANTS, INC.
~~180 SOUTH STATE STREET • PAINESVILLE, OHIO 44077~~ • (216) 357-7569
9470 MENTOR AVE. MENTOR, OH.

DATE Nov. 17, 1978
SCALE 1" = 20'
DRWN BY GB
CHKD BY
JOB NO. 78-107
FB 347 PG 108

SITE PLAN FOR:
NEFF-FAUVER, INC.
BEING SUBLOT NO. 13 IN THE ERIEVIEW ESTATES SUBDIVISION IN MADISON TWP. OHIO.