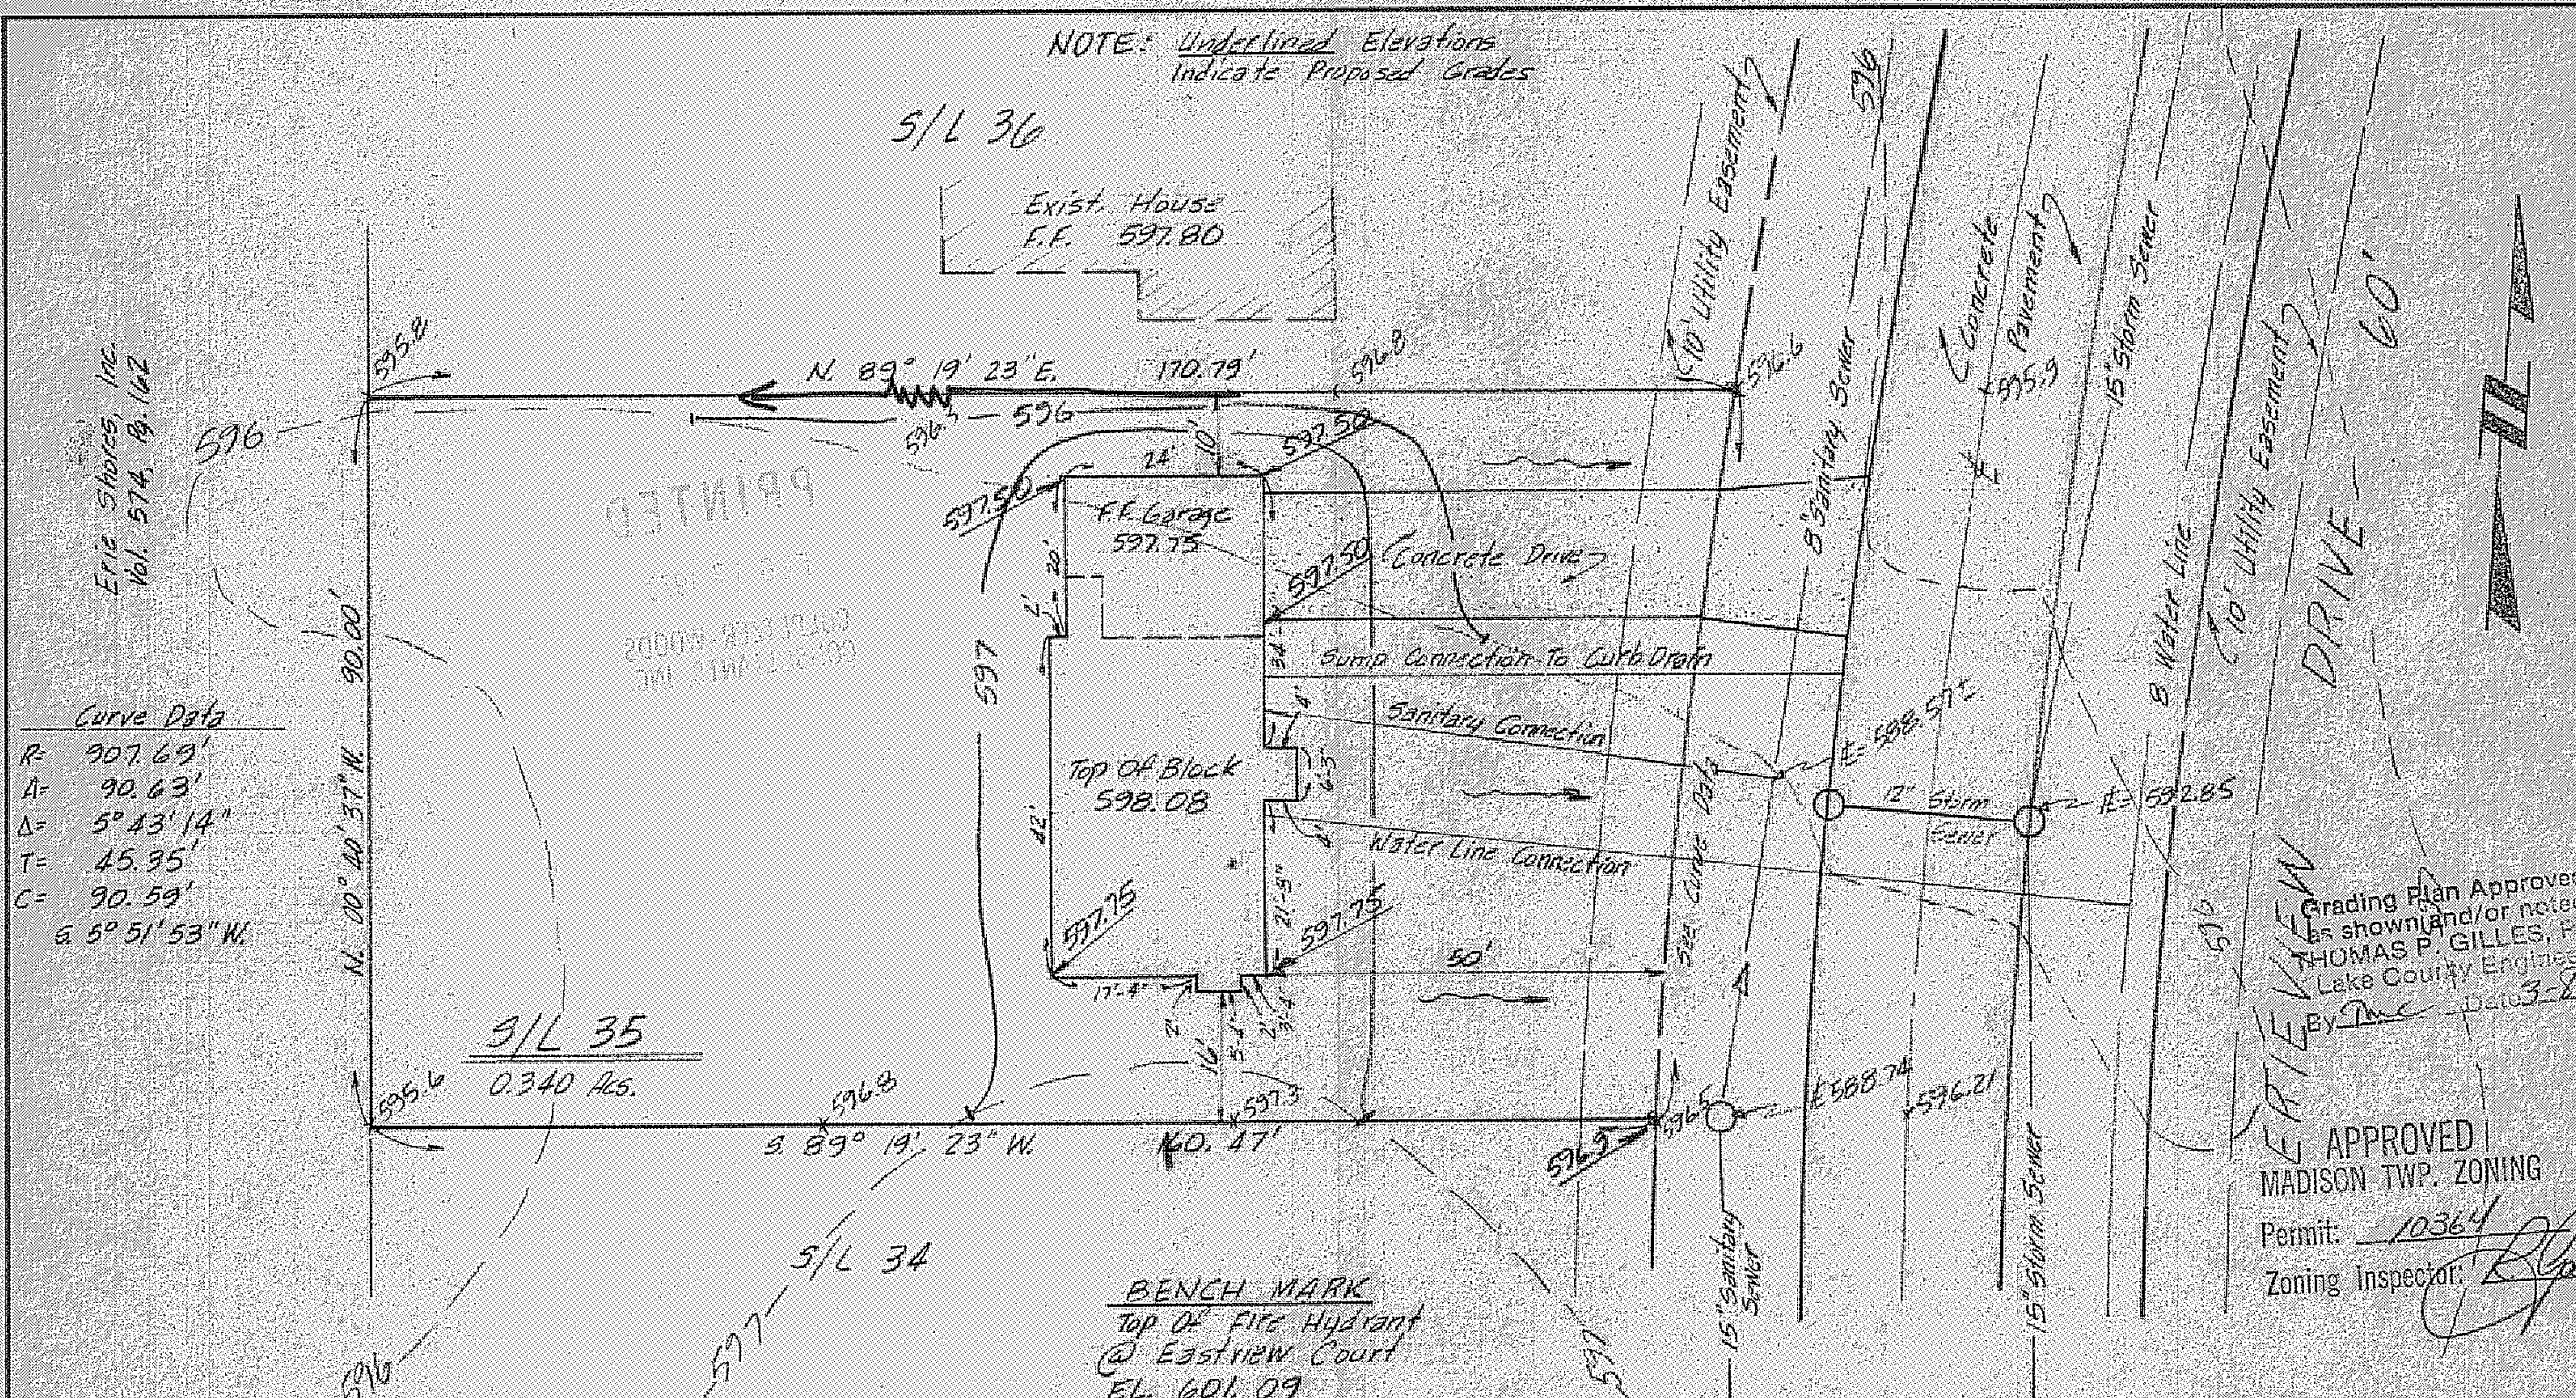

DESIGN CERTIFICATION

THIS PLAT WAS PREPARED BY ME, AND IS CORRECT TO THE BEST OF MY KNOWLEDGE AND BELIEF.

REG. SURVEYOR NO. 4755

AS BUILT CERTIFICATION

I HEREBY CERTIFY THAT THE CIRCLED GRADES ARE EXISTING FINISH GRADES CHECKED IN THE FIELD ON ____________ AND THAT SURVEY IS CORRECT TO THE BEST OF MY KNOWLEDGE AND BELIEF.

REG. SURVEYOR NO. ____________

COLPETZER · WOODS
CONSULTANTS, INC.

DATE: Feb. 7th 1979
SCALE: 1" = 20'
DRWN BY: E.C.F.
CHKD BY: CG
JOB NO.: 78/107
FB #328 PG #96

Site Plan
For
NEFF-FAUVER
Being S/L# 35 In The Erieview Estates Subdivision
Madison Township, Lake County, Ohio