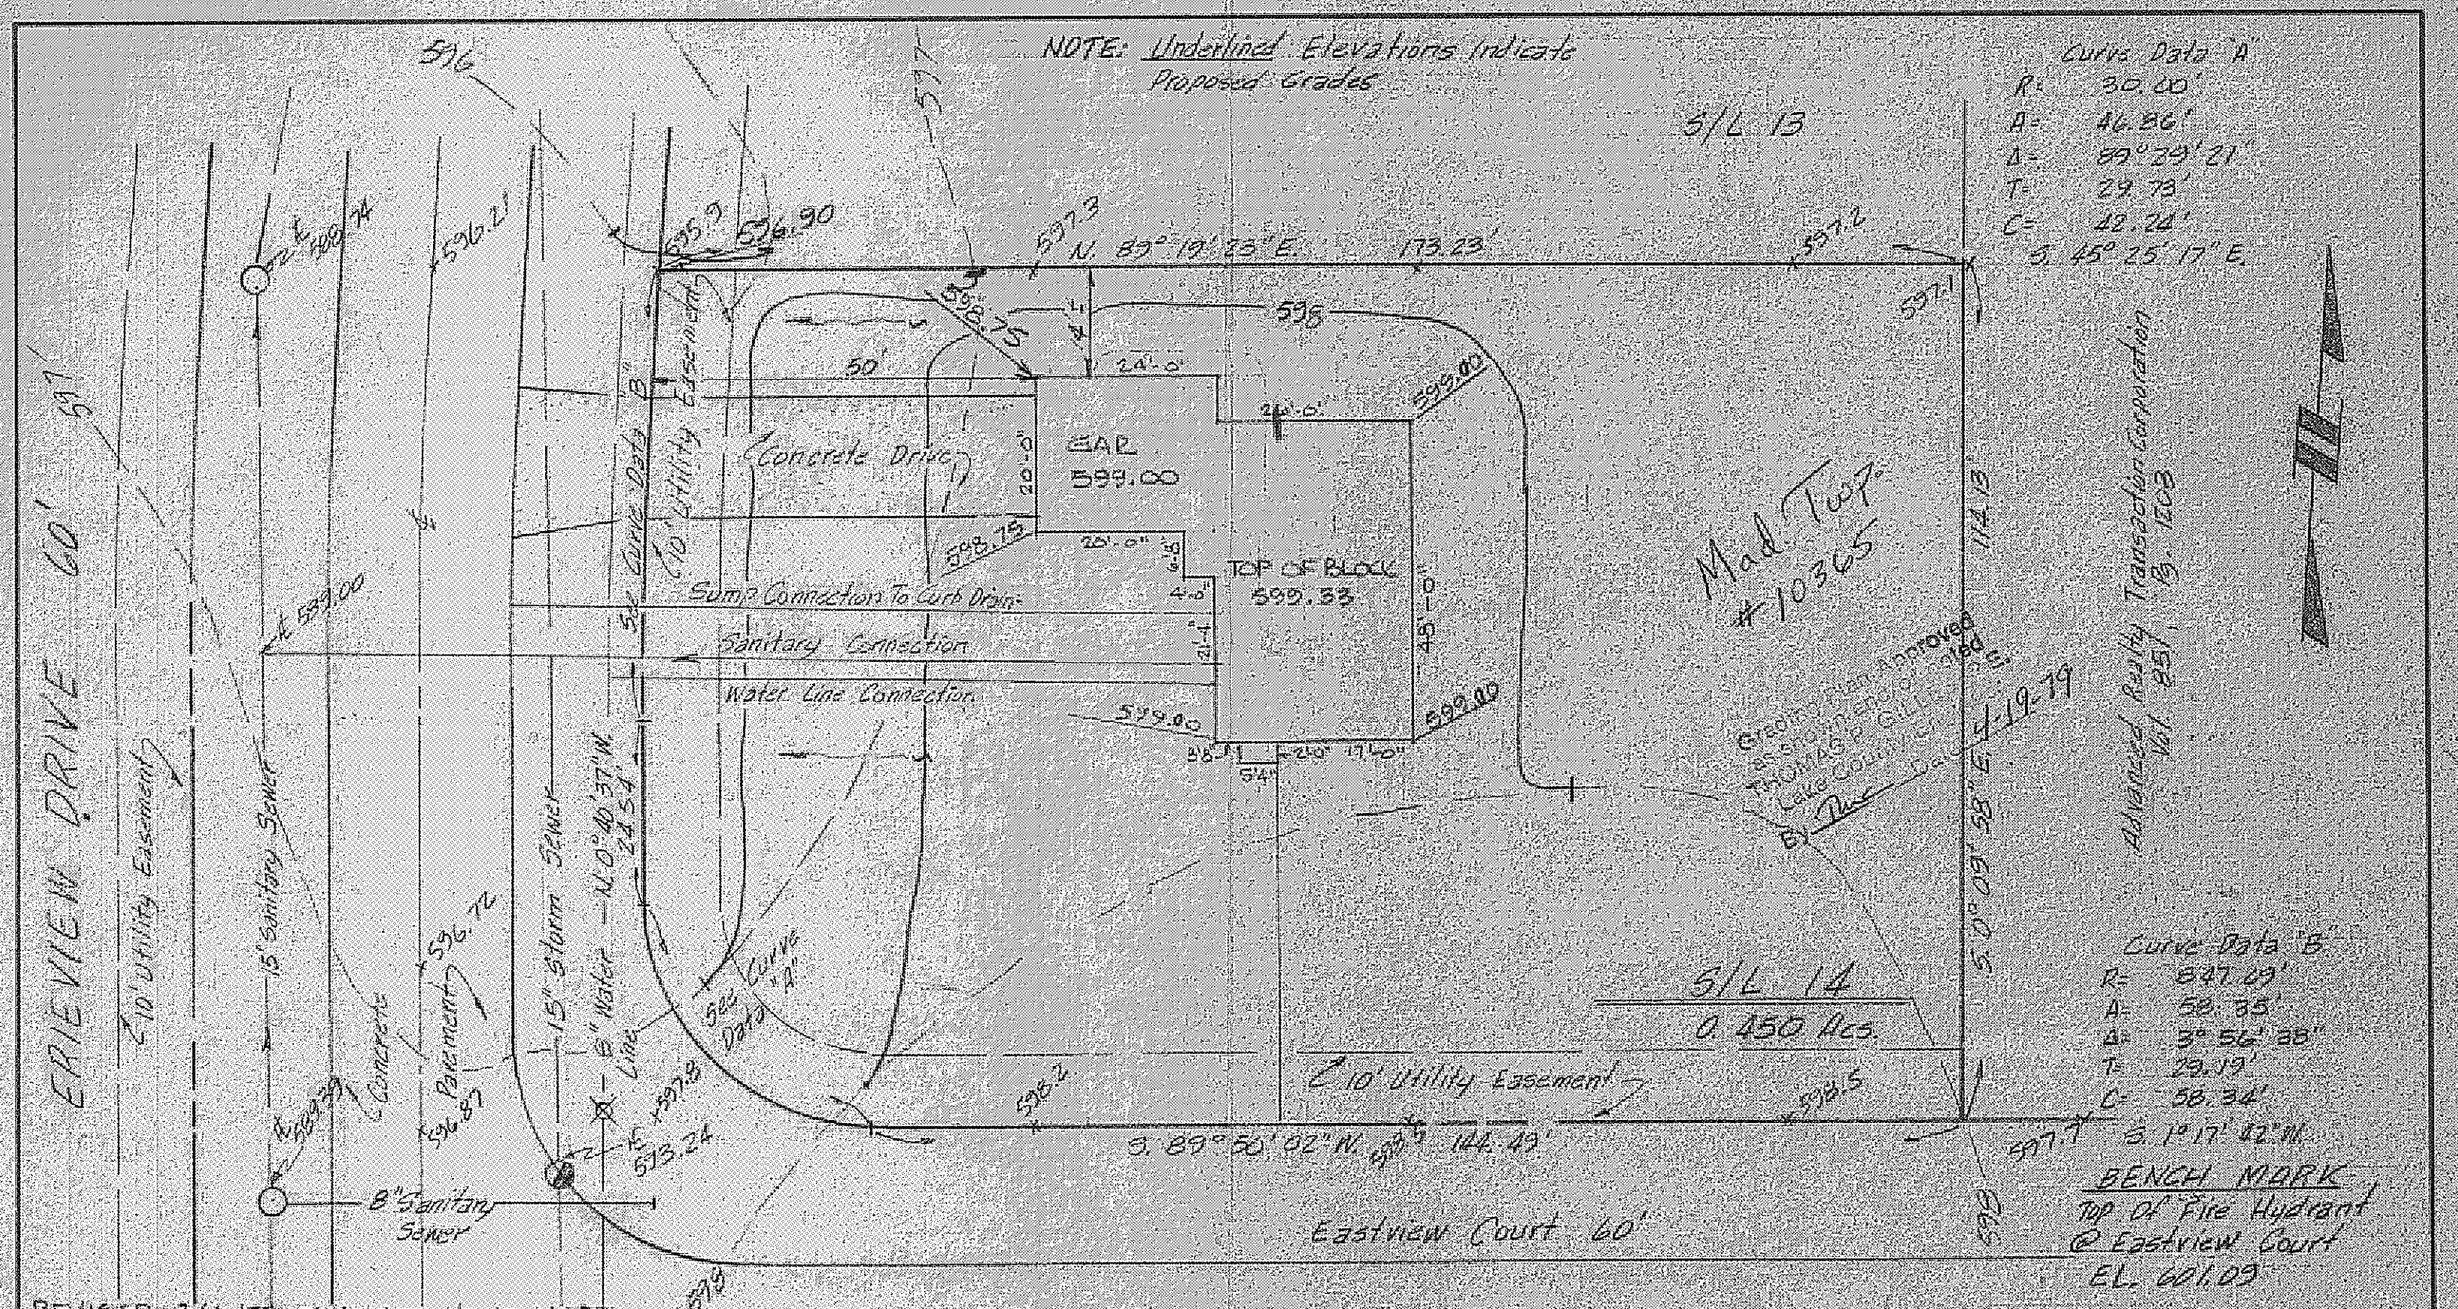

REVISED 3/6/79 CHANGED HOUSE MODEL

DESIGN CERTIFICATION	AS BUILT CERTIFICATION			
THIS PLAT WAS PREPARED BY ME, AND IS CORRECT TO THE BEST OF MY KNOWLEDGE AND BELIEF.	I HEREBY CERTIFY THAT THE CIRCLED GRADES ARE EXISTING FINISH GRADES CHECKED IN THE FIELD ON _____ AND THAT SURVEY IS CORRECT TO THE BEST OF MY KNOWLEDGE AND BELIEF.	COLPETZER · WOODS CONSULTANTS, INC.	DATE Feb 8th 1979 SCALE 1"=20' DRWN BY ECF CHKD BY CF JOB NO. 78/107 FB #328 PG #96	Site Plan For NEFF - FAUVER Being S/L #14 In The Erieview Estates Subdivision Madison Township, Lake County, Ohio
REG. SURVEYOR NO. 4785	REG. SURVEYOR NO. _____			