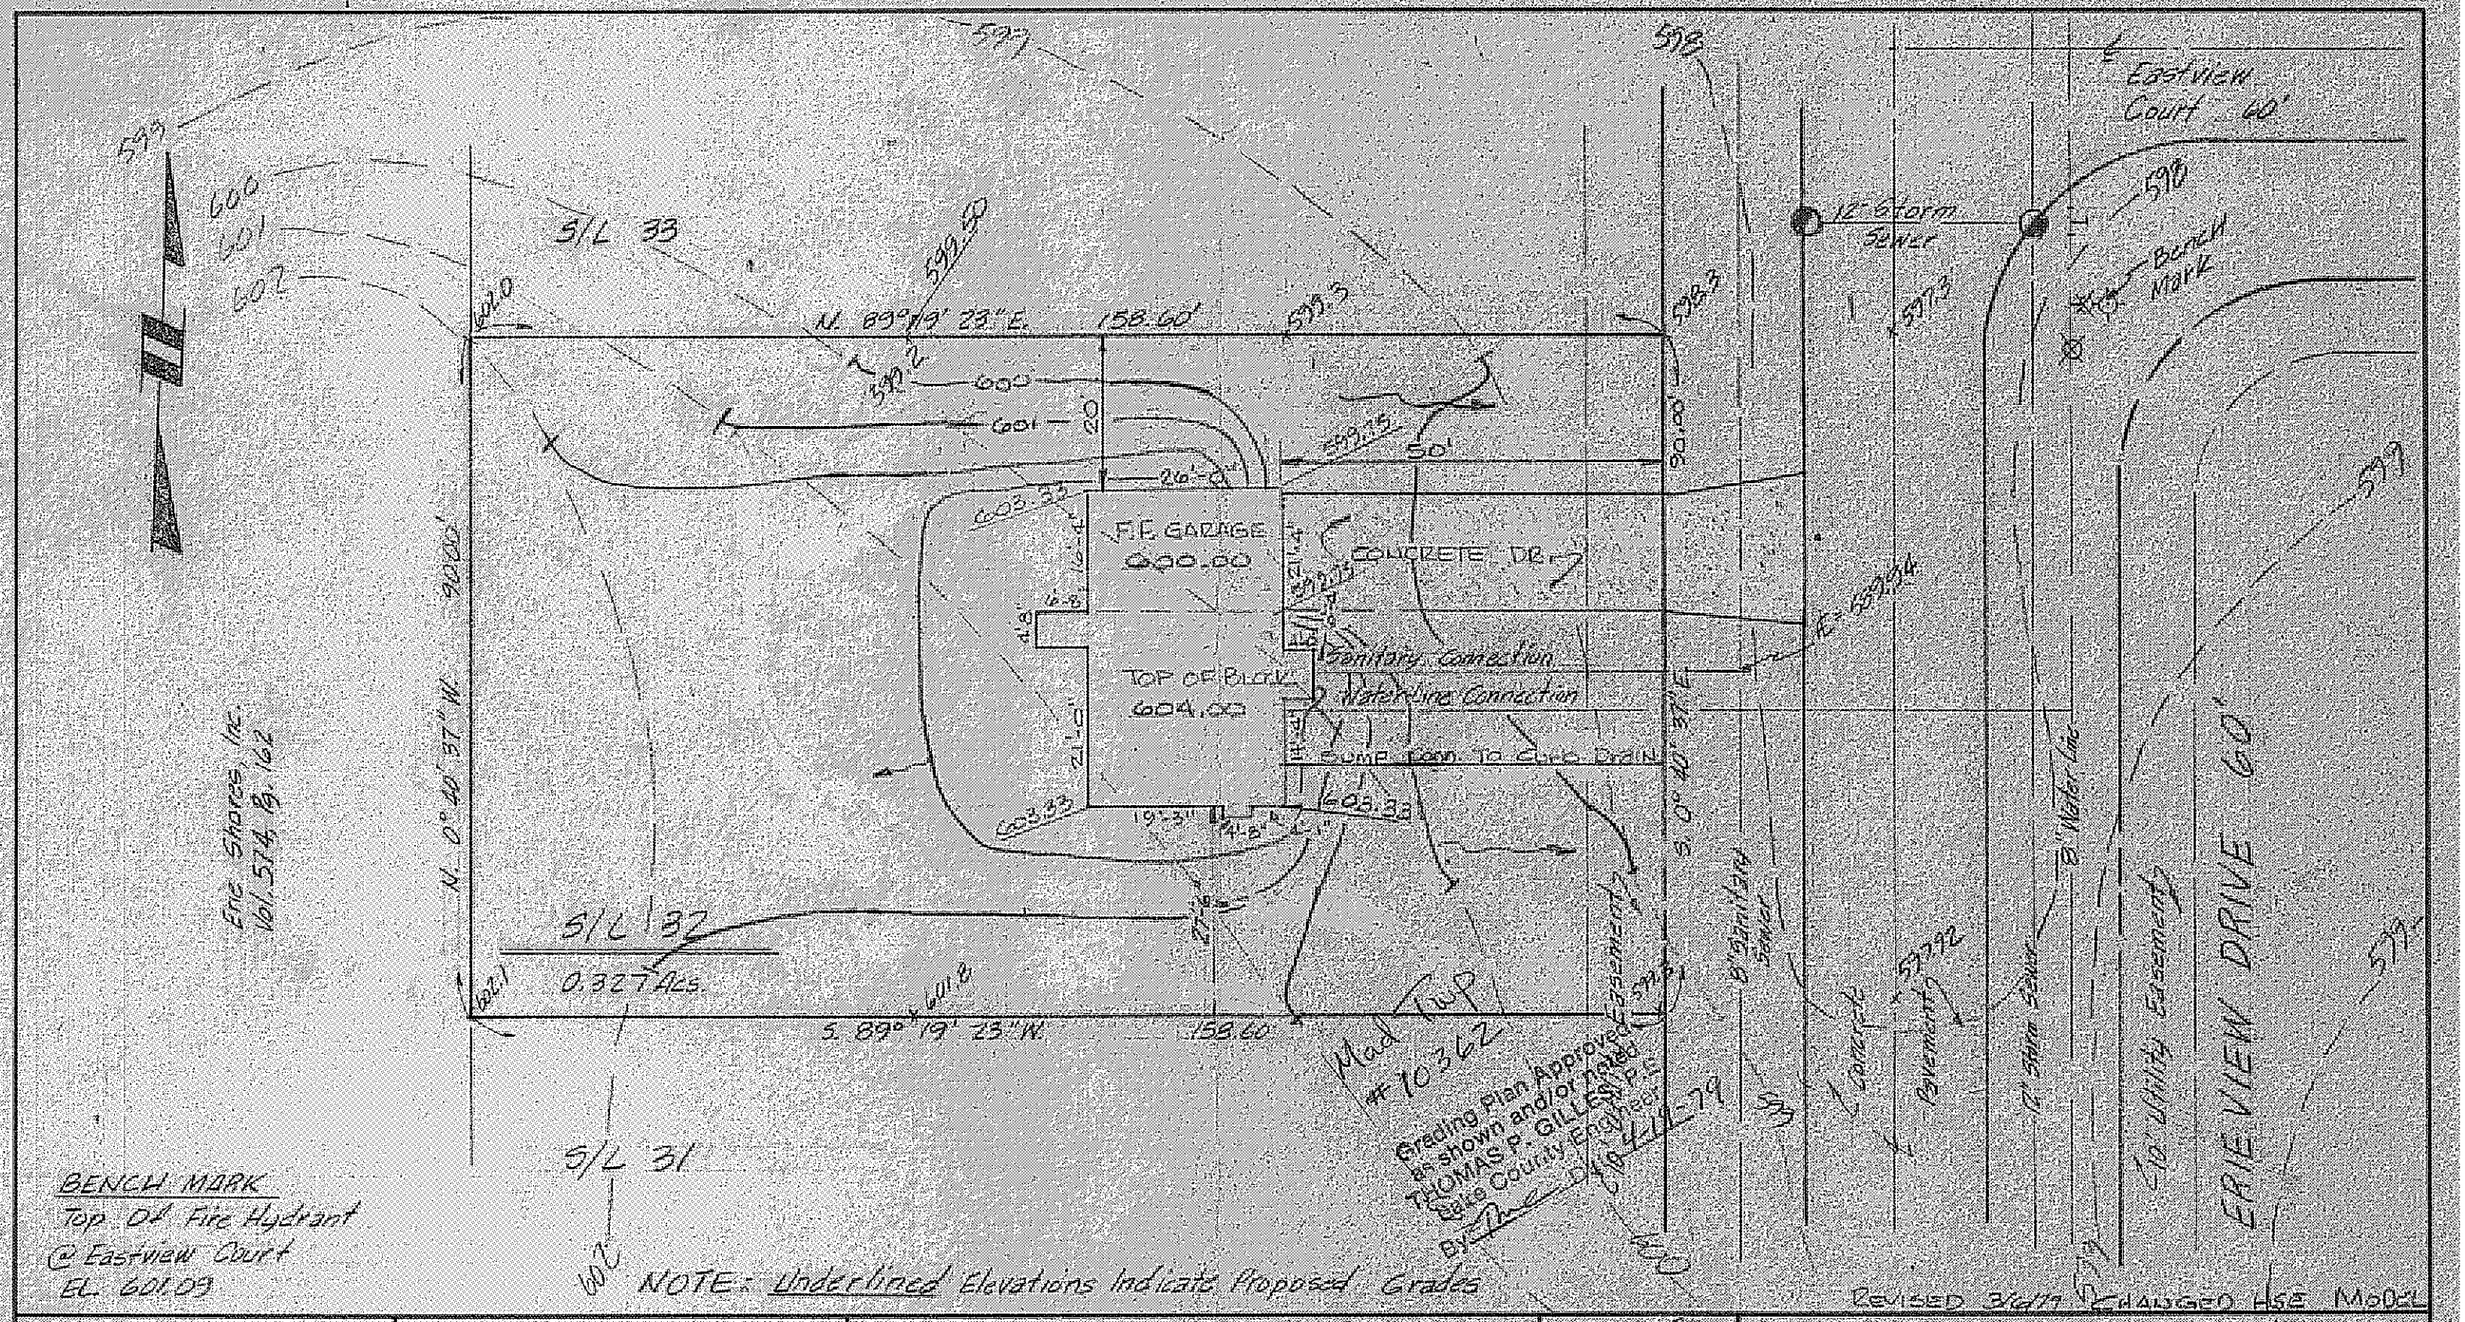

DESIGN CERTIFICATION

THIS PLAT WAS PREPARED BY ME, AND IS CORRECT TO THE BEST OF MY KNOWLEDGE AND BELIEF.

REG. SURVEYOR NO. 4182

AS BUILT CERTIFICATION

I HEREBY CERTIFY THAT THE CIRCLED GRADES ARE EXISTING FINISH GRADES CHECKED IN THE FIELD ON _____ AND THAT SURVEY IS CORRECT TO THE BEST OF MY KNOWLEDGE AND BELIEF.

REG. SURVEYOR NO. _____

COLPETZER · WOODS
CONSULTANTS, INC.

DATE Feb 5th PM
SCALE 1" = 20'
DRWN BY E.C.F.
CHKD BY CB
JOB NO 78107
FB #328 PG 92

Site Plan
For
NEFF-FAUVER
Being S/L# 32 In The Erieview Estates Subdivision
Madison Township, Lake County, Ohio