9-11-80

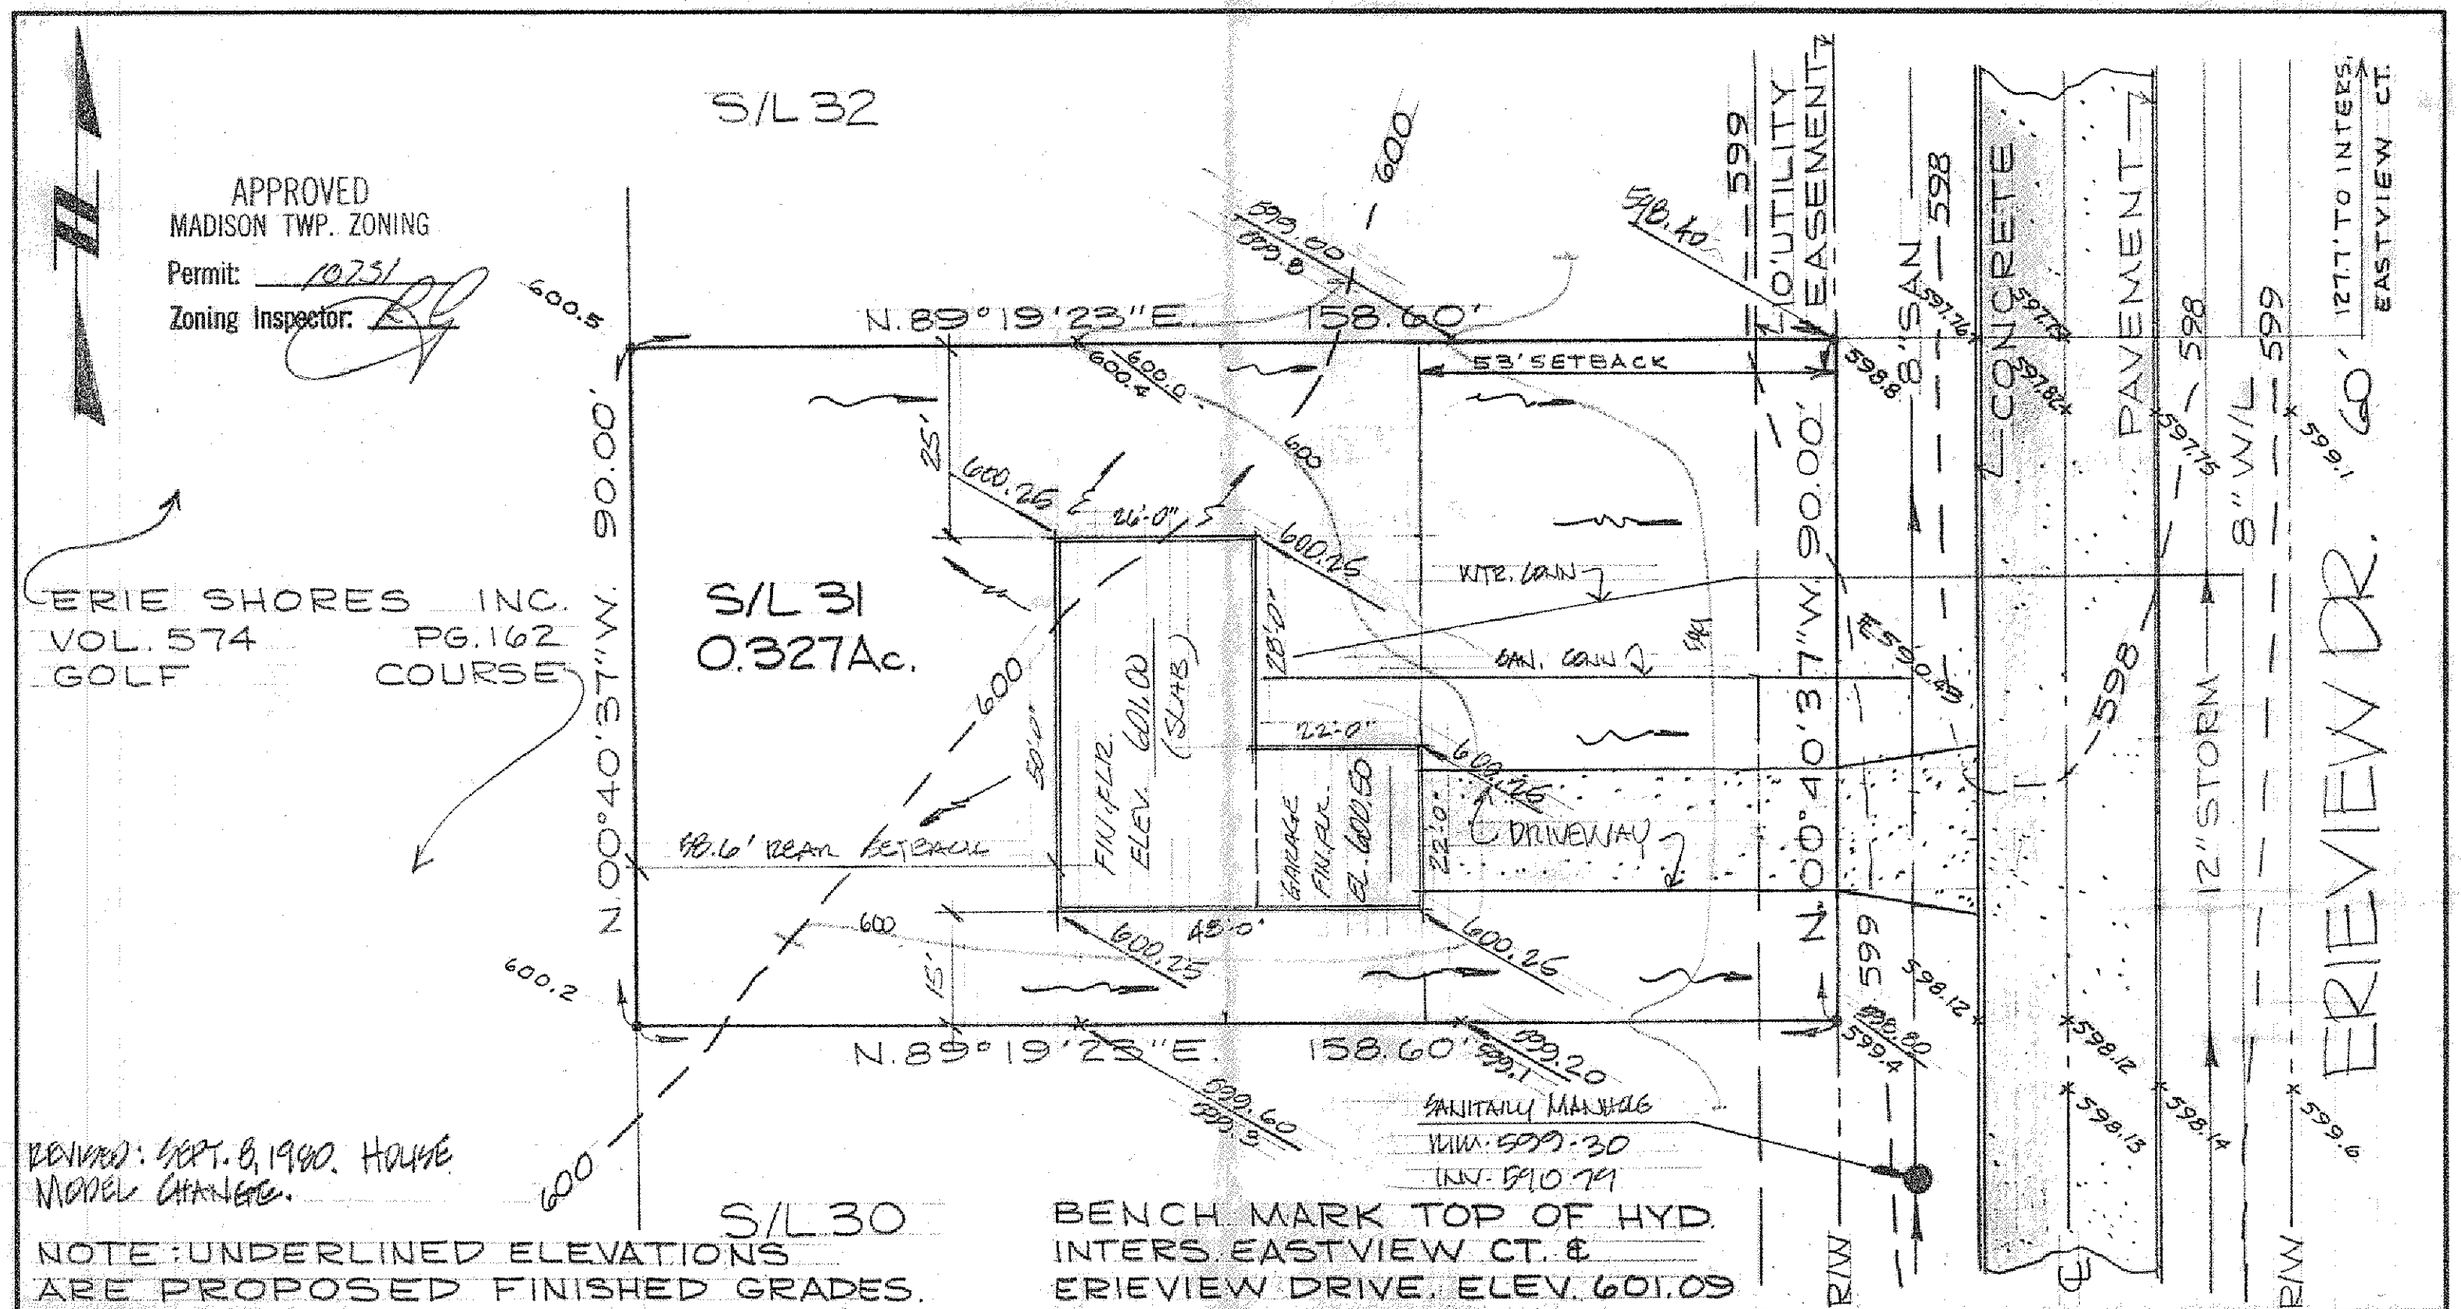

REVISED: SEPT. 8, 1980. HOUSE MODEL CHANGE.

NOTE: UNDERLINED ELEVATIONS ARE PROPOSED FINISHED GRADES.

DESIGN CERTIFICATION	AS BUILT CERTIFICATION			
THIS PLAT WAS PREPARED BY ME, AND IS CORRECT TO THE BEST OF MY KNOWLEDGE AND BELIEF.	I HEREBY CERTIFY THAT THE CIRCLED GRADES ARE EXISTING FINISH GRADES CHECKED IN THE FIELD ON _____ AND THAT SURVEY IS CORRECT TO THE BEST OF MY KNOWLEDGE AND BELIEF.	COLPETZER · WOODS CONSULTANTS, INC.	DATE 5/30/79 SCALE 1" = 20' DRWN BY J.E. CHKD BY JOB NO. 78/107 FB #361 PG 78	SITE PLAN FOR NEFF-FAUVER INC. BEING S/L NO. 31 IN ERIEVIEW ESTATES SUBDIVISION MADISON TWP. LAKE COUNTY, O
REG. SURVEYOR NO. 4785	REG. SURVEYOR NO. _____			

S/L 31

MICP 12/27/79