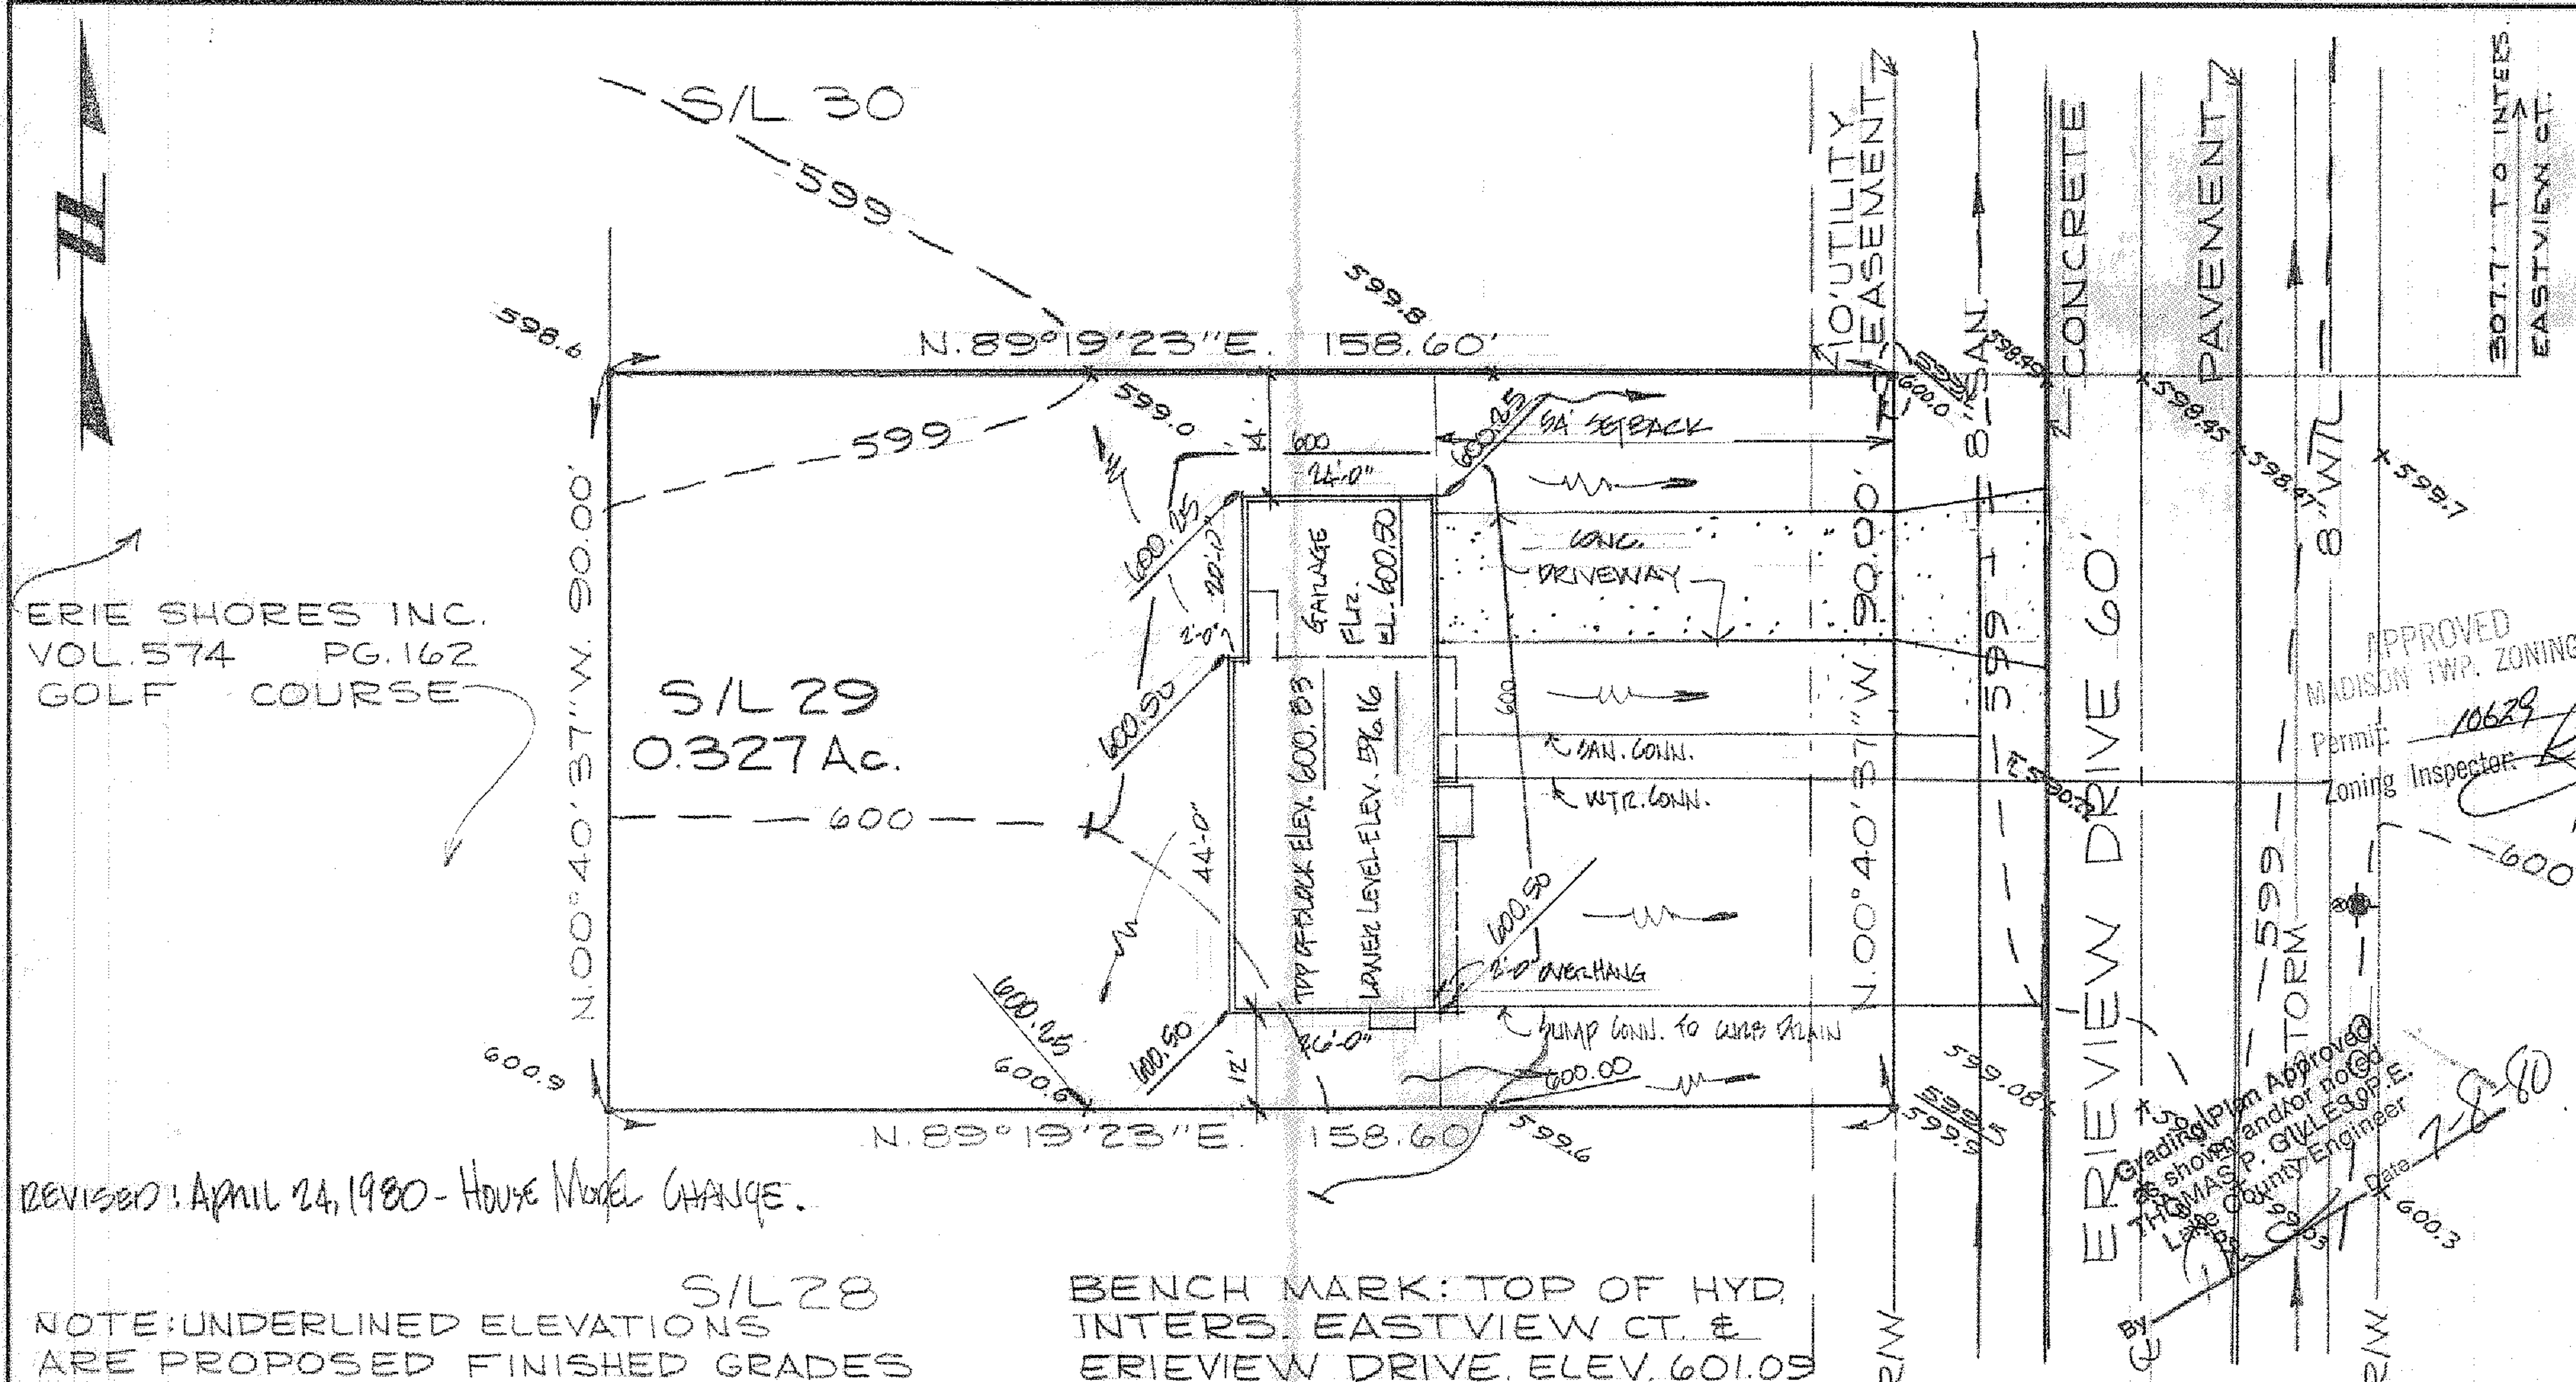

REVISED: APRIL 24, 1980 - HOUSE MODEL CHANGE.

NOTE: UNDERLINED ELEVATIONS ARE PROPOSED FINISHED GRADES

BENCH MARK: TOP OF HYD. INTERS. EASTVIEW CT. & ERIEVIEW DRIVE. ELEV. 601.05

DESIGN CERTIFICATION	AS BUILT CERTIFICATION			
THIS PLAT WAS PREPARED BY ME, AND IS CORRECT TO THE BEST OF MY KNOWLEDGE AND BELIEF. [signature] REG. SURVEYOR NO. 4785	I HEREBY CERTIFY THAT THE CIRCLED GRADES ARE EXISTING FINISH GRADES CHECKED IN THE FIELD ON ____ AND THAT SURVEY IS CORRECT TO THE BEST OF MY KNOWLEDGE AND BELIEF. REG. SURVEYOR NO. ____	**COLPETZER · WOODS** CONSULTANTS, INC.	DATE 5/30/79 SCALE 1" = 20' DRWN BY D.E. CHKD BY ____ JOB NO 78/107 FB #361 PG 78	SITE PLAN FOR NEFF-FAUVER INC. BEING S/L NO. 29 IN ERIEVIEW ESTATES SUBDIVISION MADISON TWP. LAKE COUNTY, O.

S/L 29

MICF 12/27/79