FOR
PAUL RODIO
BEING A PART OF LOT NO. 4, TRACT NO. 6, IN THE TOWNSHIP OF MADISON, LAKE COUNTY, OHIO.

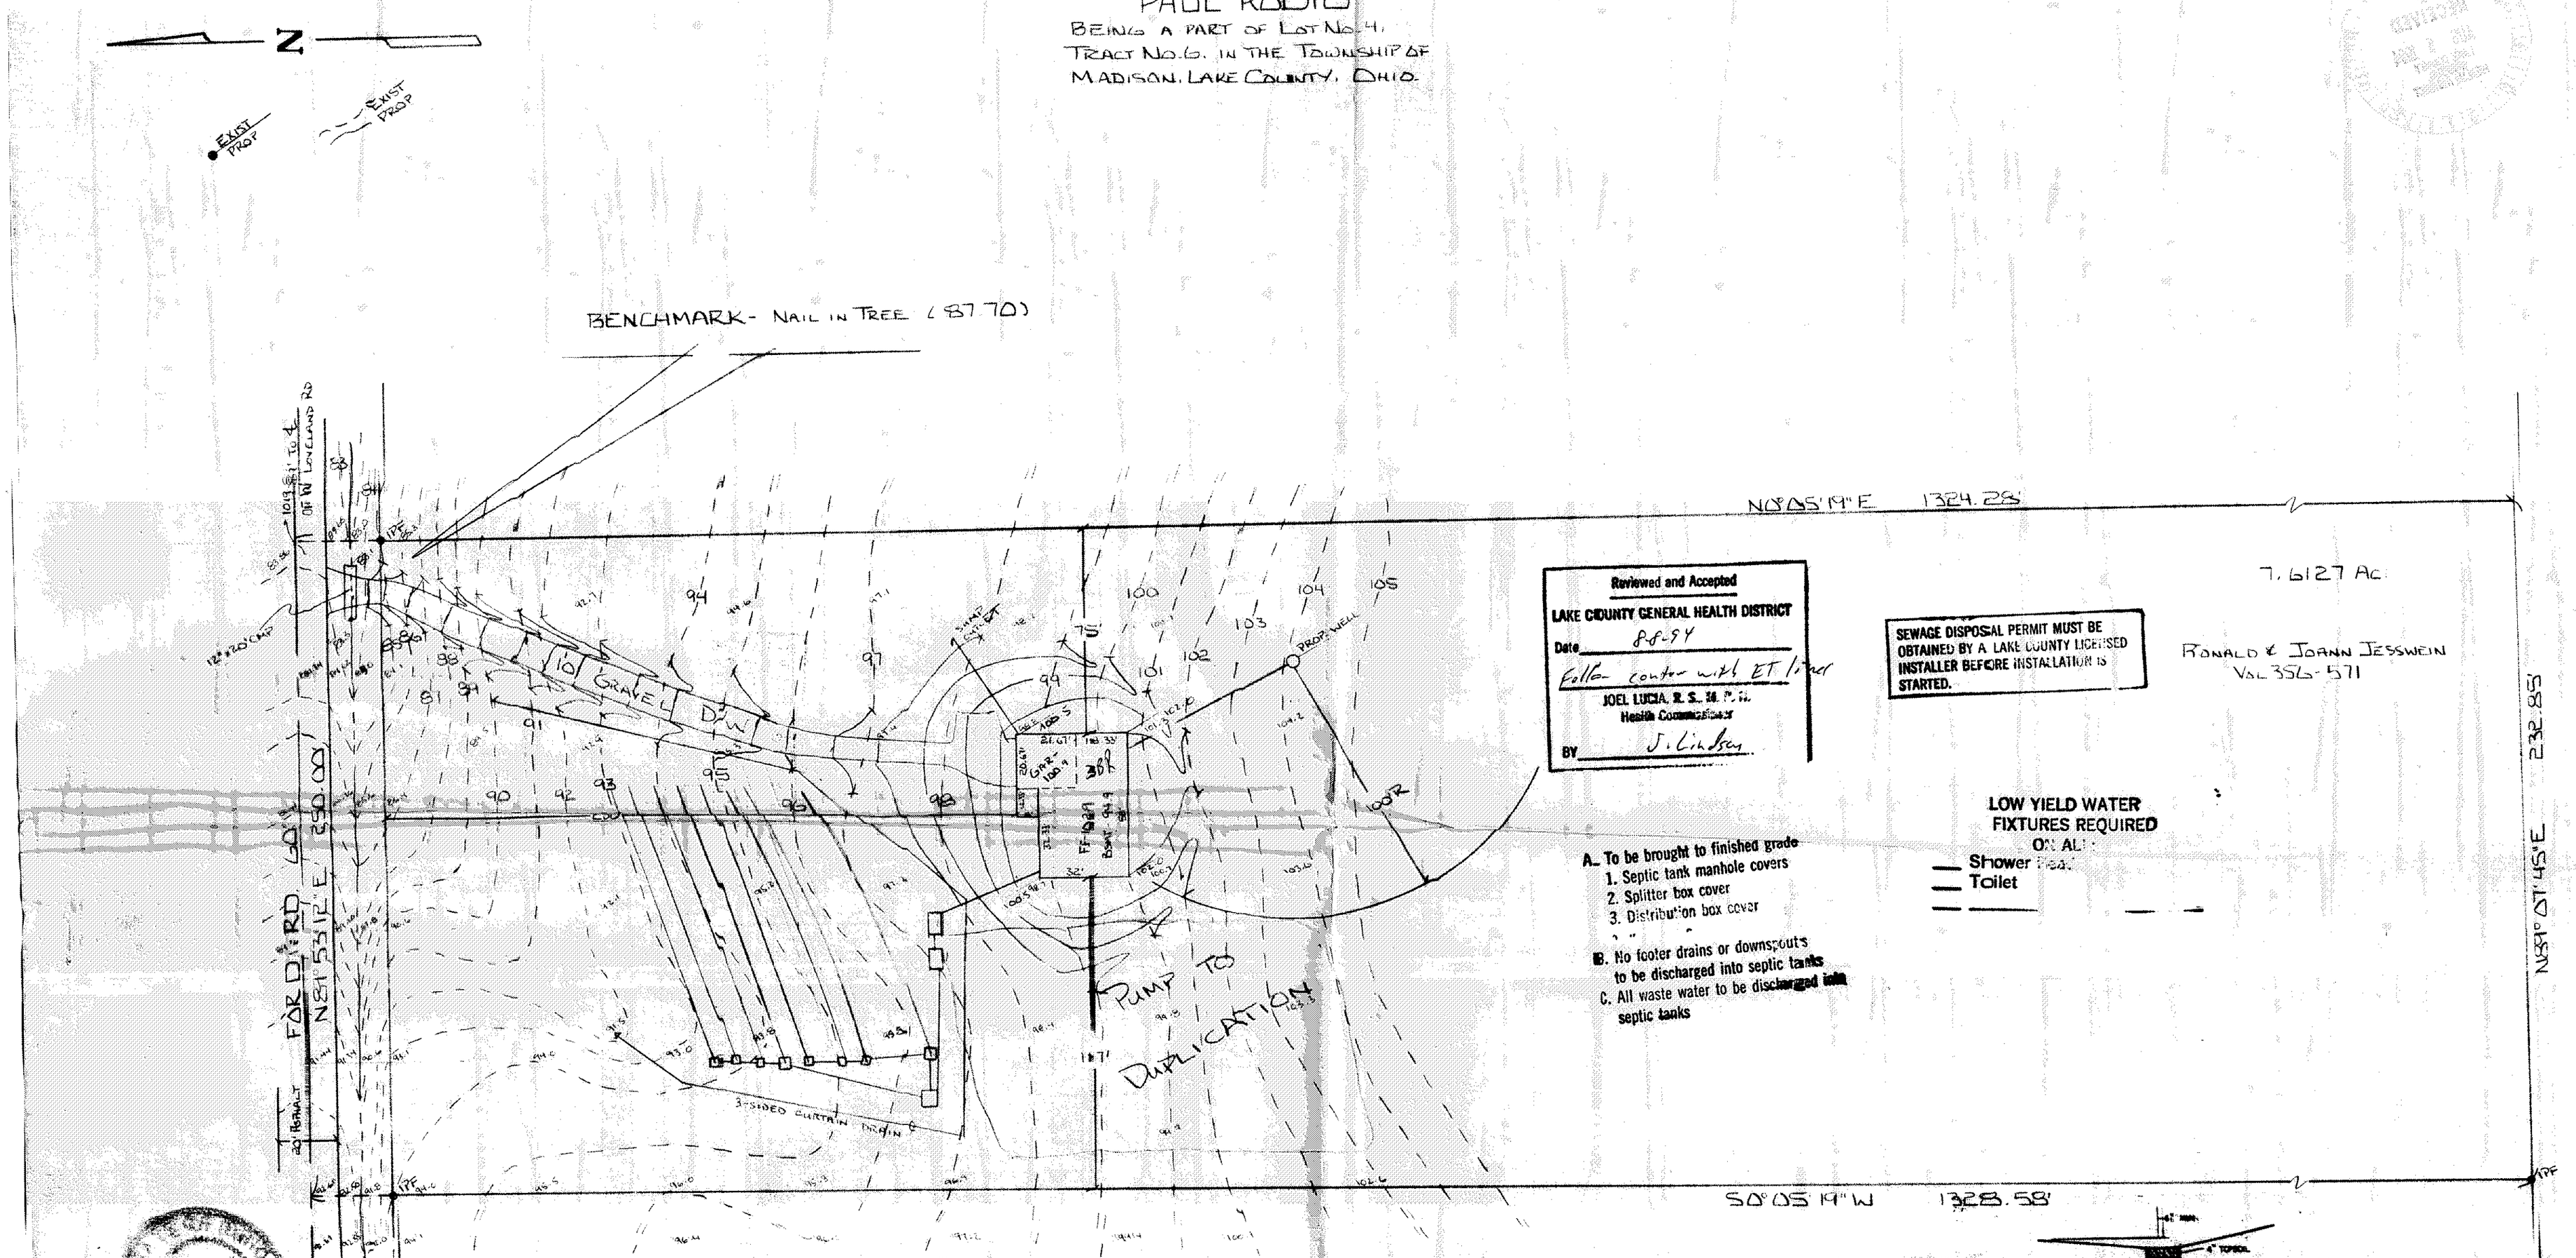

Reviewed and Accepted
LAKE COUNTY GENERAL HEALTH DISTRICT
Date 8-8-94
Follow contour with ET liner
JOEL LUCIA, R. S., M. P. H.
Health Commissioner
BY J. Lindsey

SEWAGE DISPOSAL PERMIT MUST BE OBTAINED BY A LAKE COUNTY LICENSED INSTALLER BEFORE INSTALLATION IS STARTED.

LOW YIELD WATER FIXTURES REQUIRED ON ALL:
___ Shower Head
___ Toilet

A. To be brought to finished grade
1. Septic tank manhole covers
2. Splitter box cover
3. Distribution box cover

B. No footer drains or downspouts to be discharged into septic tanks
C. All waste water to be discharged into septic tanks

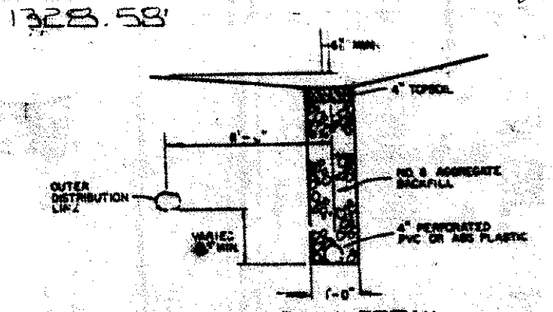

CURTAIN DRAIN DETAIL

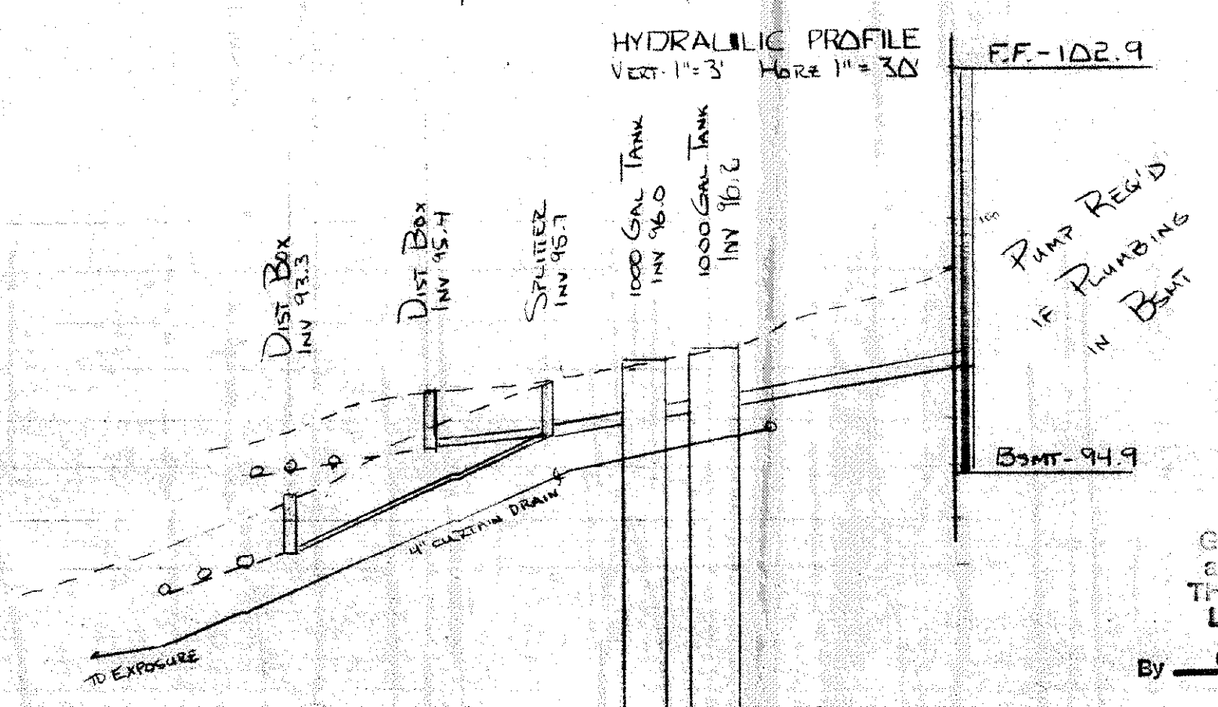

 
EVAPORATION-TRANSPIRATION TRENCH DETAIL

I, the undersigned hereby certify that this topography, indicated by 1' contours, and elevations shown hereon represent an actual field survey made by me on July 18, 1994 and that the elevations were taken at appropriate intervals and that as of that date they existed as indicated hereon.

THOMAS MARK COFFMAN 6857 REGISTERED SURVEYOR
Aug. 3, 1994

VILLAGE SURVEYING Co.
P.O. Box 1096, Fairport Hbr., Oh 44077
(216) 357-1359

Grading Plan Approved as shown and/or noted
THOMAS P. GILLES, P.E.
Lake County Engineer
By GJH Date 8/1/94

APPROVED
MADISON TWP. ZONING
Permit 14265
Zoning Inspector
AUG. 04 1994